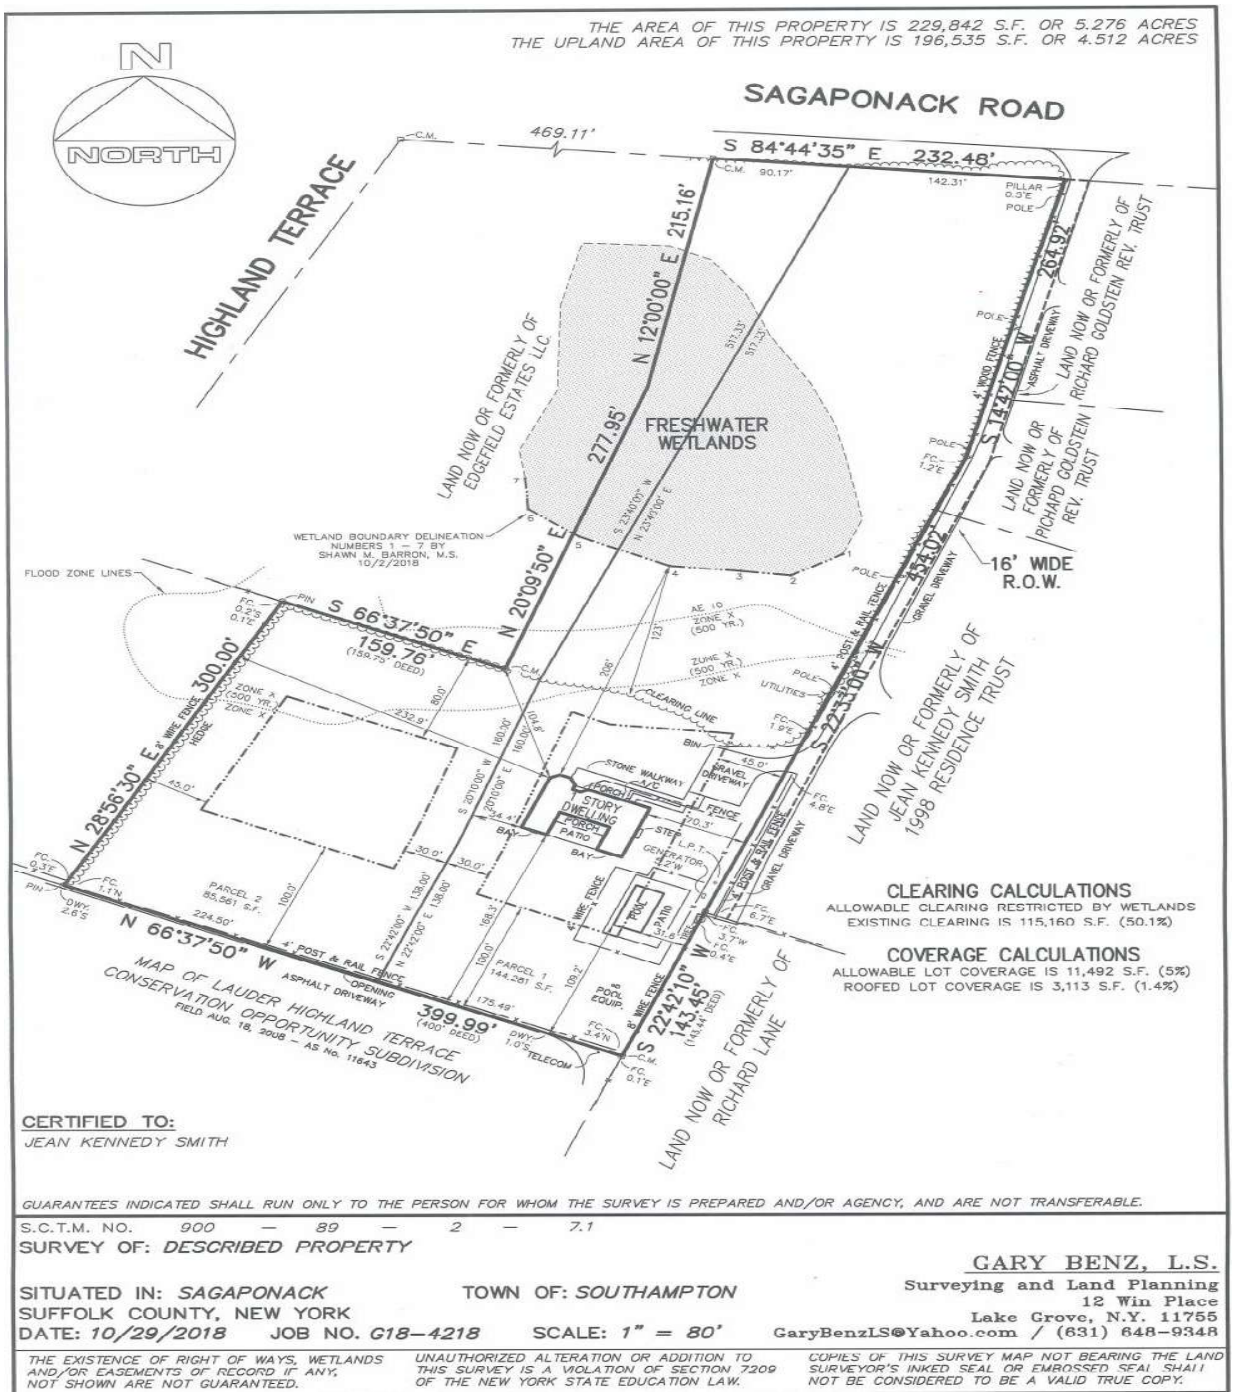Subject Survey