

**MAP OF LOT 3; BLOCK 1018
SUBDIVISION NO. 5**

MONTAUK BEACH DEVELOPMENT CORP.
SHEPHERD NECK SECTION
FILED MAY 6, 1927 AS MAP NO. 1015


SITUATE

**MONTAUK, TOWN OF EAST HAMPTON
SUFFOLK COUNTY, N.Y.**

SCALE: 1" = 30'
TAX MAP REF: 0300-48-04-29
LOT AREA: 16,051.90 SQ FT
OR 0.37 ACRE

LOT AREA	16,051.90 SQ FT
LOT COVERAGE	
PERMITTED:	3,210 SQ FT 20%
EXISTING:	1,028 SQ FT
PROPOSED:	N/A
TOTAL LOT COVERAGE	
PERMITTED:	8,025 SQ FT 50%
EXISTING:	2,216 SQ FT
PROPOSED:	N/A
CLEARING PERMITTED:	
12,038 SQ FT 75% OR N.R.S.P.	
EXISTING:	13,408 SQ FT
PROPOSED:	N/A

**CERTIFIED TO:
LORETTA SKAGERBERG MENZ**

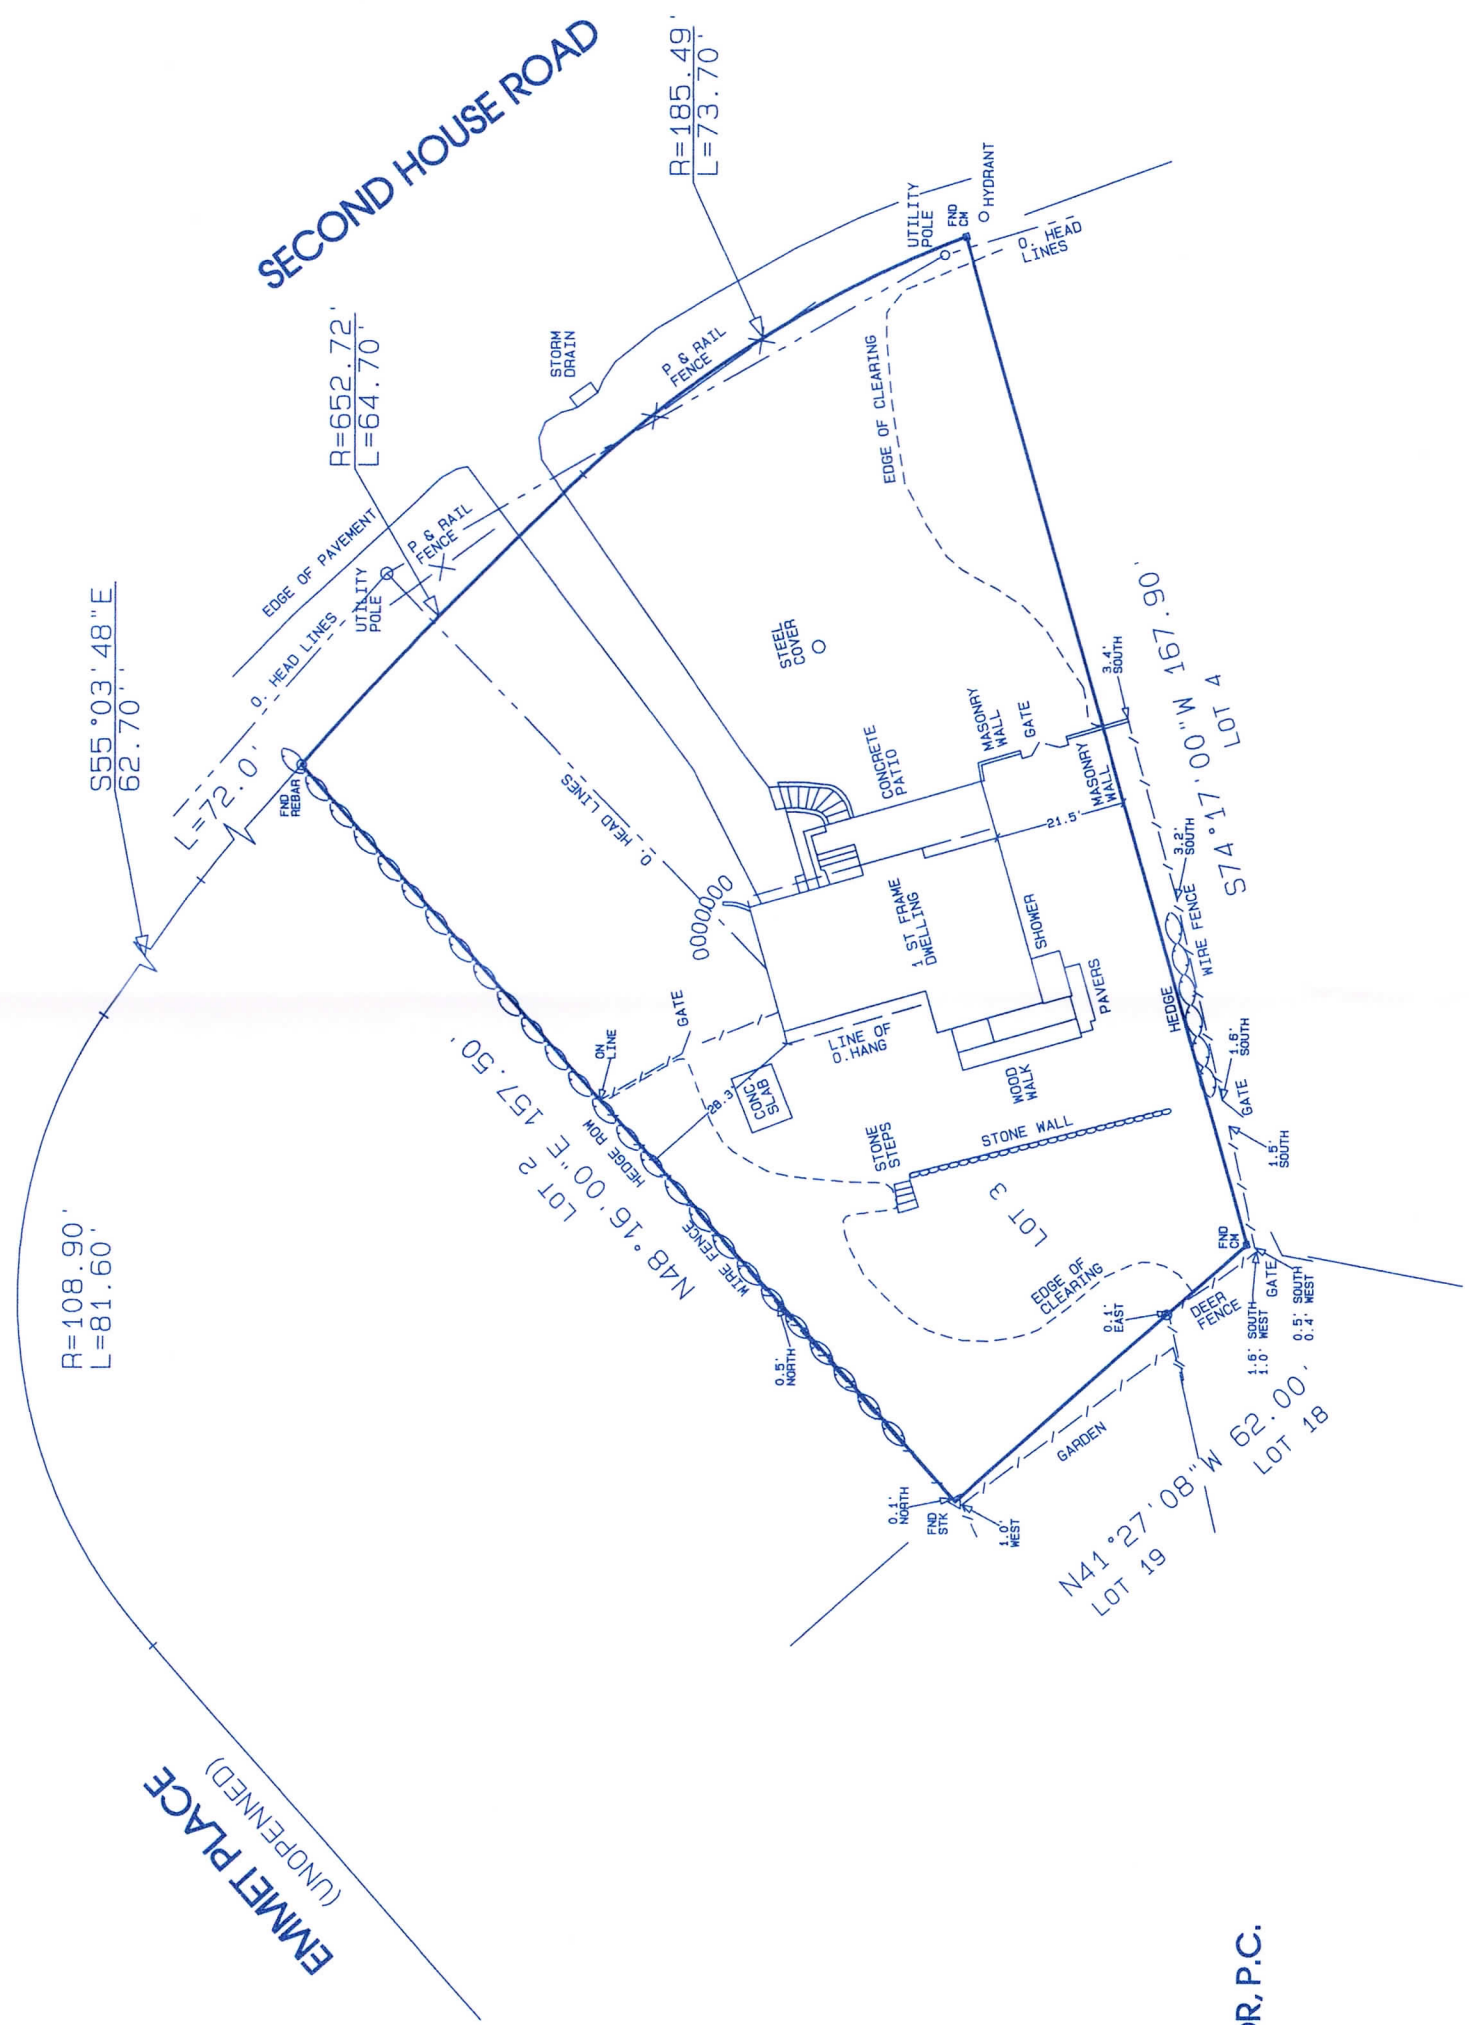

**SURVEYED JULY 17, 2024
JAMES P. WALSH LAND SURVEYOR, P.C.
MONTAUK, N.Y.**

Unauthorized alteration or addition to this survey is a violation of section 1209 of the New York State Education Law. Copies of this survey map not bearing the land surveyor's inked seal or embossed seal shall not be considered to be a valid copy. Guarantees or certifications indicated hereon shall run only to the person for whom the survey is prepared and on his behalf to the title company, government agency and lending institution. Guarantees or certifications are not transferable to additional institutions or subsequent owners.

EASEMENTS, RIGHT OF WAYS, UNDERGROUND UTILITIES, METLANDS, AND OR SANITARY FACILITIES NOT VISIBLE AT THE TIME OF SURVEY HAVE NOT BEEN SHOWN, LOCATED AND/OR GUARANTEED