

M 7085

624-30


146-149

MAP OF PREMISES OF

AMAGANSETT

TOWN OF EAST HAMPTON - SUFFOLK CO.
NEW YORK


Scale: 1"=30'

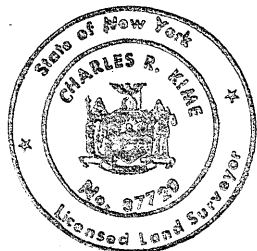

GUARANTEED TO

LANE

OAK

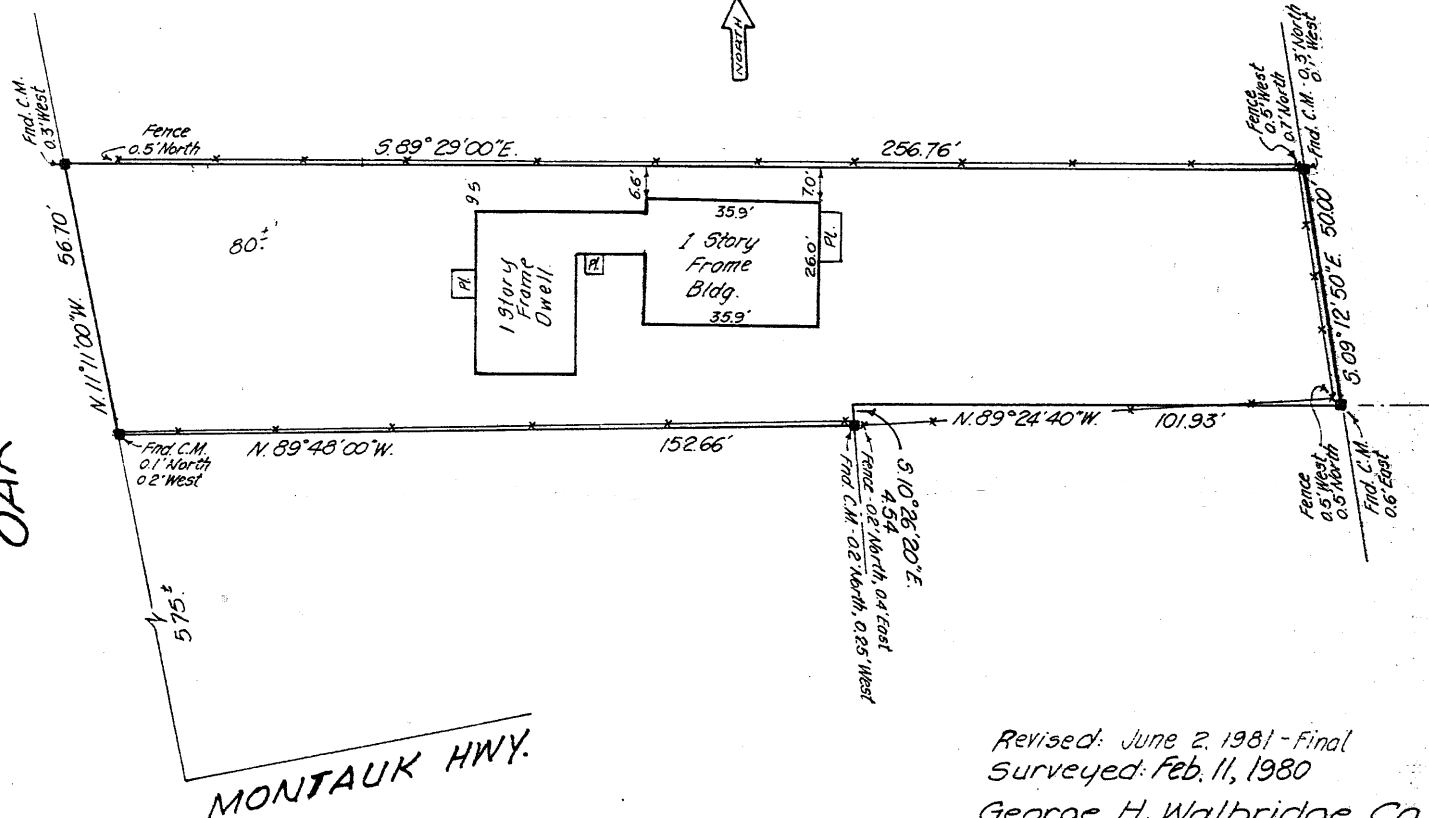Revised: June 2, 1981 - Final
Surveyed: Feb. 11, 1980

George H. Walbridge Co.

Land Surveyors & Land Planners
East Hampton - Long Island - N.Y.

T.M. C300-168-07-6