
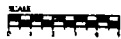


THE
CORINTHIAN
CONDOMINIUMS

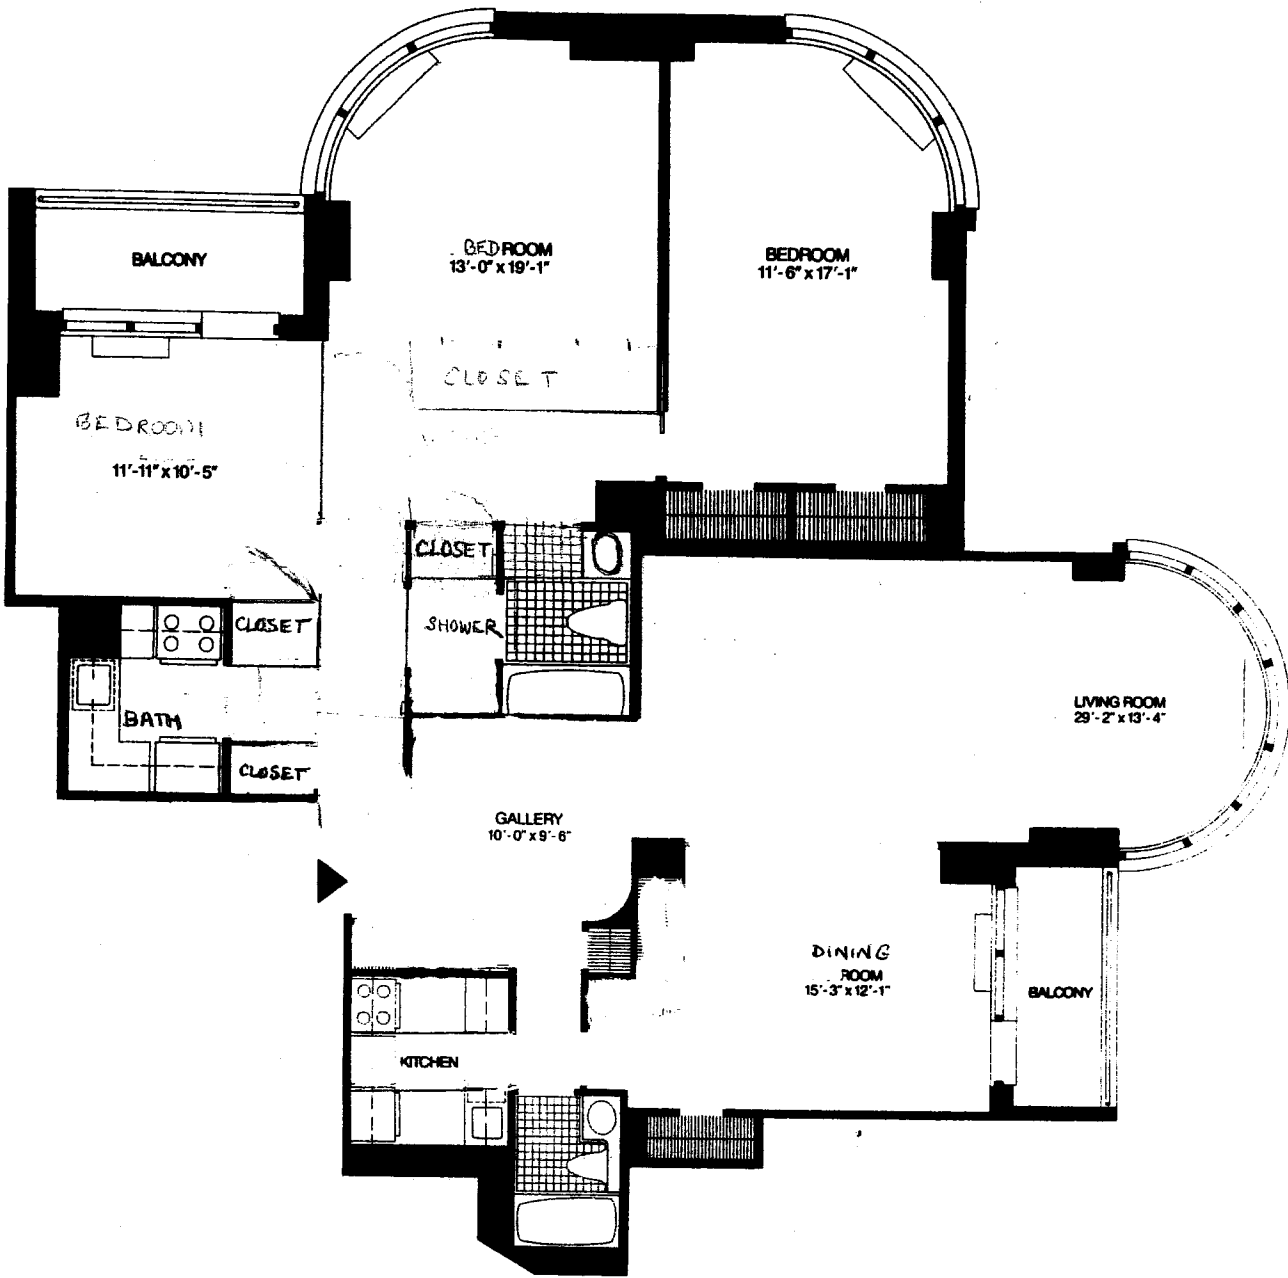

All areas and dimensions are approximate and also subject to normal construction variations and tolerances. Dimensions are maximum overall, subtract cutouts. Sponsor reserves the right to make changes in accordance with the Offering Plan.

COMBINATION IJ

153

RESIDENCE J
FLOORS 5 TO 57
1666 SQ. FT.