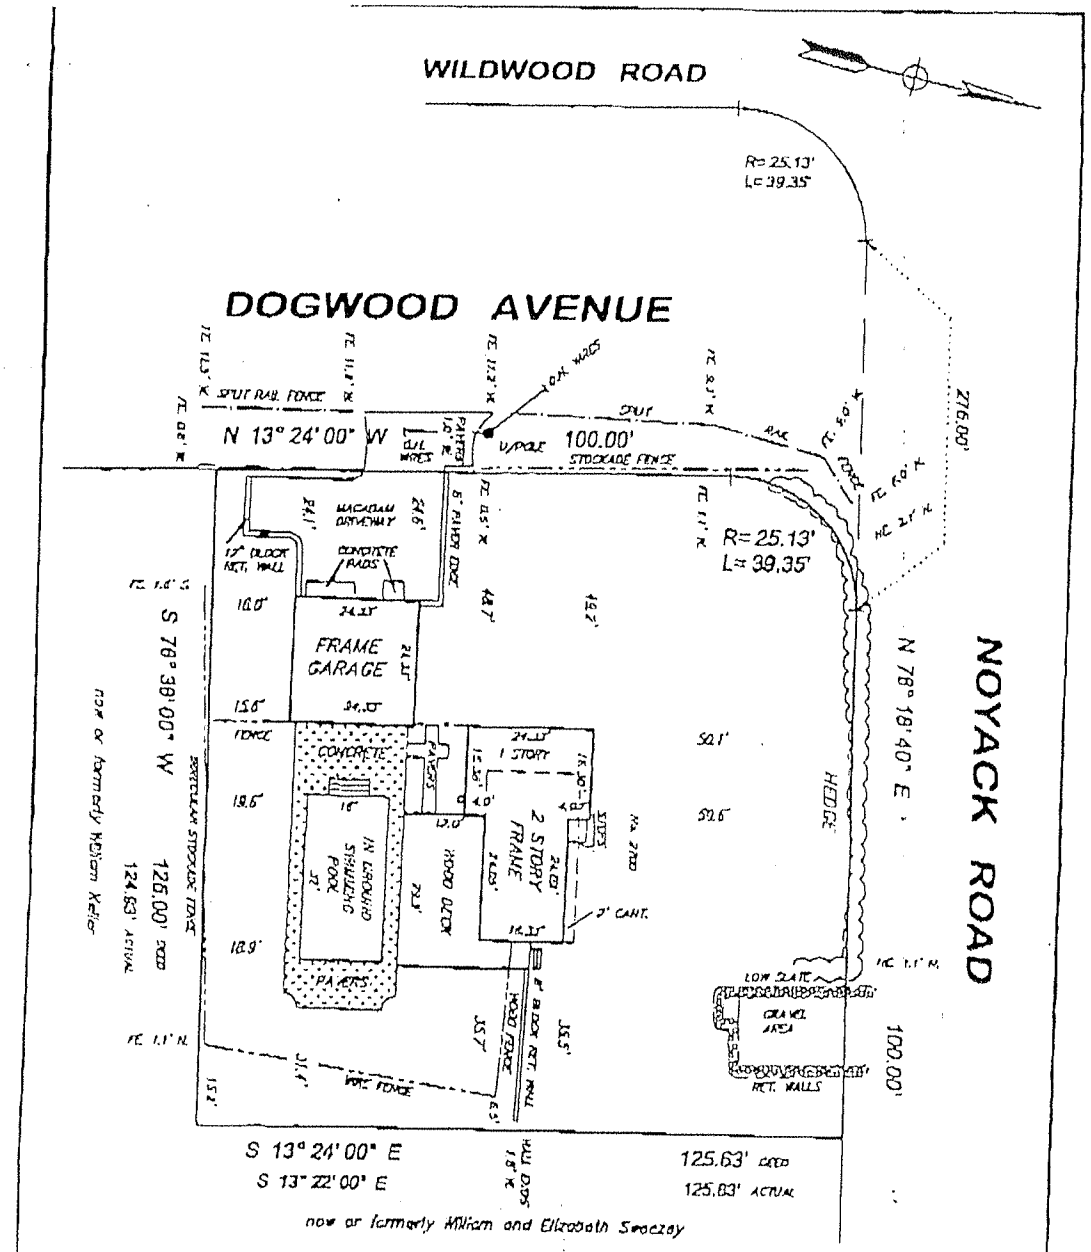

THE LOCATIONS OF RIGHT OF WAYS AND/OR EASEMENTS OF RECORD, IF ANY, NOT SHOWN ARE NOT CERTIFIED

SCALE: 1" = 20' © 2005

SURVEY OF: DESCRIPTIVE PROPERTY

FILED MAP:

LOCATED AT: SAG HARBOR, TOWN OF SOUTHAMPTON SUFFOLK COUNTY, NEW YORK

TAX DESIG.: DISTRICT 300: SEC. 12: BLK. 1: LOT 38

THOMAS MATARAZZO
LAND SURVEYOR
32 SEQUOIA WAY, HOLBROOK, NY 11741
FAX/PHONE 1-631-472-0968

CERTIFIED TO: JAMES DEVITO & ELIZABETH DEVITO
BANKERS MORTGAGE TRUST INC. its successors and/or assigns
BRIDGE ABSTRACT LLC

TITLE NO.:
DATE: APRIL 30, 2005
BY: Thomas Matarazzo

STATE OF NEW YORK
THOMAS MATARAZZO
050300
LICENSED LAND SURVEYOR