


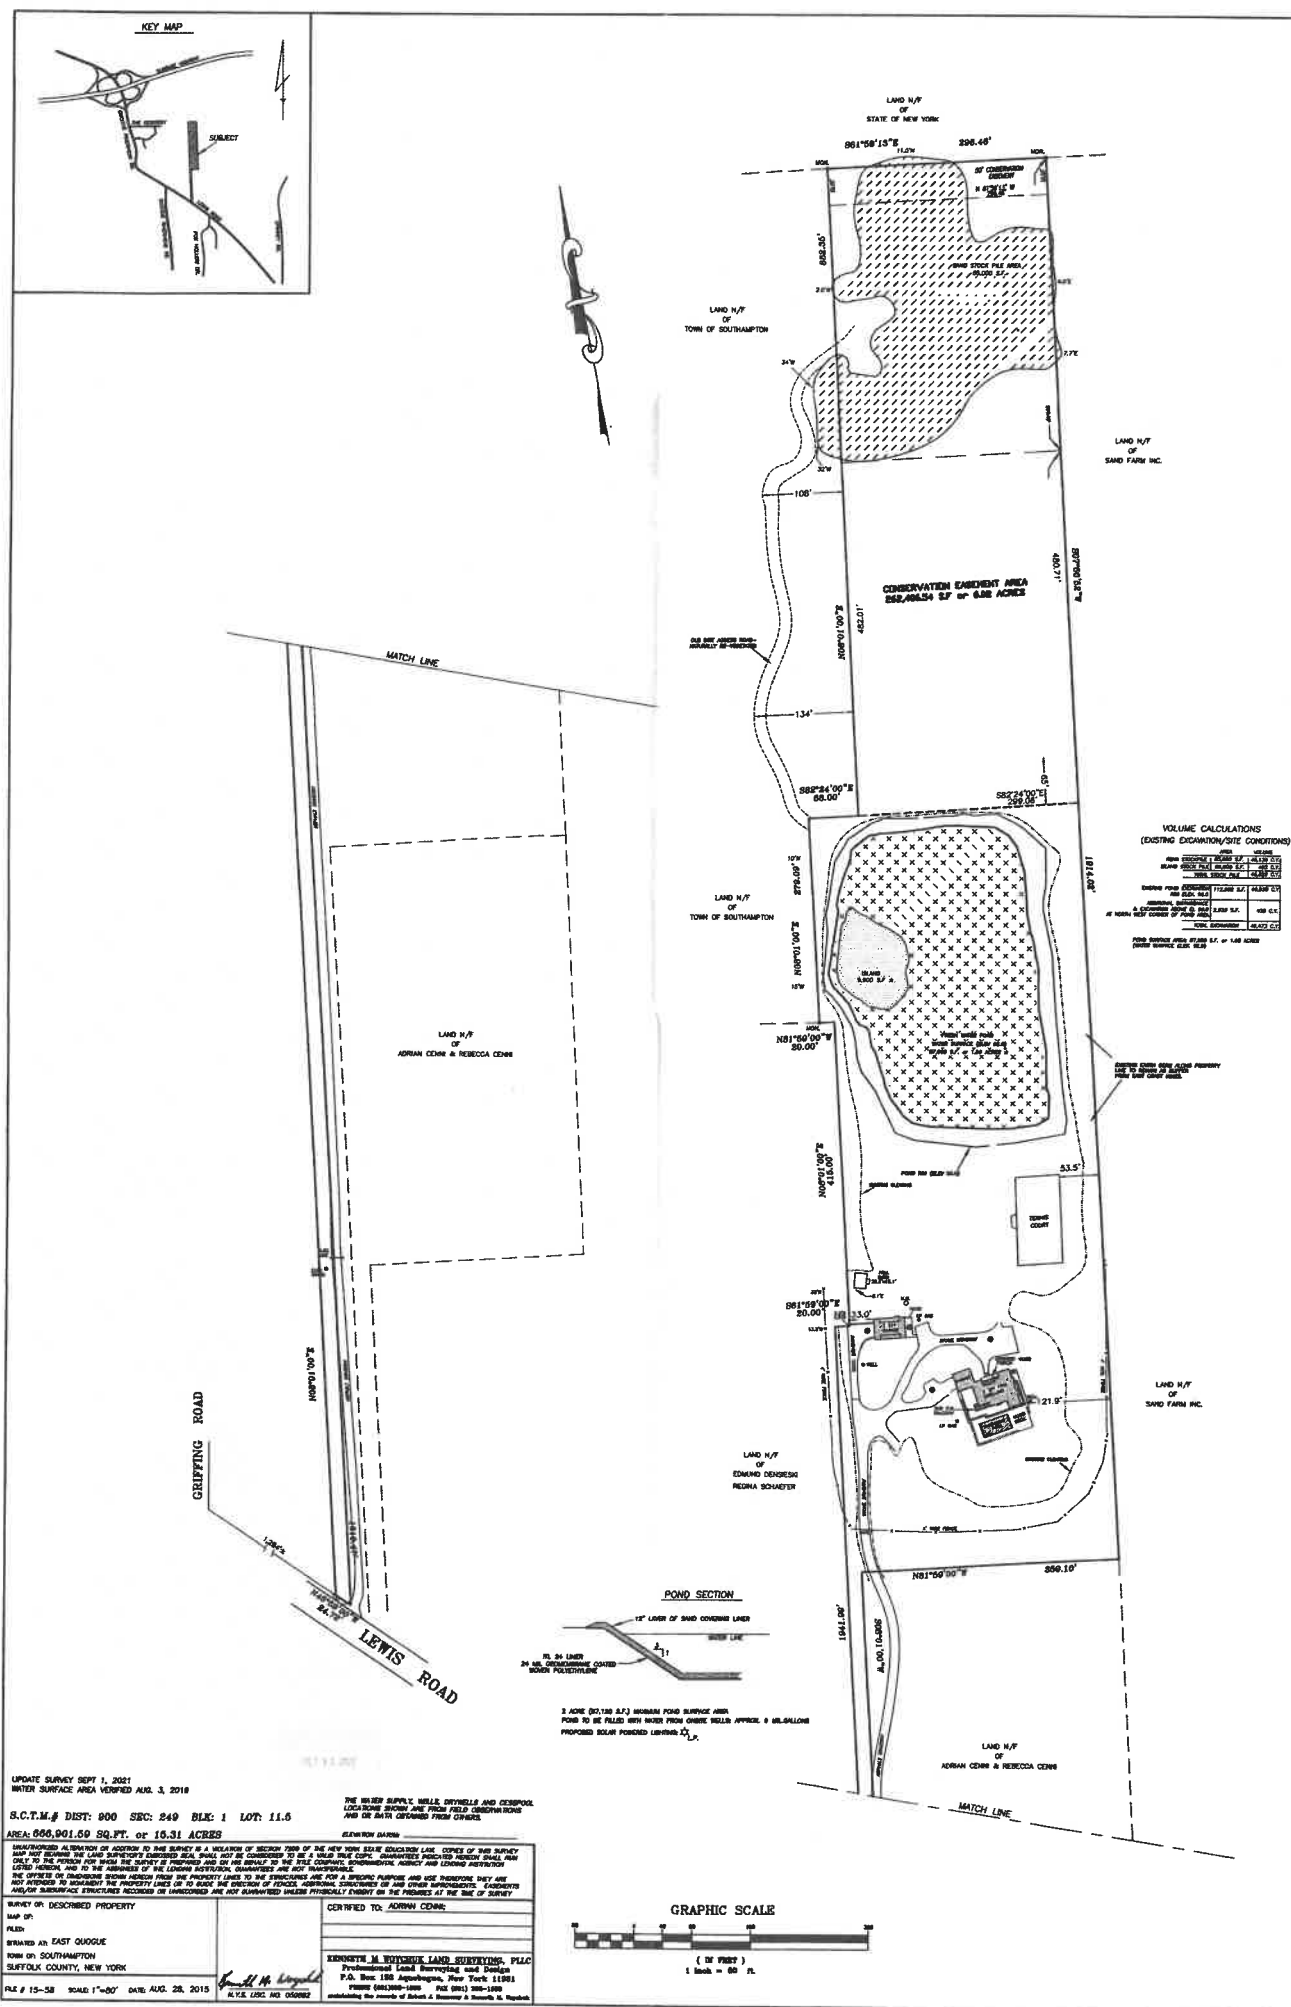


UPDATE SURVEY SEPT 1, 2021
WATER SURFACE AREA VERIFIED AUG. 3, 2018
S.C.T.M.# DIST: 900 SEC: 249 BLK: 1 LOT: 11.5



SURVEY ON DESCRIBED PROPERTY
MAP OF:
PLOT:
SUFFOLK COUNTY, NEW YORK

CERTIFIED TO: ADRIAN CENNI
Professional Land Surveying and Design

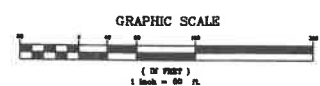

VOLUME CALCULATIONS
(EXISTING ELEVATION/SITE CONDITIONS)

