



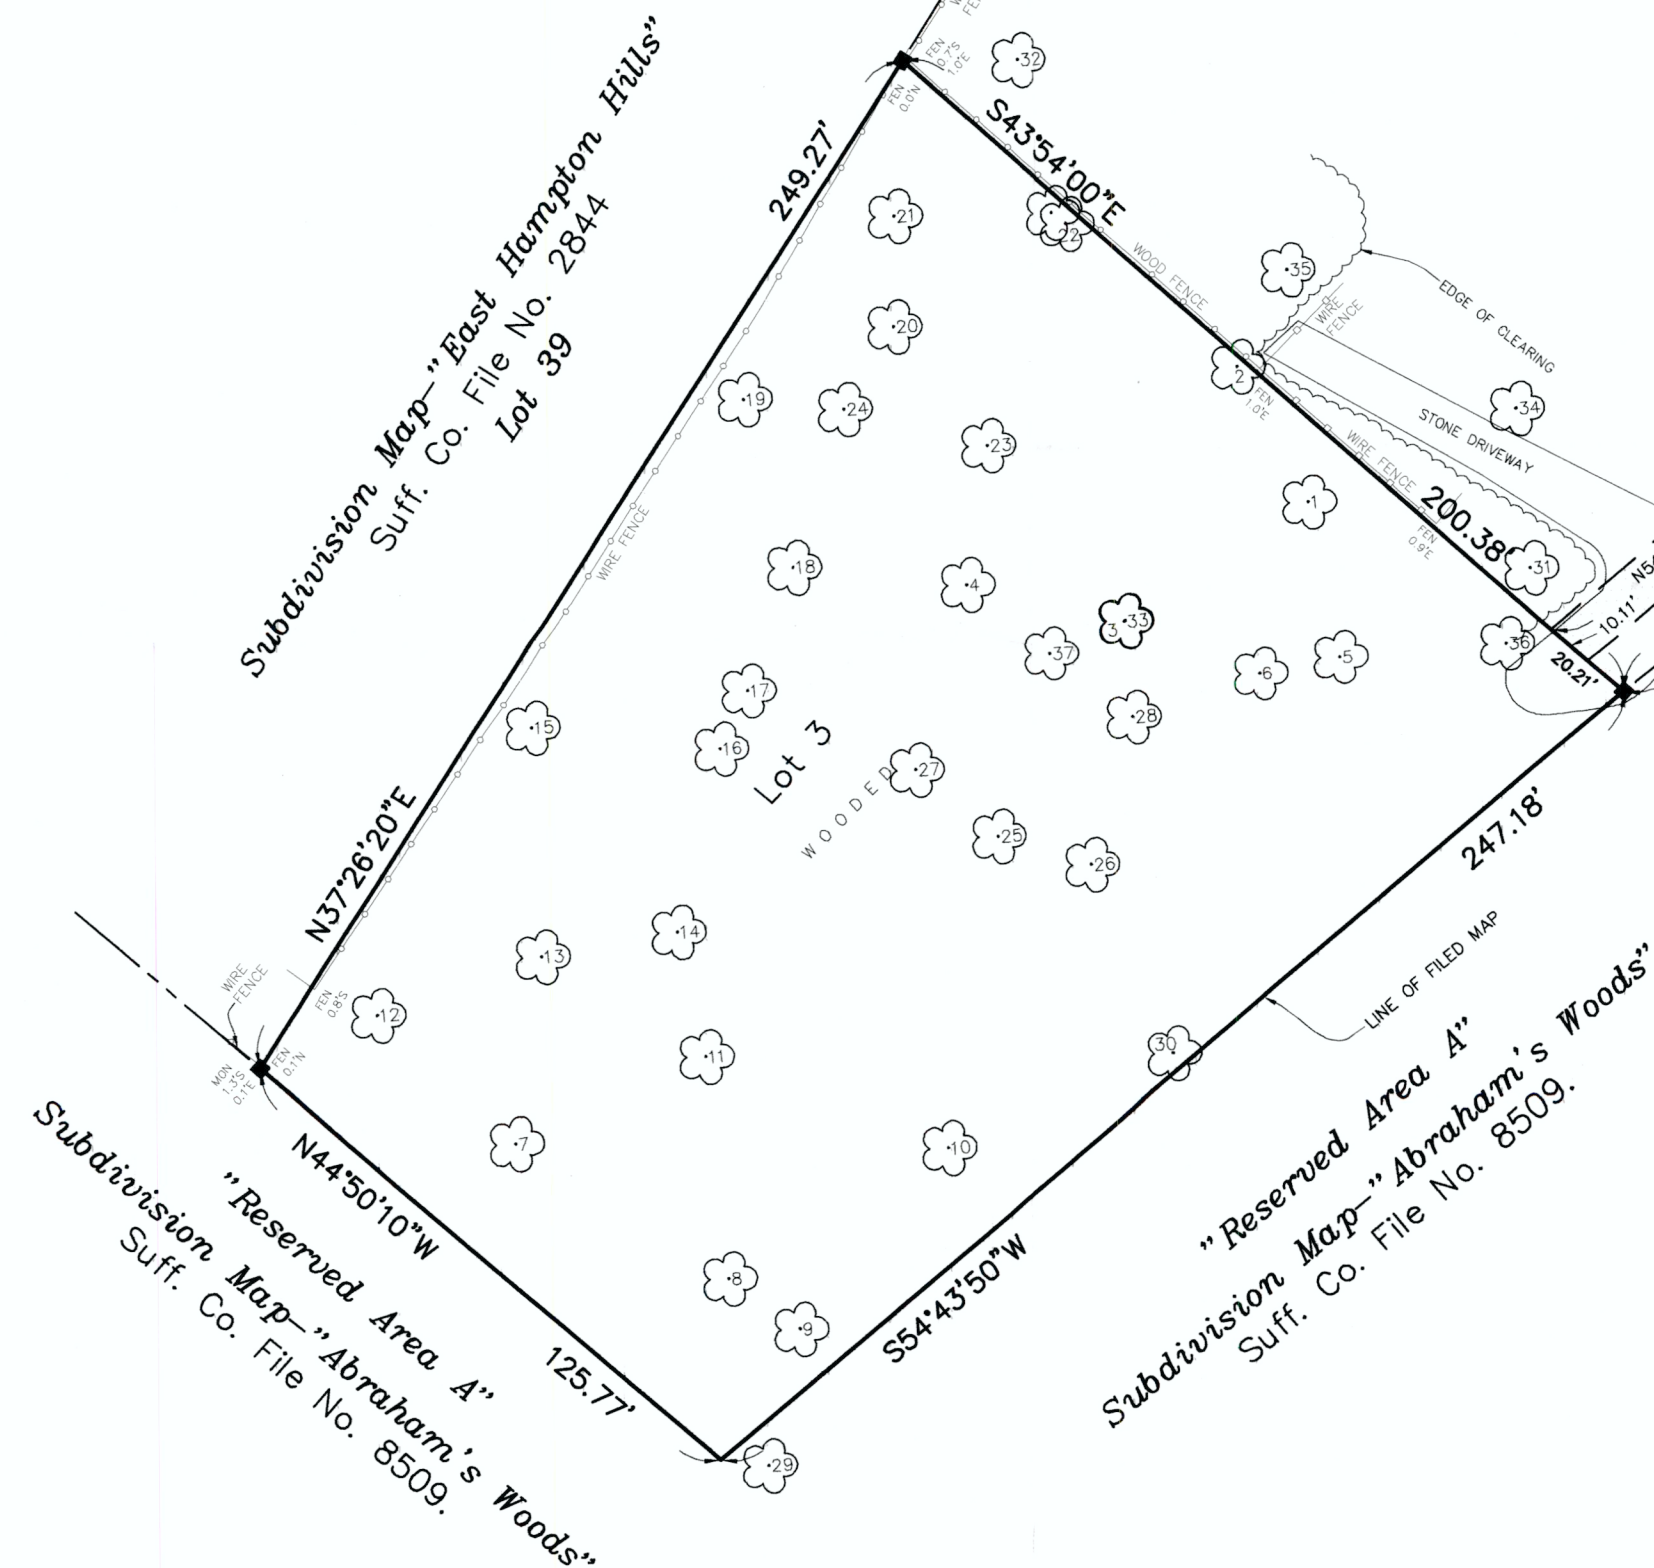

Survey for:  
**CHRISTOPHER J. GROWNEY**  
Lot 3 "Minor Subdivision Of Edwin Grifford"  
Town of  
**East Hampton**  
Suffolk County, New York  
S.C.T.M.: 0300-149.00-02.00-028.003

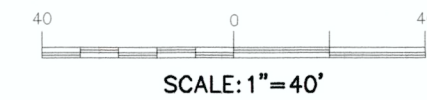

- NOTES:
1. AREA = 40,018 S.F.
  2. □ = MONUMENT SET.
  3. MINOR SUBDIVISION MAP OF "EDWIN GRIFFORD" FILED IN THE OFFICE OF THE CLERK OF SUFFOLK COUNTY ON JUNE 05, 2000 AS FILE NO. 10445.
  4. THIS PARCEL IS NOT WITHIN AN OVERLAY DISTRICT.
  5. ☼ = NUMBERED TREE

JUN 11, 2013 LOCATED TREES  
DATE: AUG. 1, 2012  
JOB NO: 2012-287

CERTIFIED TO:  
CHRISTOPHER J. GROWNEY  
FIDELITY NATIONAL TITLE INSURANCE COMPANY

STATE OF NEW YORK  
DAVID H. FOX  
50234

DAVID H. FOX, L.S. P.C. N.Y.S.L.S. #50234  
**FOX LAND SURVEYING**  
64 SUNSET AVENUE  
WESTHAMPTON BEACH, N.Y. 11978  
(631) 288-0022

UNAUTHORIZED ALTERATION OR ADDITION TO THIS SURVEY IS A VIOLATION OF SECTION 7209 OF THE NEW YORK STATE EDUCATION LAW. COPIES OF THIS SURVEY MAP NOT BEARING THE LAND SURVEYOR'S INKED SEAL OR EMBOSSED SEAL SHALL NOT BE CONSIDERED TO BE A VALID TRUE COPY.

CERTIFICATION INDICATED HEREON SHALL RUN ONLY TO THE PERSON FOR WHOM THE SURVEY IS PREPARED AND ON HIS BEHALF TO THE TITLE COMPANY, GOVERNMENTAL AGENCY AND LENDING INSTITUTION LISTED HEREON, AND TO THE ASSIGNEES OF THE LENDING INSTITUTION. CERTIFICATIONS ARE NOT TRANSFERABLE TO ADDITIONAL INSTITUTIONS OR SUBSEQUENT OWNERS.