

MAP OF PROPERTY

SITUATE

THREE MILE HARBOR


Town Of East Hampton, Suffolk Co., N.Y.

Scale: 1"=30'

Area: 22,006 S.F. or 0.505 Acres

Certified To:
John Tintle

TEST HOLE	
0.0'-1.0'	PEAT
1.0'-5.0'	SANDY LOAM
5.0'-17.0'	HARD CLAY W/ LIGHT GRAVEL
8.0'	GROUND WATER
EL. 17.0'	SAND

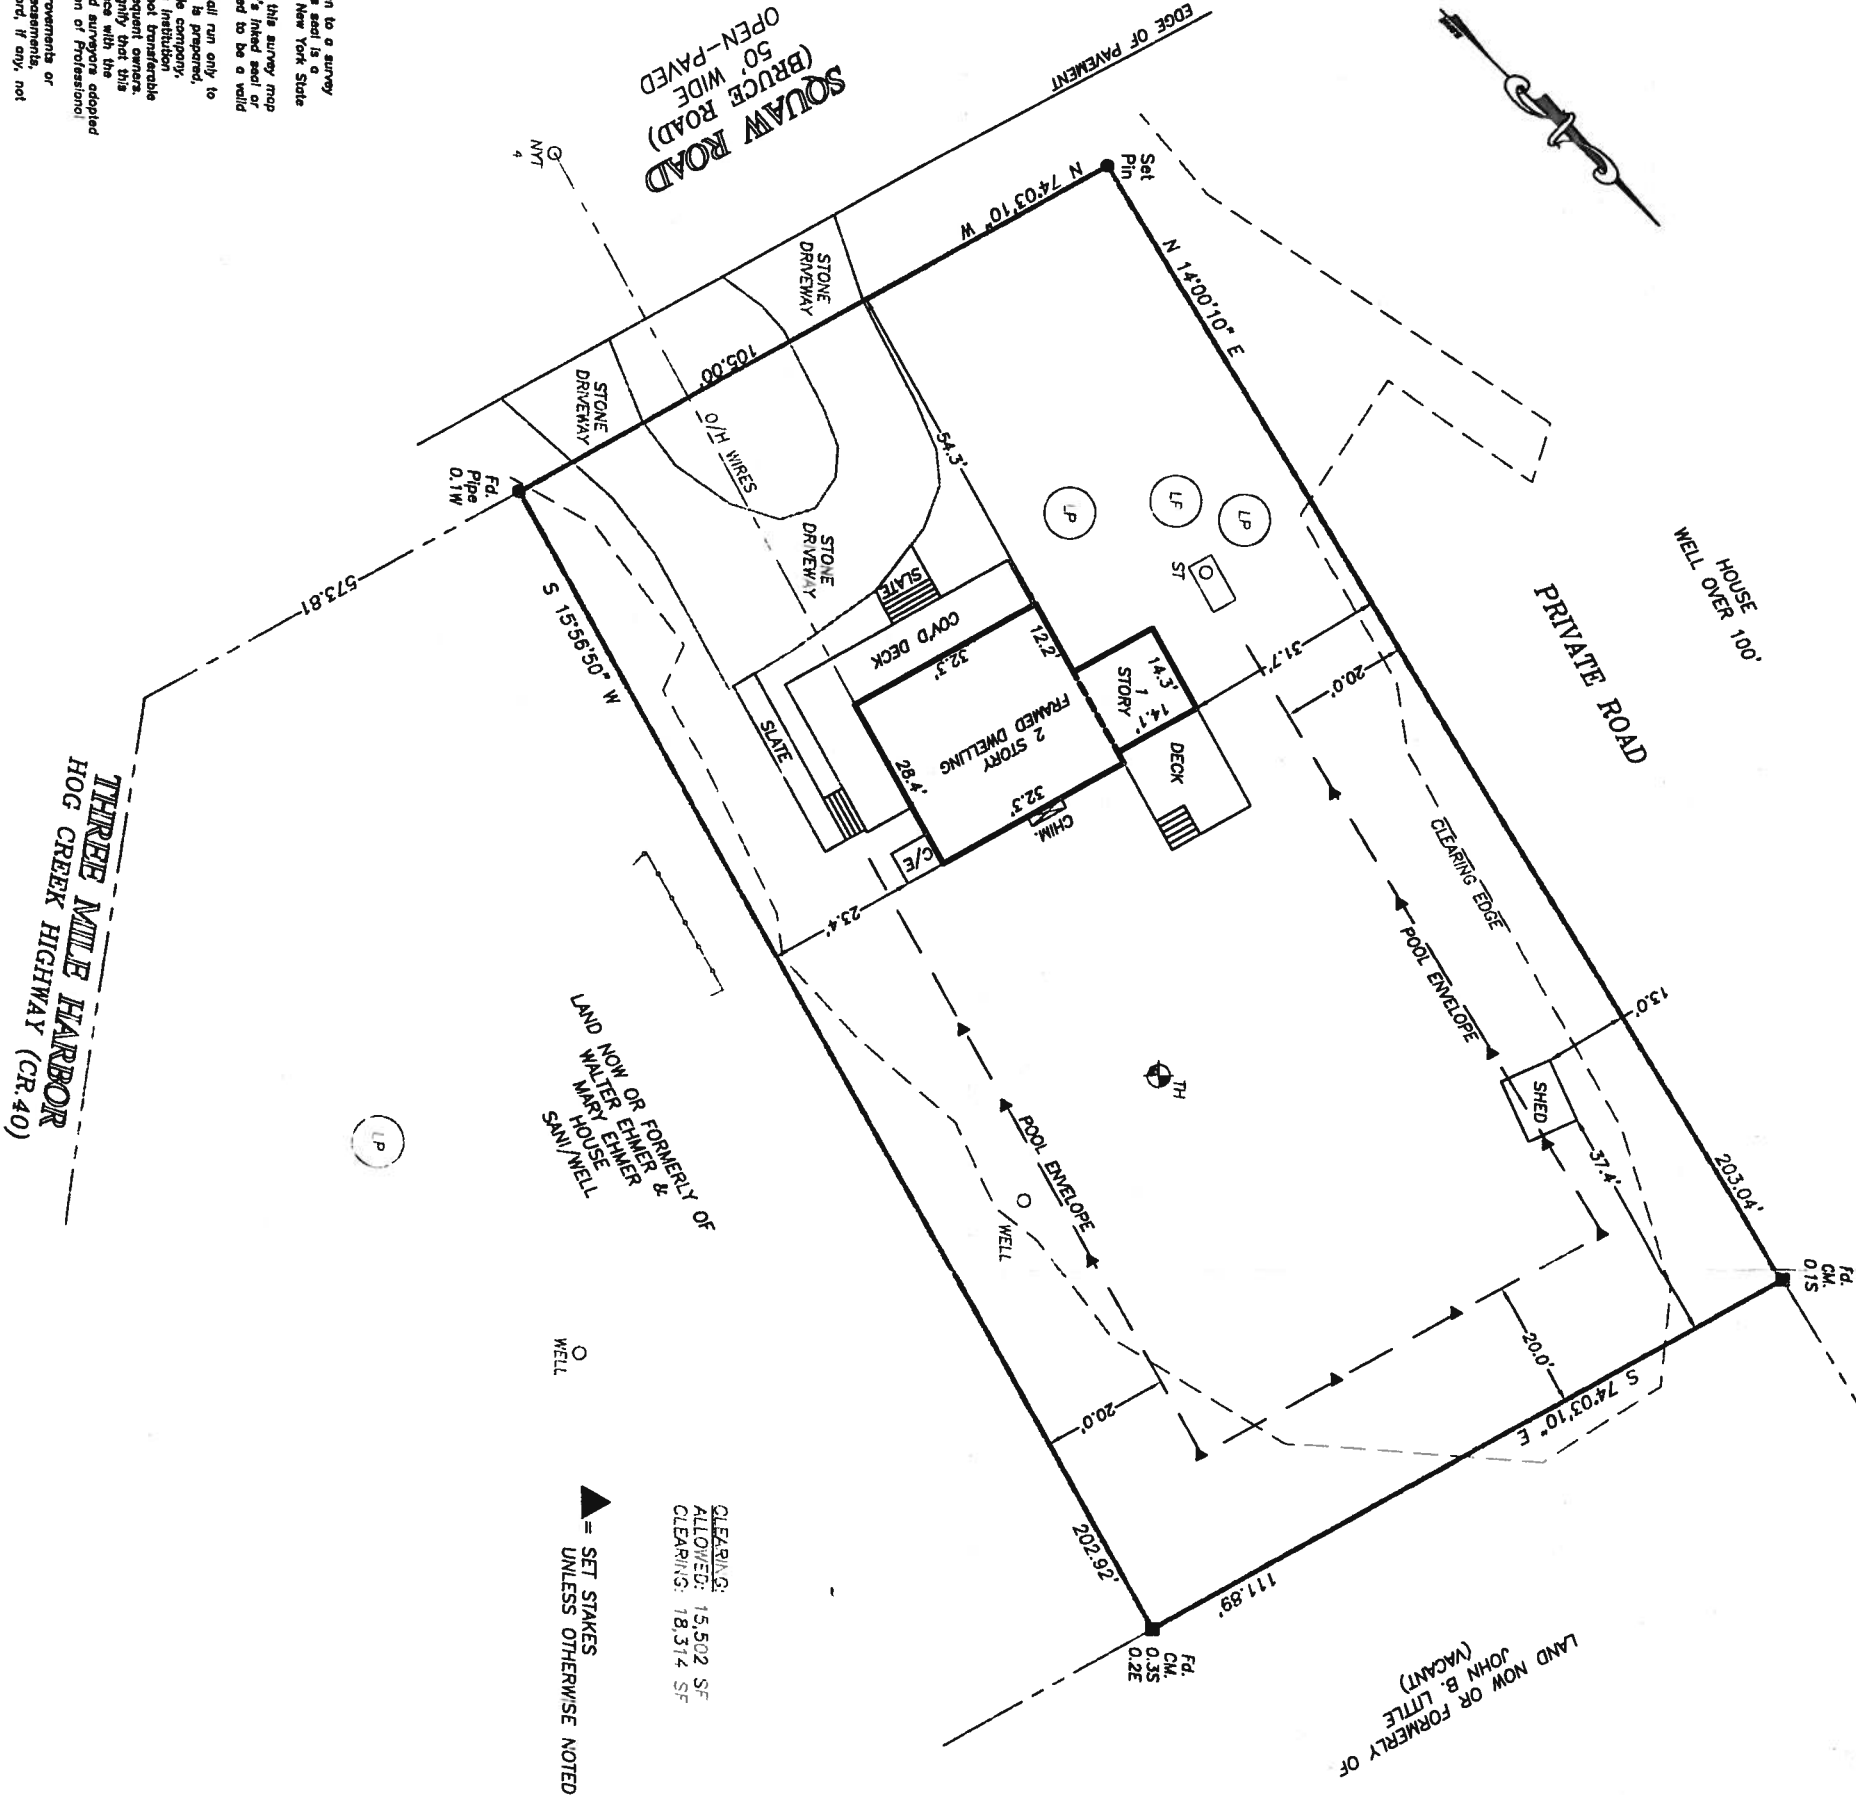

NOTE:

- 1). Unauthorized alteration or addition to a survey map bearing a licensed surveyor's seal is a violation of section 7209 of the New York State Surveying Law.
- 2). Only copies from the original of this survey map bearing an original land surveyor's filed seal or embossed seal shall be considered to be a valid copy.
- 3). Certifications indicated hereon shall run only to the person for whom the survey is prepared, and on his/her behalf to the client, company, governmental agency and lending institution.
- 4). The existence of subsurface improvements or encroachments, or wellheads, or easements, shown on this map are not certified.

DC11688

Revised: April 24, 2007 - Update, Stake Corners & Pool Env.
Surveyed: Dec. 17, 1987

GEORGE WALBRIDGE SURVEYORS, P.C.
Land Surveyors & Land Planners
300 Pentigo Place - Suite 116
East Hampton, Long Island, N.Y. 11937
Phone: (631) 324-0412 Fax: (631) 324-9849
E-mail: ehsurveyor@aol.com