




**SURVEY OF PROPERTY
AT NORTH SEA
TOWN OF SOUTHAMPTON
SUFFOLK COUNTY, N.Y.**

900-33-03-02

SCALE: 1"=40

MAY 15, 2019

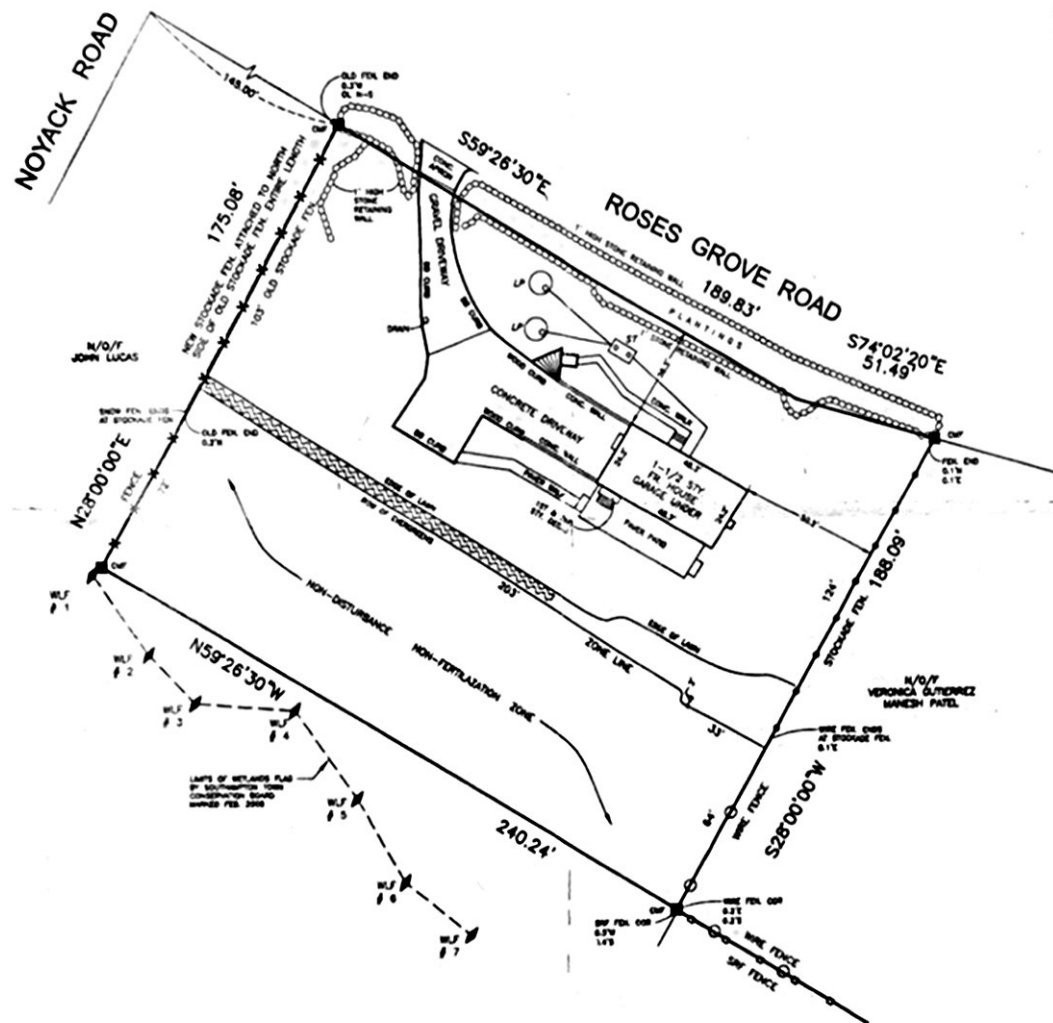


KEY

- ⊙ = REBAR
- ⊗ = WELL
- ▲ = STAKE
- ⊕ = TEST HOLE
- = PIPE
- = MONUMENT
- ◆ = WETLAND FLAG
- ⊥ = UTILITY POLE

ANY ALTERATION OR ADDITION TO THIS SURVEY IS A VIOLATION OF SECTION 7209 OF THE NEW YORK STATE EDUCATION LAW, EXCEPT AS PER SECTION 7209-SUBDIVISION 2. ALL CERTIFICATIONS HEREON ARE VALID FOR THIS MAP AND COPIES THEREOF ONLY IF SAID MAP OR COPIES BEAR THE IMPRESSED SEAL OF THE SURVEYOR WHOSE SIGNATURE APPEARS HEREON.

AREA= 42,347 SQ. FT.

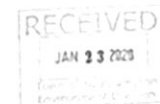

STATE OF NEW YORK, N.Y.S. LIC. NO. 49618

PECONIC SURVEYORS, P.C.
(631) 765-5020 FAX (631) 765-1797
P.O. BOX 909
1230 TRAVELER STREET
SOUTHOLD, N.Y. 11971

95-161