

JOB No. 13871 ~ A3361


SUFFOLK COUNTY
2005 JUL 14 4:10:03

SUFFOLK COUNTY TAX MAP

DISTRICT 0900
SECTION 039.00
BLOCK 01.00
PARCEL 049.035

BRICK KILN ROAD

FAIR HILLS LANE

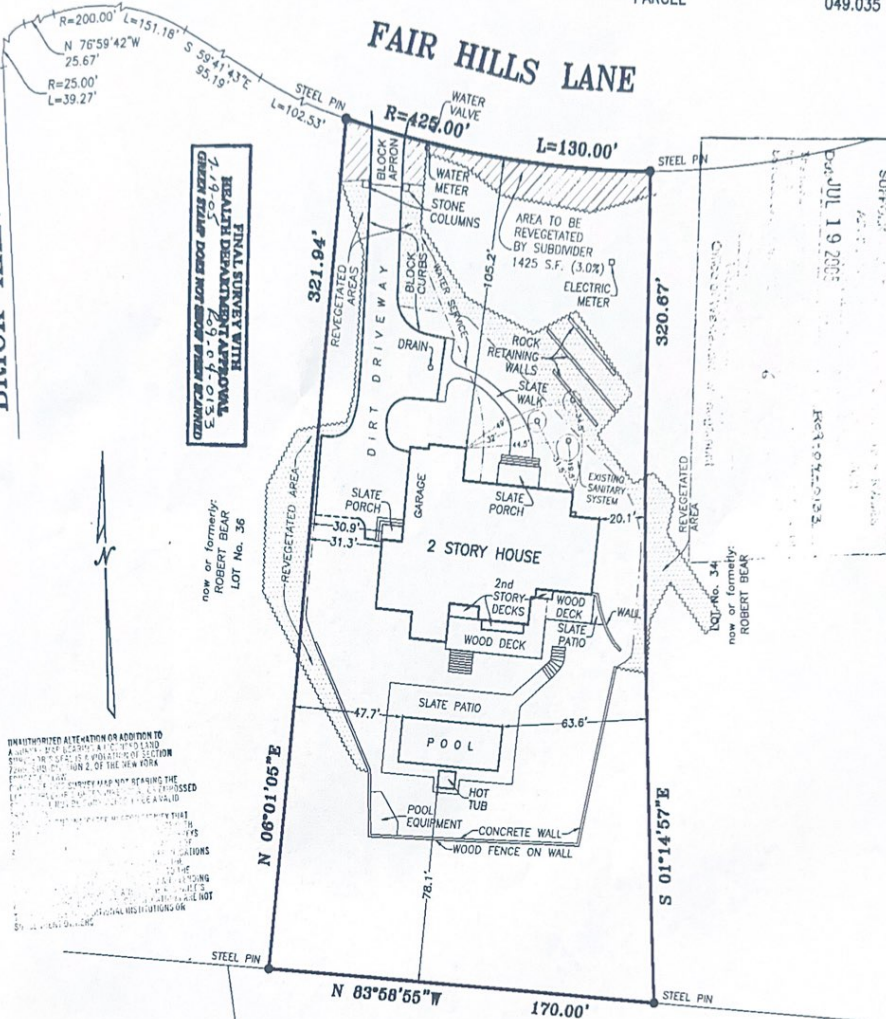

NOTES

1. SUBJECT PARCEL LIES IN THE AQUIFER PROTECTION OVERLAY DISTRICT.
2. EXISTING WATER SERVICE & SANITARY SYSTEM LOCATIONS SHOWN ARE AS PER BUILDER. S.C.D.H.S. REF. No. R09-04-0133
3. CLEARED AREA EXCLUDING REVEGETATED AREAS = 25,102 S.F. (52.9%), CLEARED AREA AFTER REVEGETATION BY SUBDIVIDER = 23,677 S.F. (49.9%).

REVISED: JULY 6, 2005 (REVEGETATED AREAS)
REVISED: JUNE 15, 2006 (FINAL)
SURVEYED: FEBRUARY 2006

LESTER HOLDEN, L.S. No. 49548
S. H. W. & S. LAND SURVEYORS P.C.
SQUIRES, HOLDEN, WEISENBACHER & SMITH
LAND SURVEYORS & ENGINEERS
SOUTHAMPTON ~ NEW YORK

now or formerly:
CLYDE & VICTORIA WESNOFSKE,
SOUTHAMPTON TOWN DEVELOPMENT RIGHTS
& SUFFOLK COUNTY

**MAP OF LOT No. 35
SUBDIVISION MAP OF
FAIR HILLS**

MAP No. 10515 FILED: OCT. 24, 2000
FOR

MILLER - OSTLER BUILDING CORP.

SITUATE
BRIDGEHAMPTON
TOWN OF SOUTHAMPTON
SUFFOLK COUNTY, NEW YORK

AREA = 47,445 S.F.
(1.089 ACRES)

SCALE: 1" = 40'