SURVEY OF PROPERTY
SITUATE
WATER MILL
TOWN OF SOUTHAMPTON
SUFFOLK COUNTY, NEW YORK

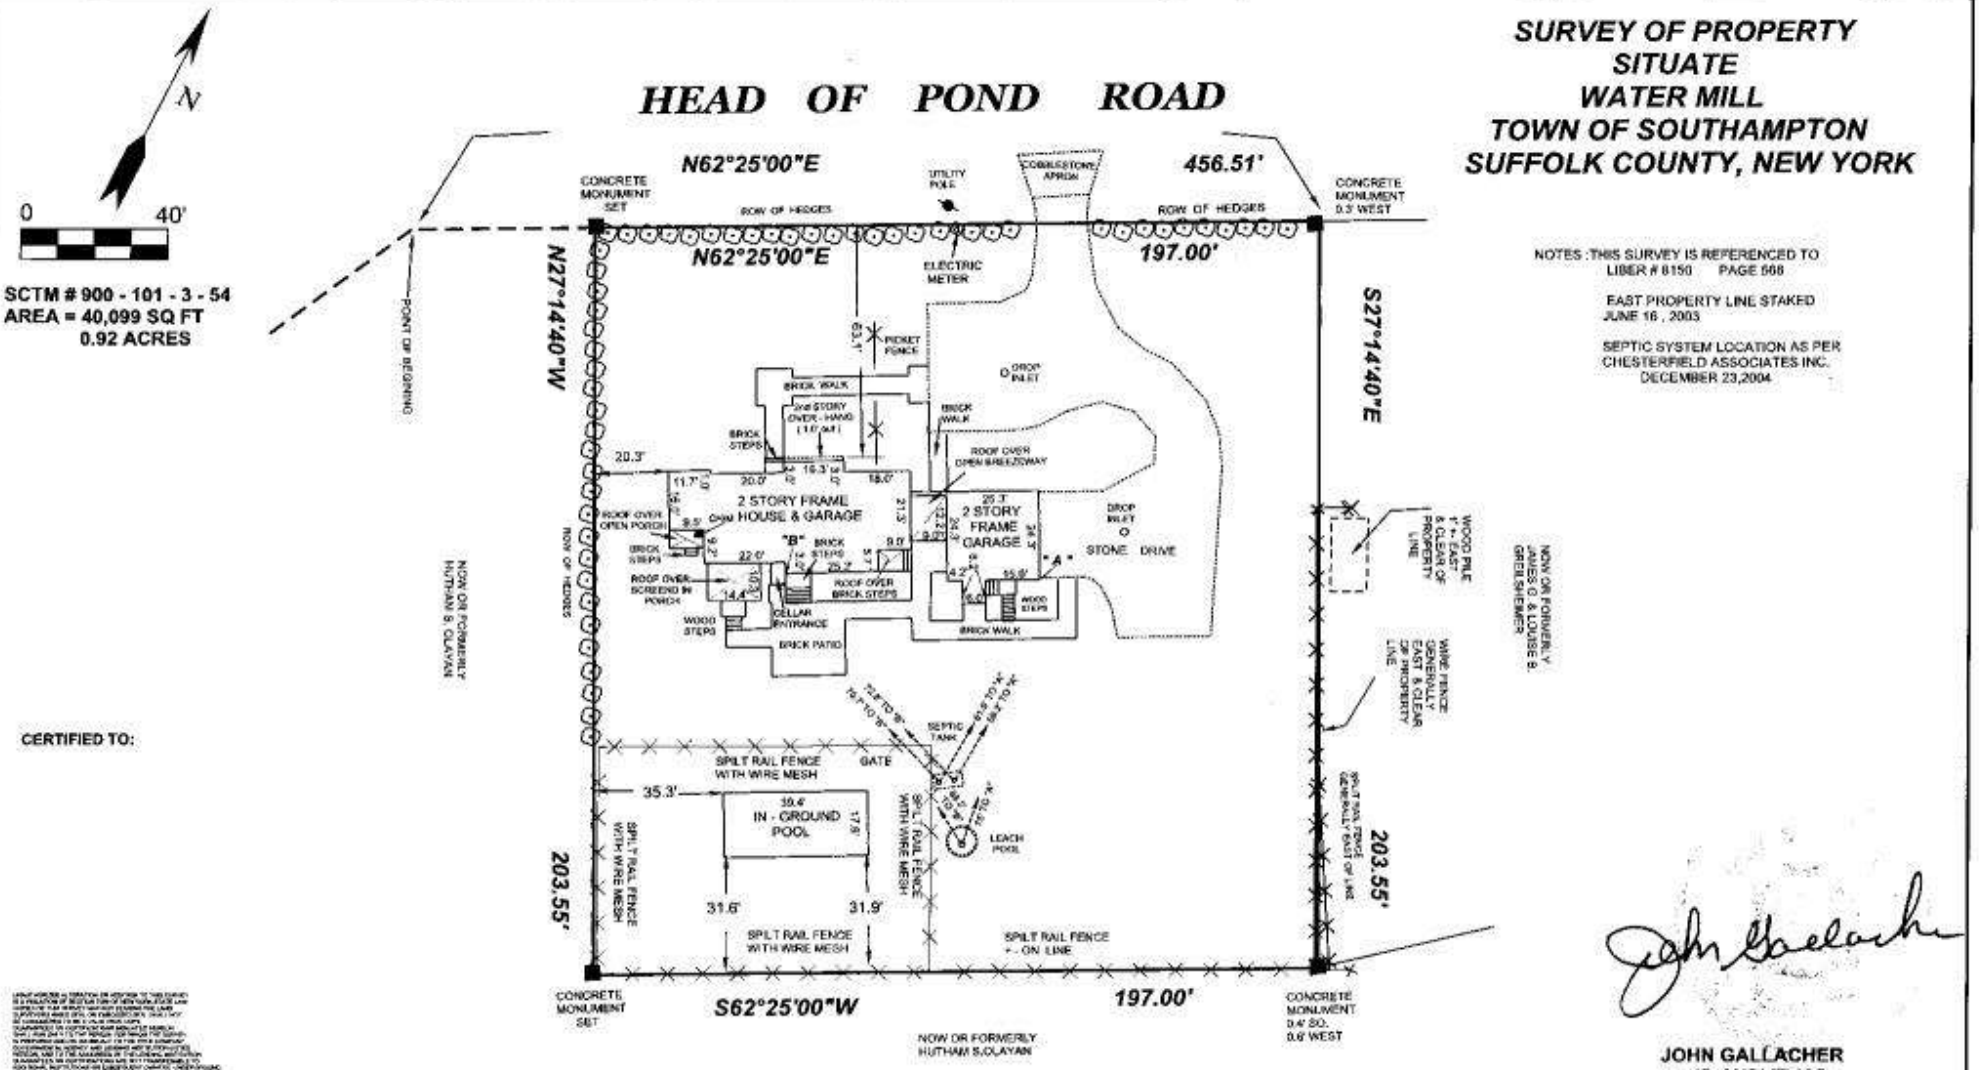

SCTM # 900 - 101 - 3 - 54
AREA = 40,099 SQ FT
0.92 ACRES

NOTES : THIS SURVEY IS REFERENCED TO LIBER # 8150 PAGE 568

EAST PROPERTY LINE STAKED JUNE 16 , 2003

SEPTIC SYSTEM LOCATION AS PER CHESTERFIELD ASSOCIATES INC. DECEMBER 23,2004

CERTIFIED TO:

SURVEYED: MAY 17, 2003
REVISED: JULY 1, 2003 RE- LOCATE POSSESSION ON EAST PROPERTY LINE
REDATED : MARCH 18, 2006

JOHN GALLACHER
LAND SURVEYOR
59 FLORENCE DRIVE
MANORVILLE N.Y 11949
(631) 874 - 0400