


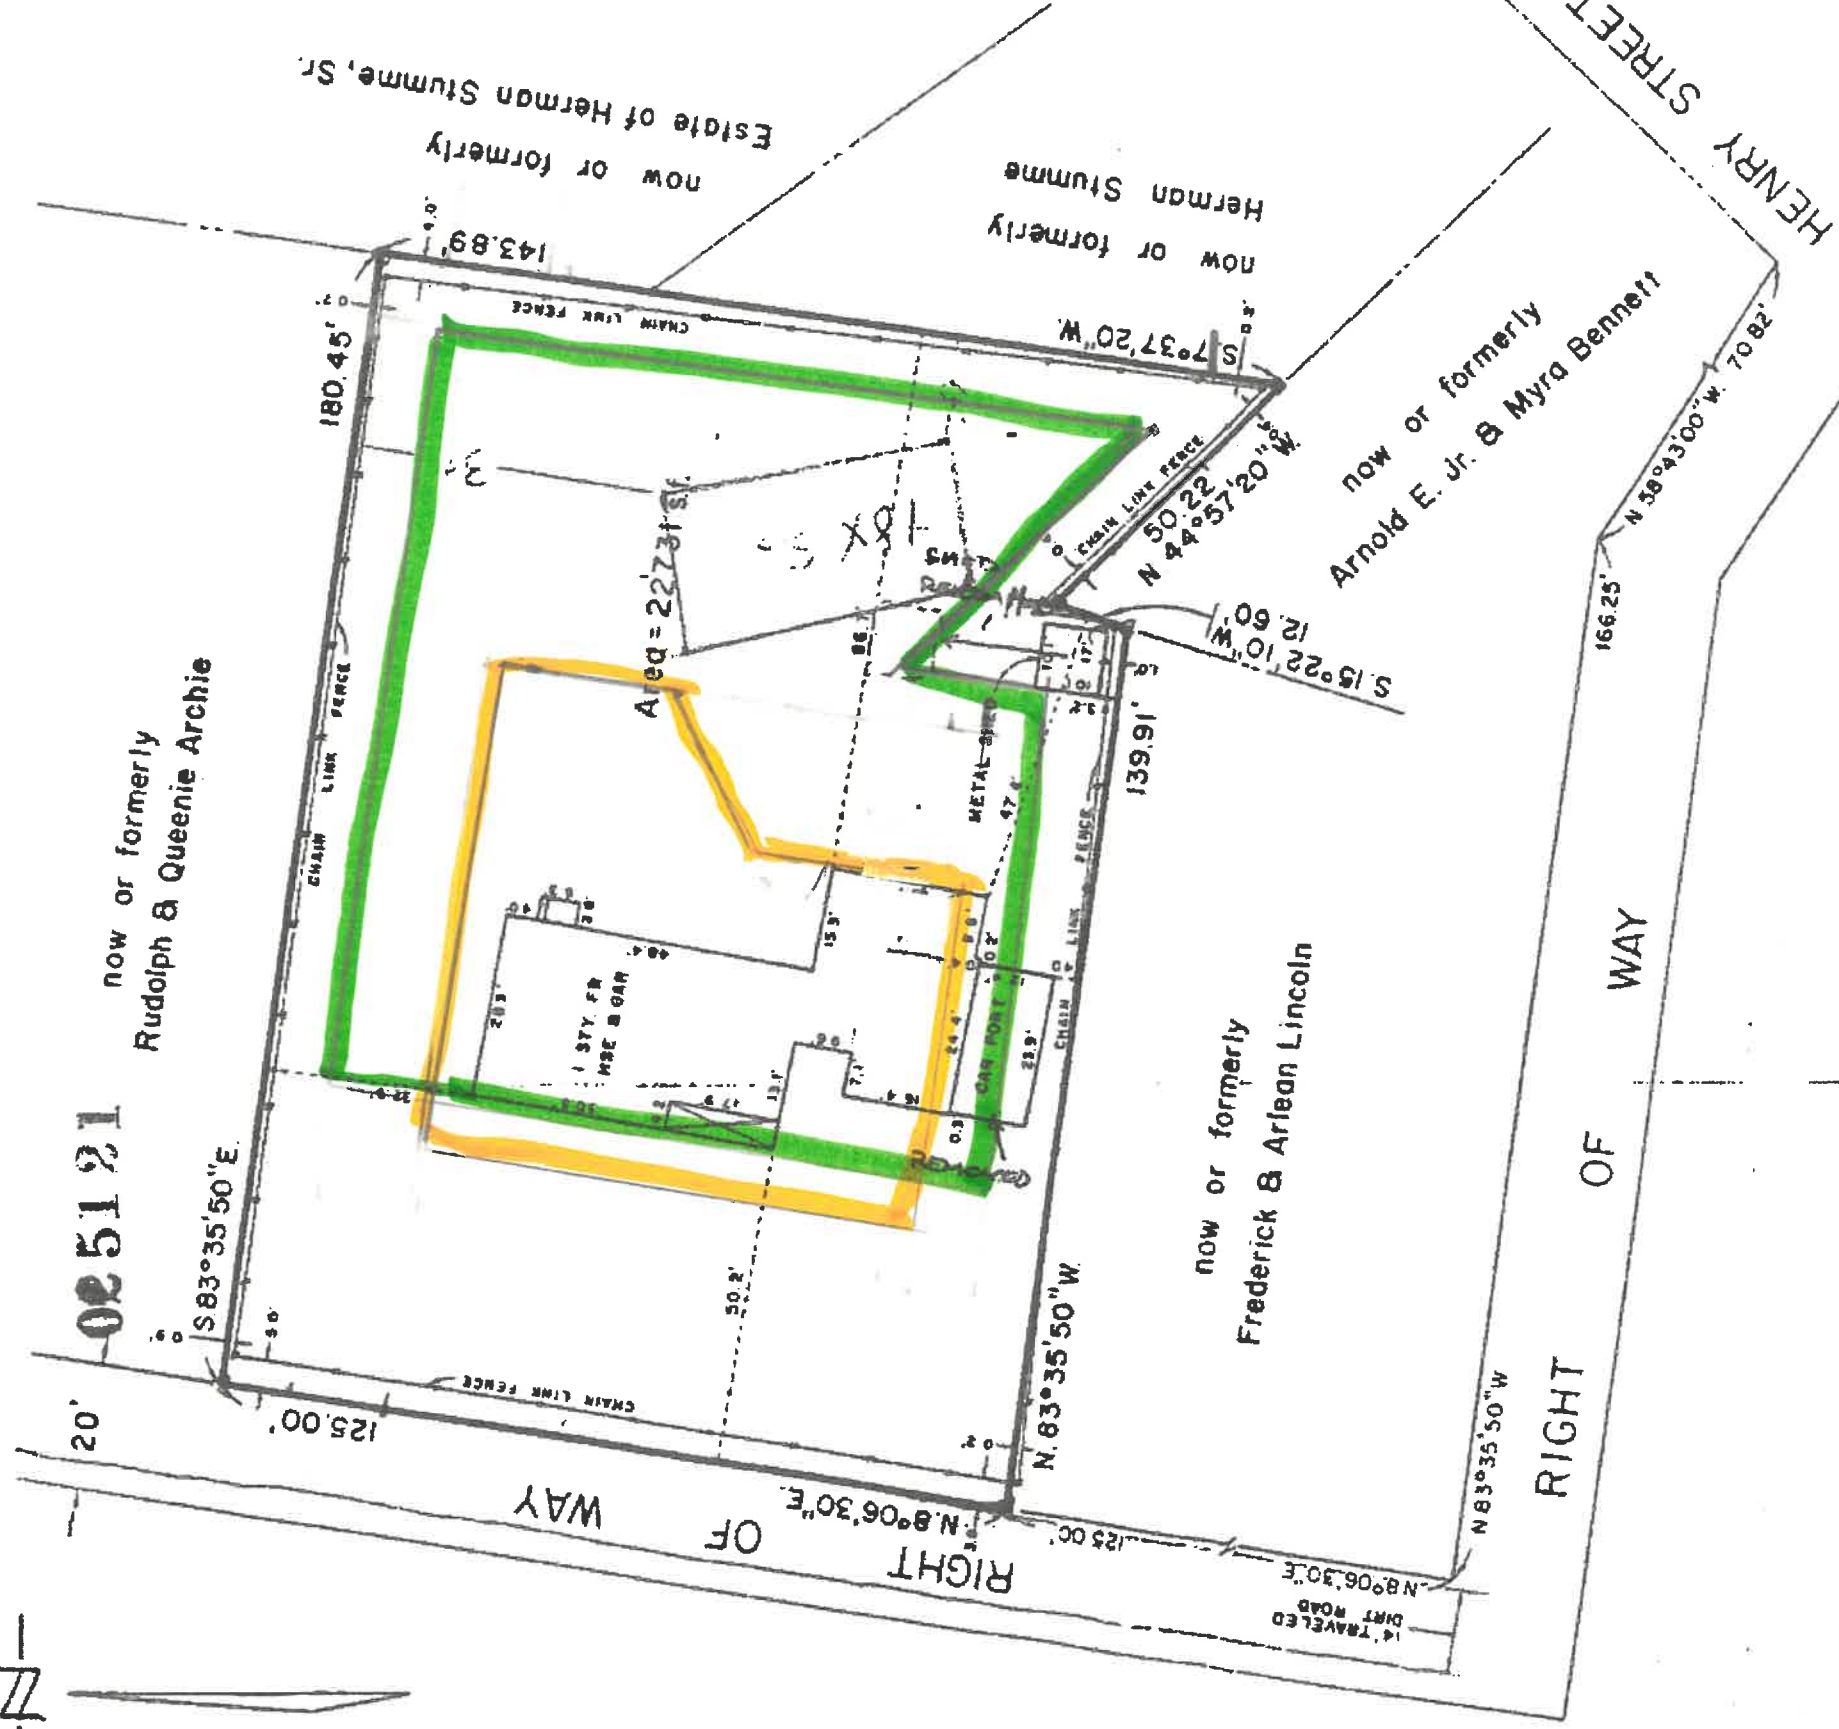


NOTE:
 1. MONUMENT Δ = STAKE
 2. SUFFOLK COUNTY TAX MAP
 DIST. 900 SECT 130 BLK. 1 LOT 22

**SURVEY FOR
 FREDDIE L. LAMB & CONSTANCE LAMB**

**AT SOUTHAMPTON
 TOWN OF SOUTHAMPTON
 SUFFOLK COUNTY, NEW YORK**

DATE JUNE 20, 1989
 SCALE 1" = 30'
 NO. 89-0705

UNAUTHORIZED ALTERATION OR ADDITION TO THIS SURVEY IS A VIOLATION OF SECTION 7209 OF THE NEW YORK STATE EDUCATION LAW. COPIES OF THIS SURVEY NOT BEARING THE LAND SURVEYOR'S WRITTEN SEAL OR EMBOSSED SEAL SHALL NOT BE CONSIDERED TO BE A VALID TRUE COPY. GUARANTEES INDICATED HEREON SHALL RUN ONLY TO THE PERSON FOR WHOM THE SURVEY IS PREPARED, AND ON HIS BEHALF TO THE TITLE COMPANY, GOVERNMENTAL AGENCY AND LENDING INSTITUTION LISTED HEREON, AND TO THE ASSIGNEES OF THE LENDING INSTITUTION. GUARANTEES ARE NOT TRANSFERABLE TO ADDITIONAL INSTITUTIONS OR SUBSEQUENT OWNERS. DISTANCES SHOWN HEREON FROM PROPERTY LINES TO EXISTING STRUCTURES ARE FOR A SPECIFIC PURPOSE AND ARE NOT TO BE USED TO ESTABLISH PROPERTY LINES OR FOR THE DIRECTION OF FENCES.

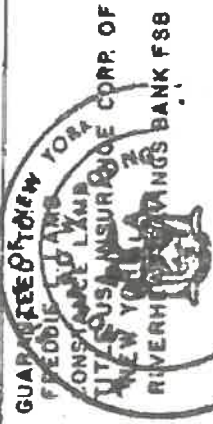

Freddie L. Lamb
 LICENSED LAND SURVEYOR
 No. 4569



YOUNG & YOUNG

ALDEN W. YOUNG, PROFESSIONAL ENGINEER
 AND LAND SURVEYOR N.Y.S. LICENSE NO. 12843
 HOWARD W. YOUNG, LAND SURVEYOR
 N.Y.S. LICENSE NO. 45693

400 OSTRANDER AVENUE
 RIVERHEAD, NEW YORK