
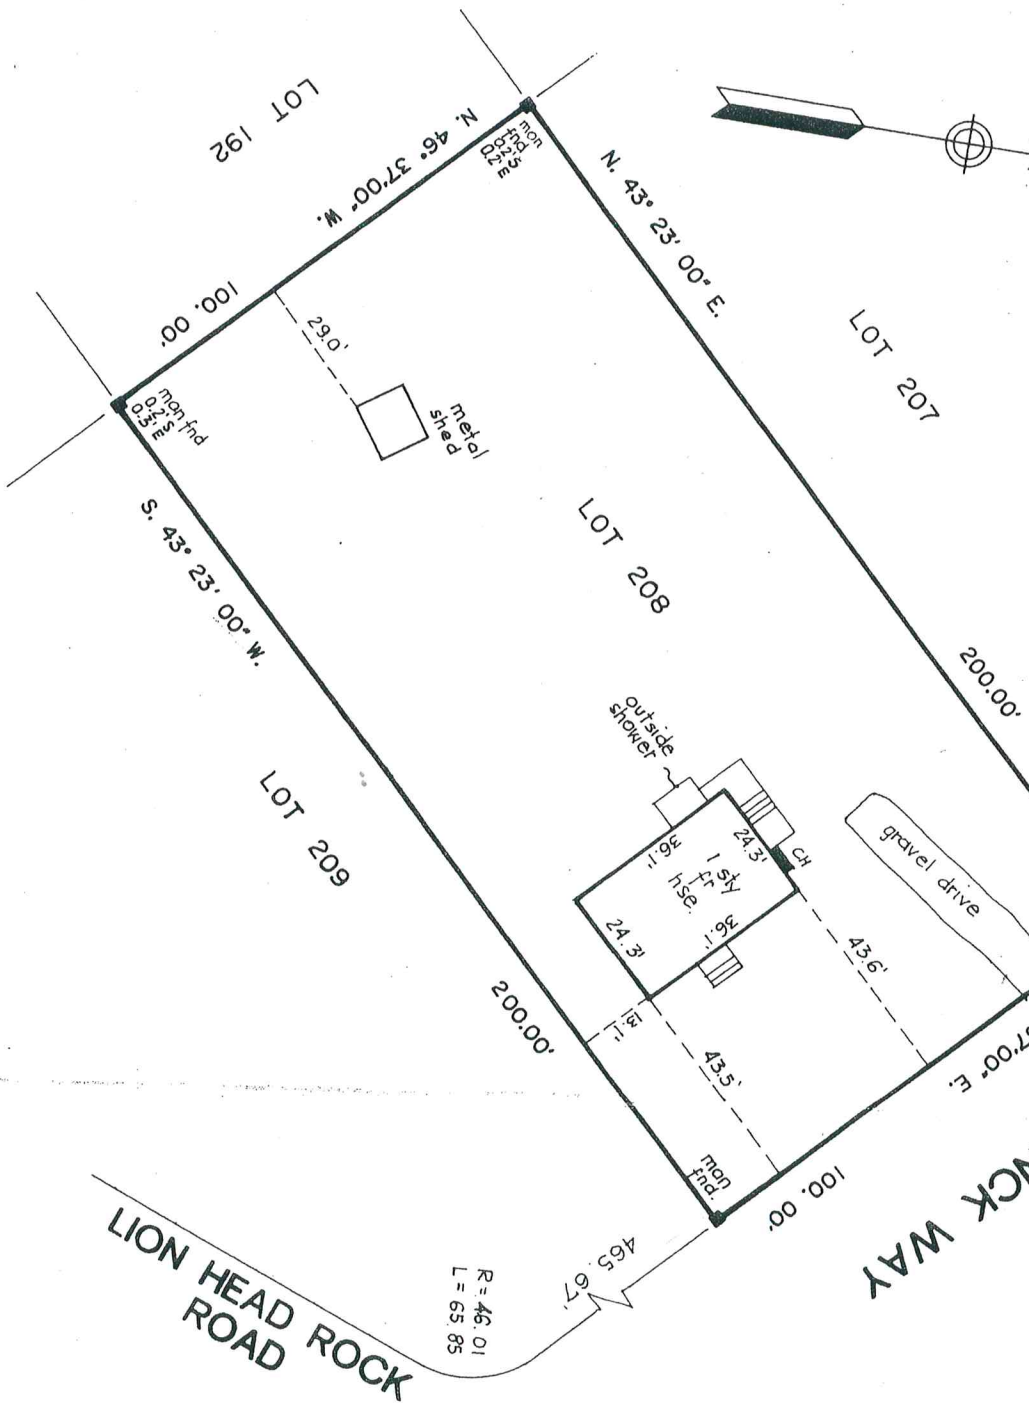


CERTIFIED TO:  
THE HOFFMAN TRUST

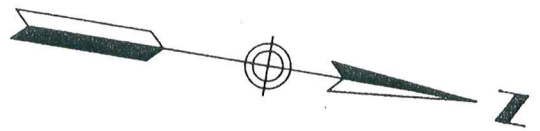

AREA = 20,000 sq. ft.

LION HEAD ROCK  
ROAD

BON PINCK WAY

SURVEY OF  
LOT 208  
CLEARWATER BEACH, SE  
FILED JUNE 4, 1967 MAP NO.  
AT FIREPLACE  
TOWN OF EAST HAM  
SUFFOLK COUNTY,  
300-24-03 -09

Scale: 1" = 30'  
May 27, 1997  
Sept. 25, 1997 (revised)

ANY ALTERATION OR ADDITION TO THIS SURVEY IS A VIOLATION  
OF SECTION 7209 OF THE NEW YORK STATE EDUCATION LAW  
EXCEPT AS PER SECTION 7209-SUBDIVISION 2. ALL CERTIFICATIONS  
HEREON ARE VALID FOR THIS MAP AND COPIES THEREOF ONLY IF  
SAID MAP OR COPIES BEAR THE IMPRESSED SEAL OF THE SURVEYOR  
WHOSE SIGNATURE APPEARS HEREON.  
ADDITIONALLY TO COMPLY WITH SAID LAW THE TERM "ALTERED BY"  
MUST BE USED BY ANY AND ALL SURVEYORS UTILIZING A COPY  
OF ANOTHER SURVEYOR'S MAP. TERMS SUCH AS "INSPECTED" AND  
"BROUGHT-TO-DATE" ARE NOT IN COMPLIANCE WITH THE LAW.

