


LOT COVERAGE:

HOUSE = 1537 S.F.
COTTAGE = 645 S.F.
DECKS = 1395 S.F.
POOL = 214 S.F.
WALKS = 96 S.F.
COV. BIN = 20 S.F.
TOTAL = 3907 S.F. OR 32.7%

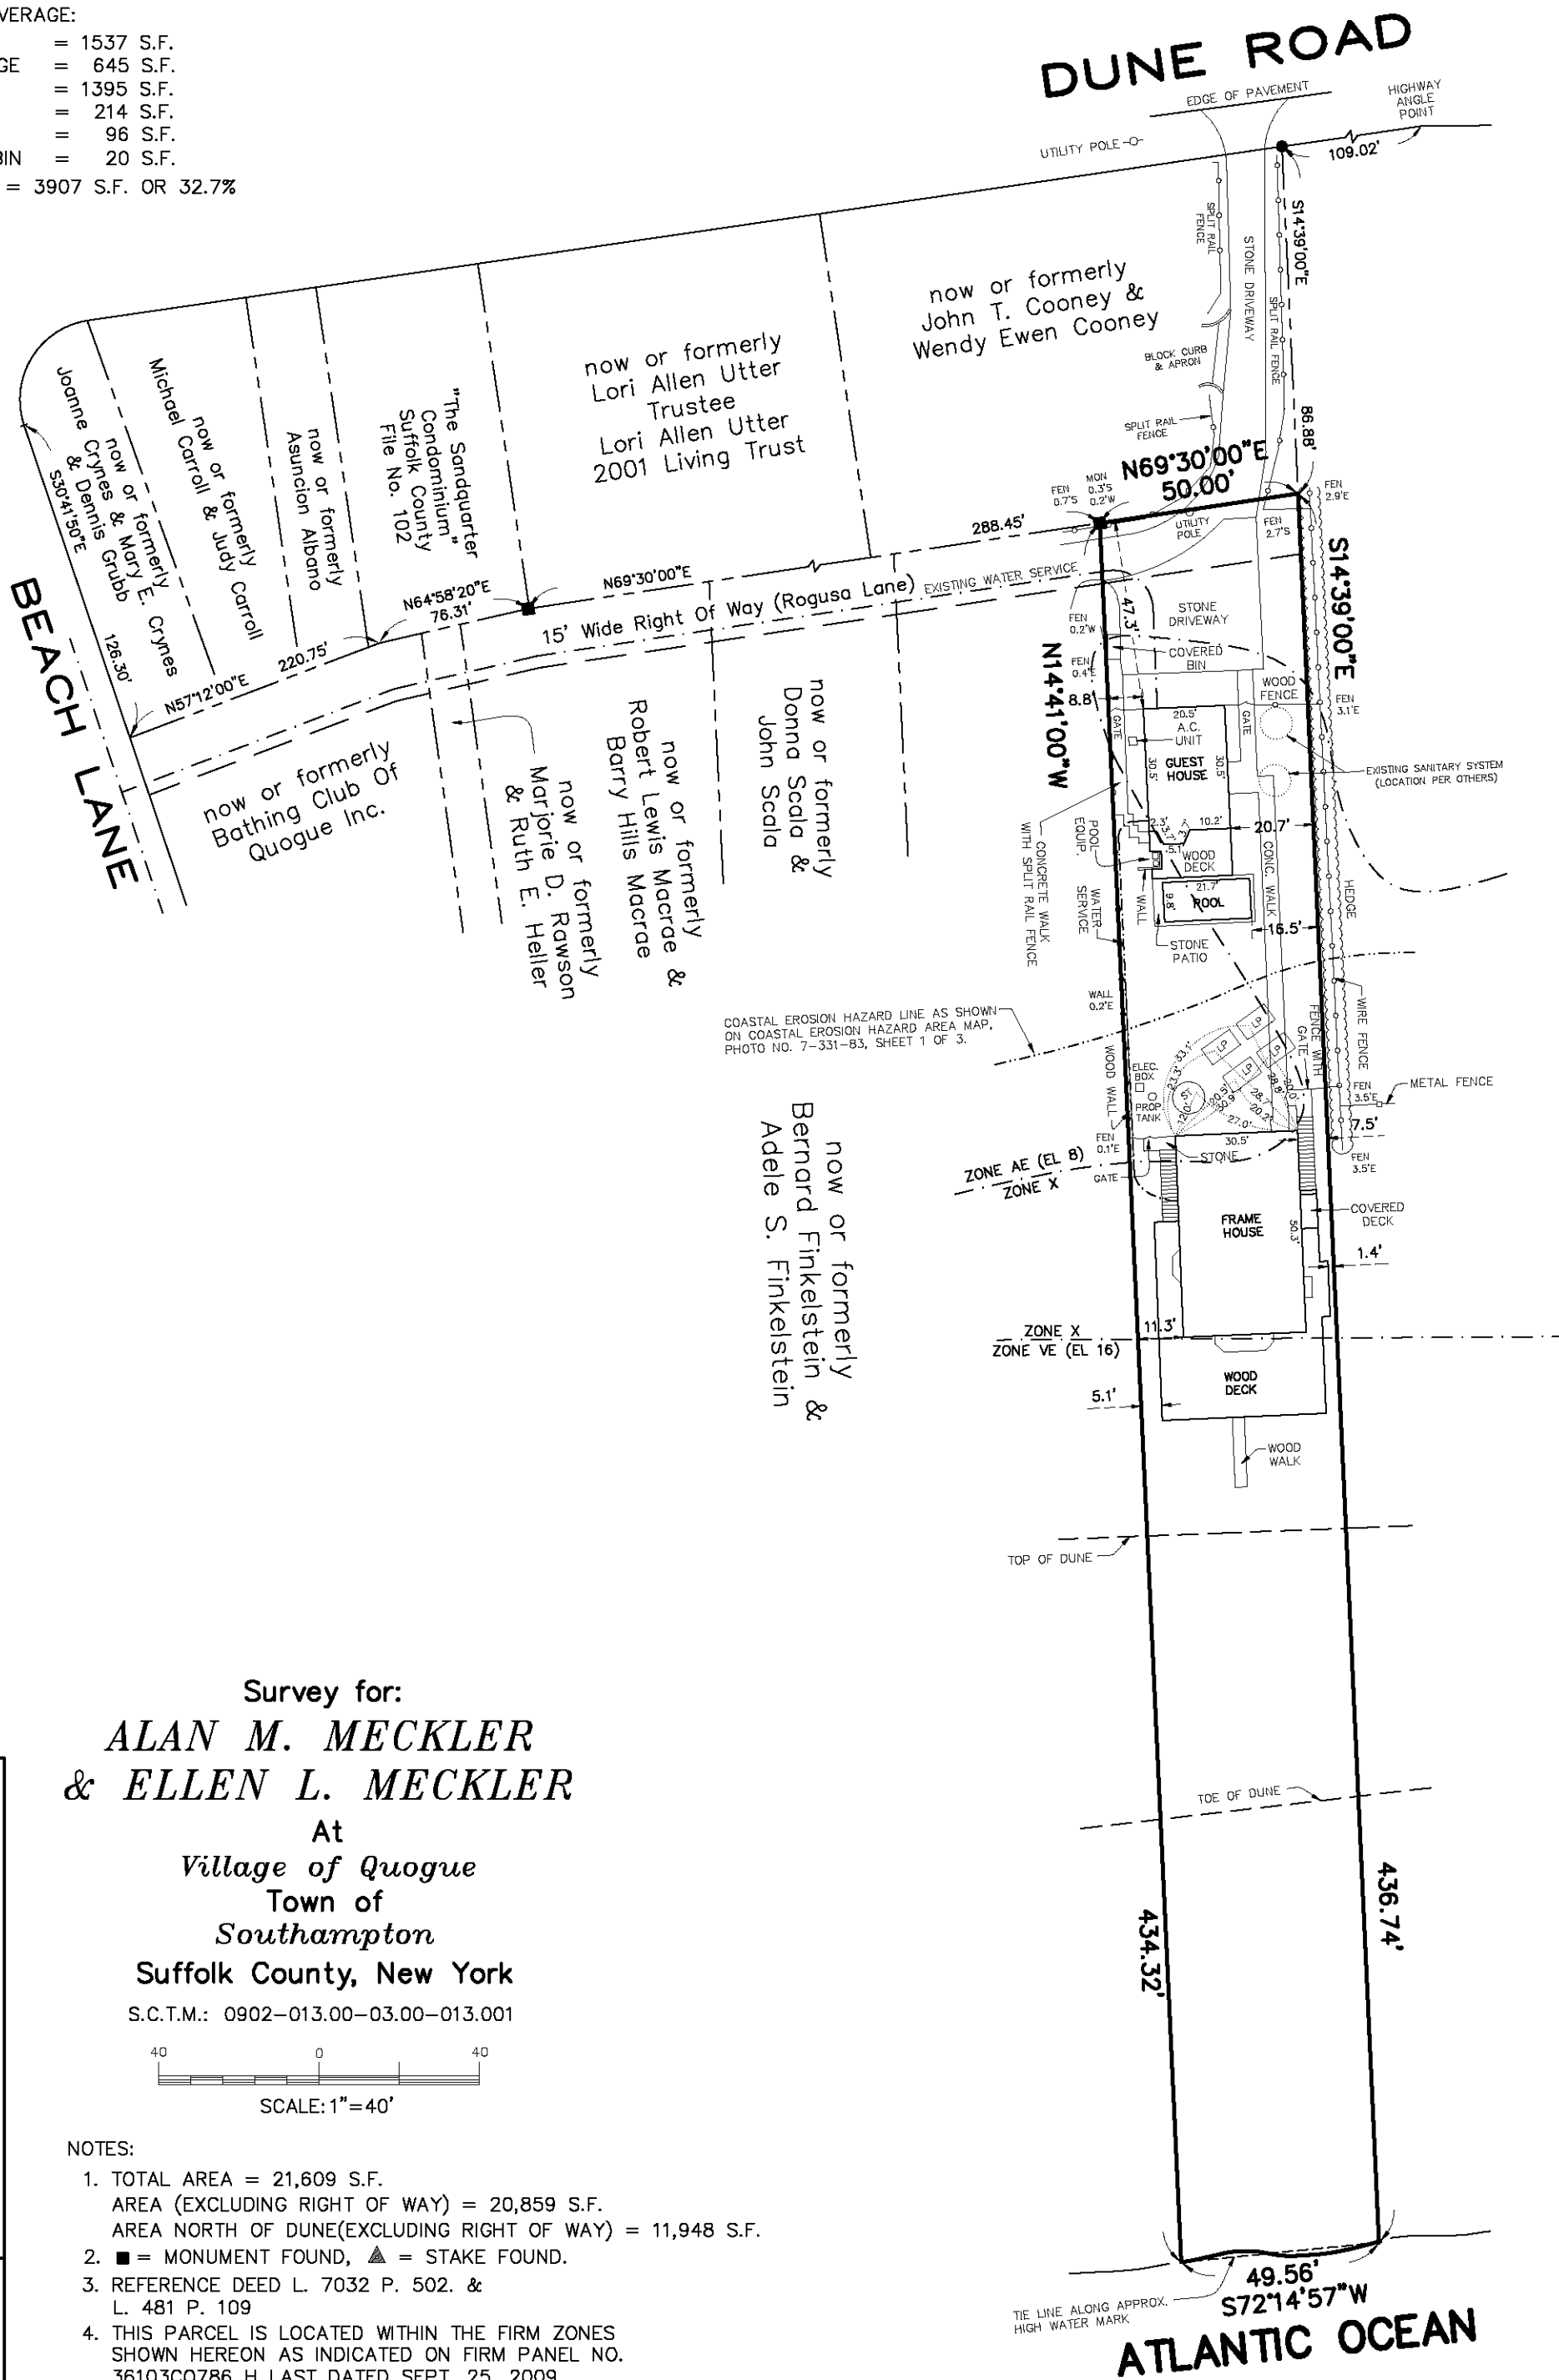


SEPT. 2, 2016 FINAL SURVEY
APR. 01, 2016 STAKED COTTAGE
FEB. 23, 2016 AMENDED COTTAGE
JAN. 5, 2016 AMENDED CERTIFICATIONS
NOV. 19, 2015 ADDED CERTIFICATIONS
NOV. 12, 2015 INDICATE PROP POOL
DATE: NOV. 4, 2015
JOB NO: 2015-654

CERTIFIED TO:
ALAN M. MECKLER & ELLEN L. MECKLER
DEUTSCHE BANK TRUST COMPANY
AMERICAS
FIDELITY NATIONAL TITLE INSURANCE
COMPANY

Survey for:
**ALAN M. MECKLER
& ELLEN L. MECKLER**

At
**Village of Quogue
Town of
Southampton
Suffolk County, New York**

S.C.T.M.: 0902-013.00-03.00-013.001

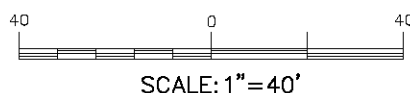

NOTES:

1. TOTAL AREA = 21,609 S.F.
AREA (EXCLUDING RIGHT OF WAY) = 20,859 S.F.
AREA NORTH OF DUNE(EXCLUDING RIGHT OF WAY) = 11,948 S.F.
2. ■ = MONUMENT FOUND, ▲ = STAKE FOUND.
3. REFERENCE DEED L. 7032 P. 502. &
L. 481 P. 109
4. THIS PARCEL IS LOCATED WITHIN THE FIRM ZONES
SHOWN HEREON AS INDICATED ON FIRM PANEL NO.
36103C0786 H LAST DATED SEPT. 25, 2009.

DAVID H. FOX, L.S. P.C. N.Y.S.L.S. #50234
FOX LAND SURVEYING
64 SUNSET AVENUE
WESTHAMPTON BEACH, N.Y. 11978
(631) 288-0022

UNAUTHORIZED ALTERATION OR ADDITION TO THIS SURVEY
IS A VIOLATION OF SECTION 7209 OF THE NEW YORK STATE
EDUCATION LAW. COPIES OF THIS SURVEY MAP NOT BEARING
THE LAND SURVEYOR'S INKED SEAL OR EMBOSSED SEAL
SHALL NOT BE CONSIDERED TO BE A VALID TRUE COPY.

CERTIFICATION INDICATED HEREON SHALL RUN ONLY TO THE
PERSON FOR WHOM THE SURVEY IS PREPARED AND ON HIS
BEHALF TO THE TITLE COMPANY, GOVERNMENTAL AGENCY
AND LENDING INSTITUTION LISTED HEREON, AND TO THE
ASSIGNEES OF THE LENDING INSTITUTION. CERTIFICATIONS
ARE NOT TRANSFERABLE TO ADDITIONAL INSTITUTIONS
OR SUBSEQUENT OWNERS.