


Unauthorized alteration or addition to this survey is a violation of section 7209 of the New York State Education Law. Copies of this survey map not bearing the land surveyor's inked seal or embossed seal shall not be considered to be a valid copy. Guarantees or certifications indicated hereon shall run only to the person for whom the survey is prepared, and on his behalf to the title company, governmental agency and lending institution listed hereon, and to the assignees of the lending institution. Guarantees or certifications are not transferable to additional institutions or subsequent owners.

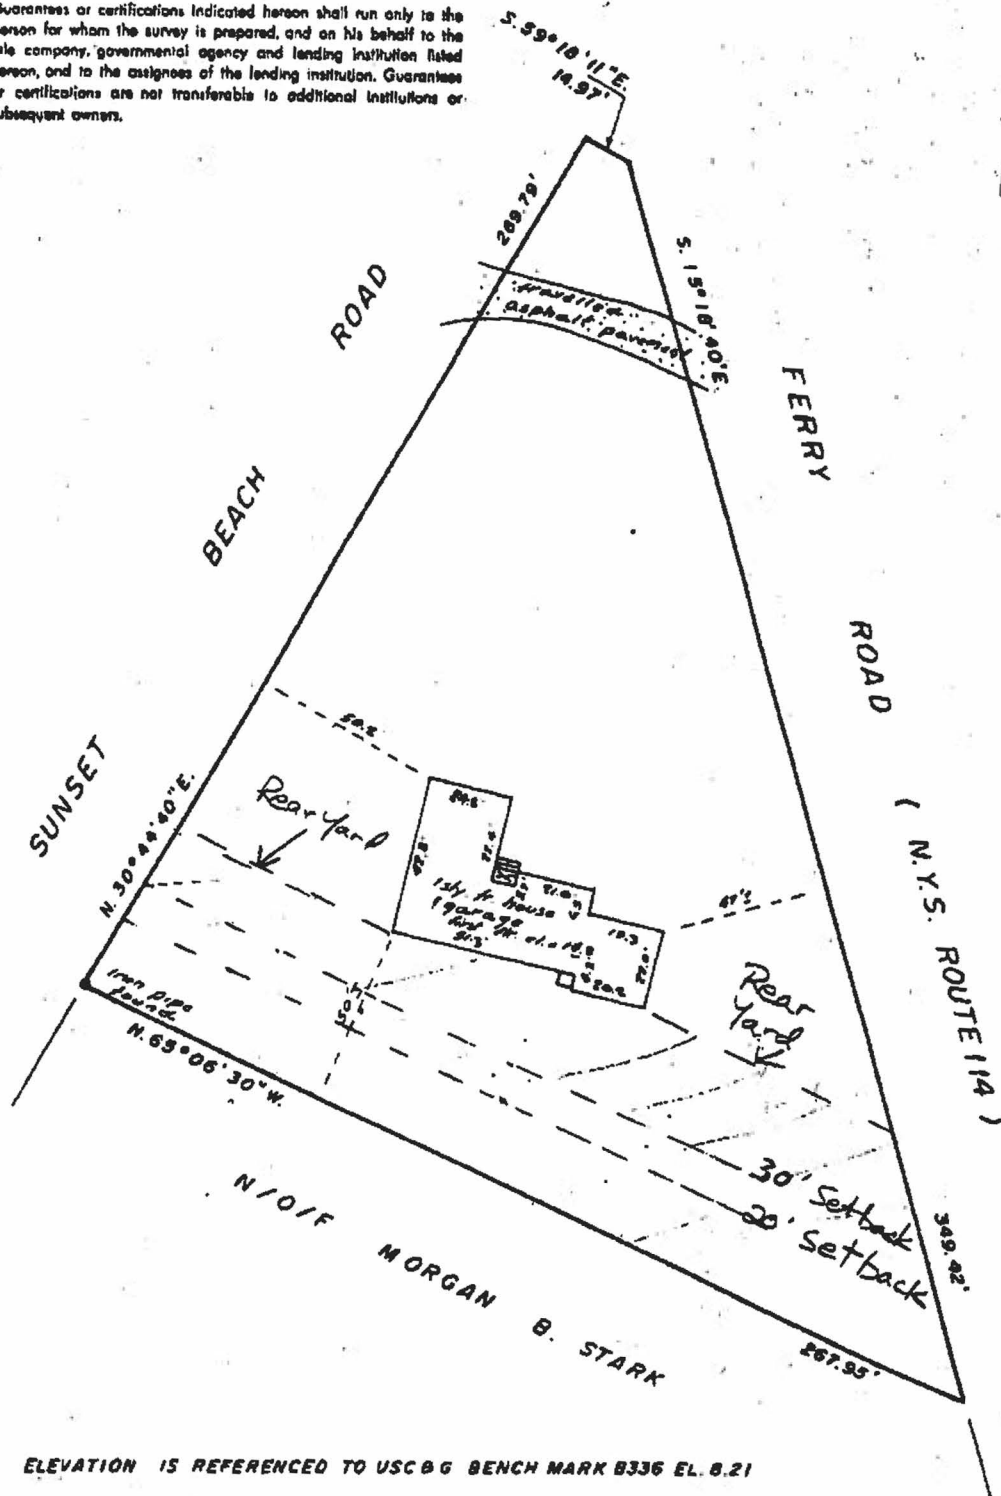

SURVEY FOR
MARY LYNN GRIFFIN
AT NORTH HAVEN
TOWN OF SOUTHAMPTON
SUFFOLK COUNTY, N.Y.

SCALE: 1" = 40'
SEPT. 29, 1980



REFERENCE:

GUARANTEED TO:
THE TITLE GUARANTEE COMPANY
EASTERN FEDERAL SAVINGS & LOAN ASSOCIATION
MARY LYNN GRIFFIN

Robert A. Kart
LAND SURVEYOR
N.Y.S. LIC. NO. 28725
RIVERHEAD, N.Y.