


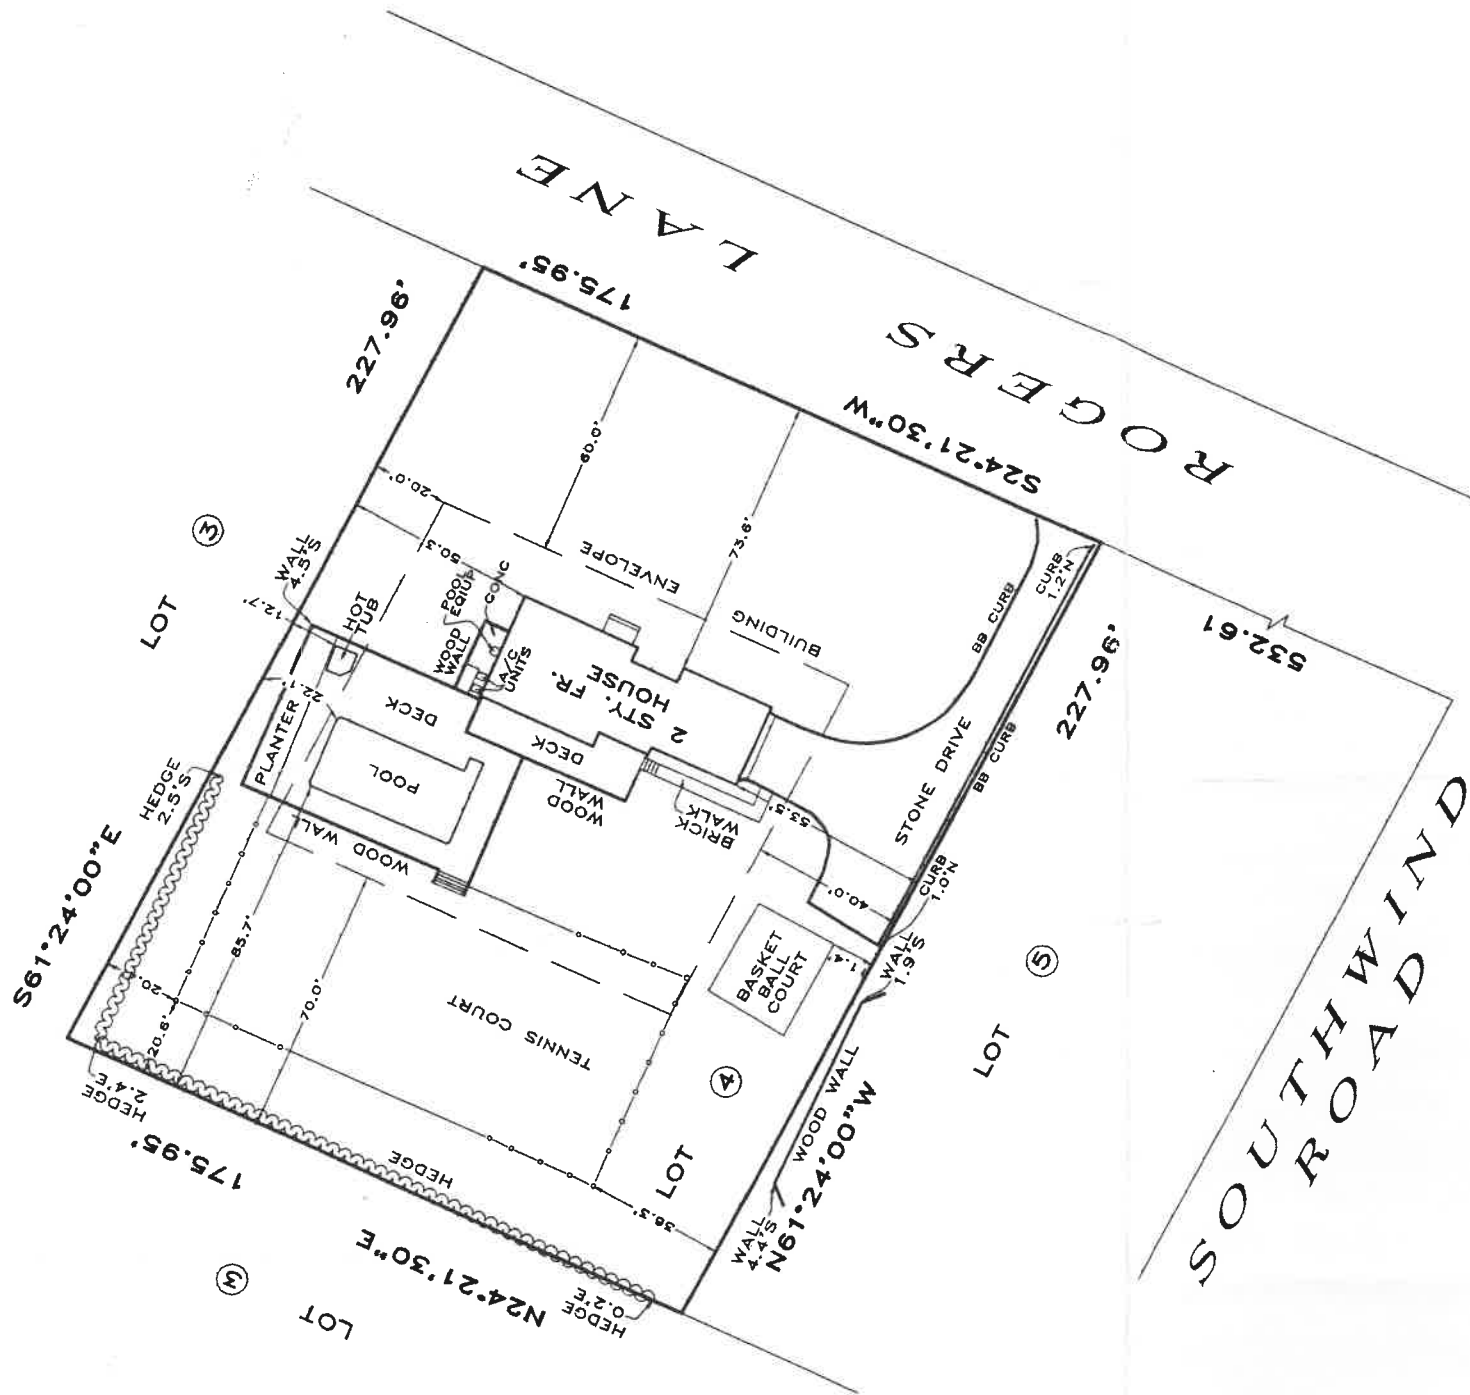

REAR LOT COVERAGE: 12/21/04
TENNIS COURT = 5,855 SQ. FT.
5,855 SQ. FT. / 12,317 SQ. FT.
X 100 = 47.5%

NOTE:
LOT NUMBERS SHOWN ARE FROM MAP ENTITLED
"JAMES J. TUBRIDY" FILED IN THE SUFFOLK
COUNTY CLERK'S OFFICE ON NOV. 25, 1968
AS MAP No. 5220.



D43-B-67

TAX	MAP
DISTRICT	0900
SECTION	380
BLOCK	01
LOT	82

UNAUTHORIZED ALTERATION OR ADDITION TO A SURVEY
MAP BEARING A LICENSED LAND SURVEYOR'S SEAL IS A
VIOLATION OF THE EMBOSSED SEAL ACT, DIVISION 2, OF THE
NEW YORK STATE EDUCATION LAW.

ONLY COPIES FROM THE ORIGINAL OF THIS SURVEY
MARKED WITH AN ORIGINAL OF THE LAND SURVEYOR'S
INKED SEAL OR EMBOSSED SEAL SHALL BE CONSIDERED
TO BE VALID TRUE COPIES.

CERTIFICATIONS INDICATED HEREON SHALL RUN
FROM THE PERSONS WHOSE SURVEYING IS
PREPARED, AND ON THIS BEHALF TO THE TITLE
COMPANY, GOVERNMENTAL AGENCY AND LENDING
INSTITUTION LISTED HEREON, AND TO THE ASSIGNEES
OF THE LENDING INSTITUTION. CERTIFICATIONS ARE
NOT TO BE MADE TO ADDITIONAL INSTITUTIONS OR
SUBSEQUENT OWNERS.

RAYNOR, MARCKS
&
CARRINGTON
SURVEYING
QUOGUE, N.Y.
631-653-4066

MAP OF PROPERTY
FOR
**ROBERT & CINDY
ANDRIALIS**
SITUATE
REMSENBURG

TOWN OF SOUTHAMPTON - SUFFOLK COUNTY, N.Y.
SURVEYED: NOV. 23, 2004 - SCALE: 1" INCH = 50' FT.



FEMA ZONE - AE EL.9'
FIRM 36103C0762G 5/4/98
BUILDING ZONE R-40

21 ROGERS LANE
AREA: 40,000 SQ.FT.
BK:214 PG:18

D43-B-67
DRAWN BY: H.A.
(ARCHIV11 ANDRIALIS)