


Survey for:
PAUL LEVY
& KAREN LEVY
 At
Westhampton
 Town of
Southampton
 Suffolk County, New York
 S.C.T.M.: 0900-376.00-03.00-020.000

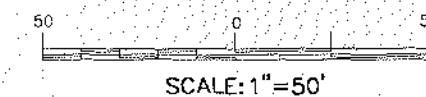

- NOTES:
1. AREA = 85,059 S.F.
 2. ■ = MONUMENT FOUND, ▲ = STAKE FOUND, △ = STAKE SET.
 3. REFERENCE DEED L. 10306 P. 0044.

DEC. 12, 2013 IND. PROP. GATES
 JULY 19, 2011 FINAL SURVEY
 MAR. 11, 2011 IND. PROP. PORCH
 JAN. 11, 2011 PROP. POOL
 DEC. 3, 2010 STAKES SET
 NOV. 18, 2010 IND. SPOT ELEVATIONS
 DATE: NOV. 5, 2010
 JOB NO: 2010-410

CERTIFIED TO:
 PAUL LEVY
 KAREN LEVY

DAVID H. FOX, L.S. P.C. N.Y.S.L.S. #50234
FOX LAND SURVEYING
 64 SUNSET AVENUE
 WESTHAMPTON BEACH, N.Y. 11978
 (631) 288-0022

UNAUTHORIZED ALTERATION OR ADDITION TO THIS SURVEY IS A VIOLATION OF SECTION 2208 OF THE NEW YORK STATE EDUCATION LAW. COPIES OF THIS SURVEY MAP NOT BEARING THE LAND SURVEYOR'S INKED SEAL OR EMBOSSED SEAL SHALL NOT BE CONSIDERED TO BE A VALID TRUE COPY.

CERTIFICATION INDICATED HEREON SHALL RUN ONLY TO THE PERSON FOR WHOM THE SURVEY IS PREPARED AND ON HIS BEHALF TO THE TITLE COMPANY, GOVERNMENTAL AGENCY AND LENDING INSTITUTION LISTED HEREON, AND TO THE ASSIGNEES OF THE LENDING INSTITUTION. CERTIFICATIONS ARE NOT TRANSFERABLE TO ADDITIONAL INSTITUTIONS OR SUBSEQUENT OWNERS.

SANITARY MEASUREMENTS

	A	B
ST	87.5'	16.3'
DP	69'	54'
LP1	61'	51.5'
LP2	67.5'	61'
LP3	72.5'	53'
LP4	67'	48.5'

