


DISTRICT	0900
SECTION	020.00
BLOCK	01.00
PARCEL	001.038 & 001.039

COMMUNITY RESERVE AREA No. 3
now or formerly:
WHALEBONE LANDING HOMEOWNERS

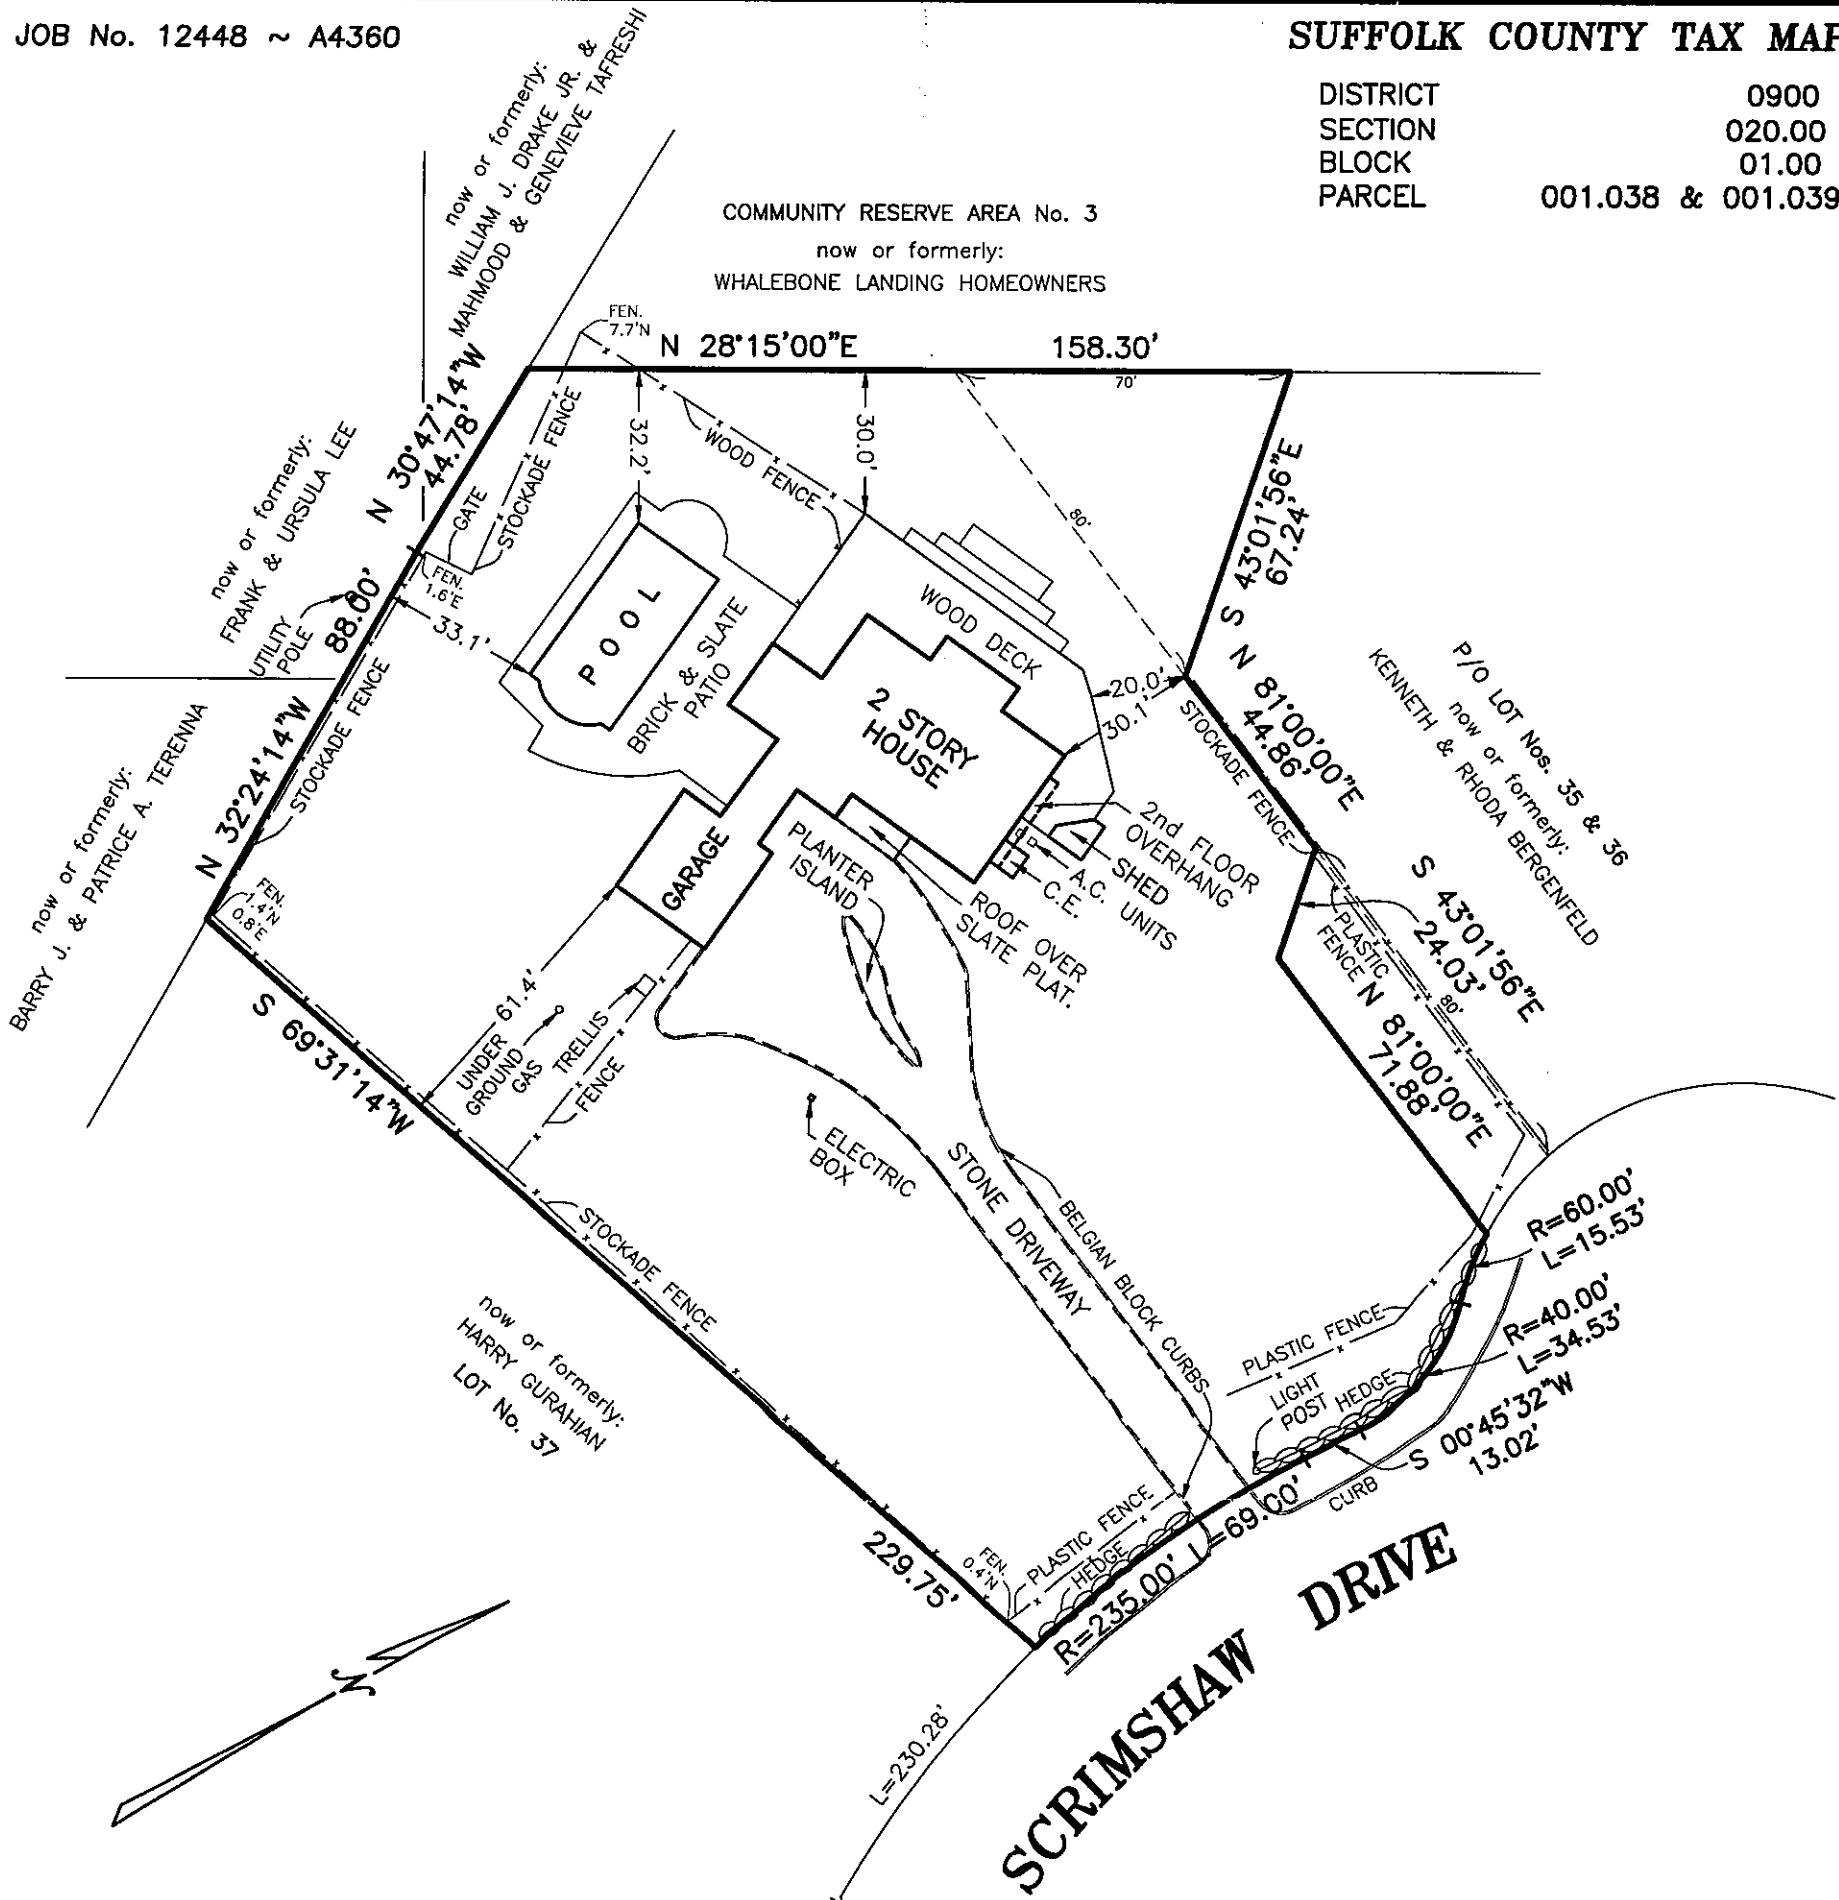

CERTIFIED TO:
ROBERT PELHAM
CHICAGO TITLE INSURANCE Co.

MAP OF PARTS OF LOT Nos. 35 & 36
SUBDIVISION MAP OF
WHALEBONE LANDING
MAP No. 6206 FILED: JANUARY 3, 1975
FOR
ROBERT PELHAM
SITUATE
NOYACK
TOWN OF SOUTHAMPTON
SUFFOLK COUNTY, NEW YORK

SURVEYED: JULY 28, 2003

Karl W. Weisenbacher
KARL W. WEISENBACHER, L.S. No. 36195
S. H. W. & S. LAND SURVEYORS P.C.

SQUIRES, HOLDEN, WEISENBACHER & SMITH
LAND SURVEYORS ~ ENGINEERS
SOUTHAMPTON ~ NEW YORK

AREA = 43,500 S.F.
(0.999 ACRE)
SCALE: 1" = 40'