


209-10-0169 24 BRIDLE PATH

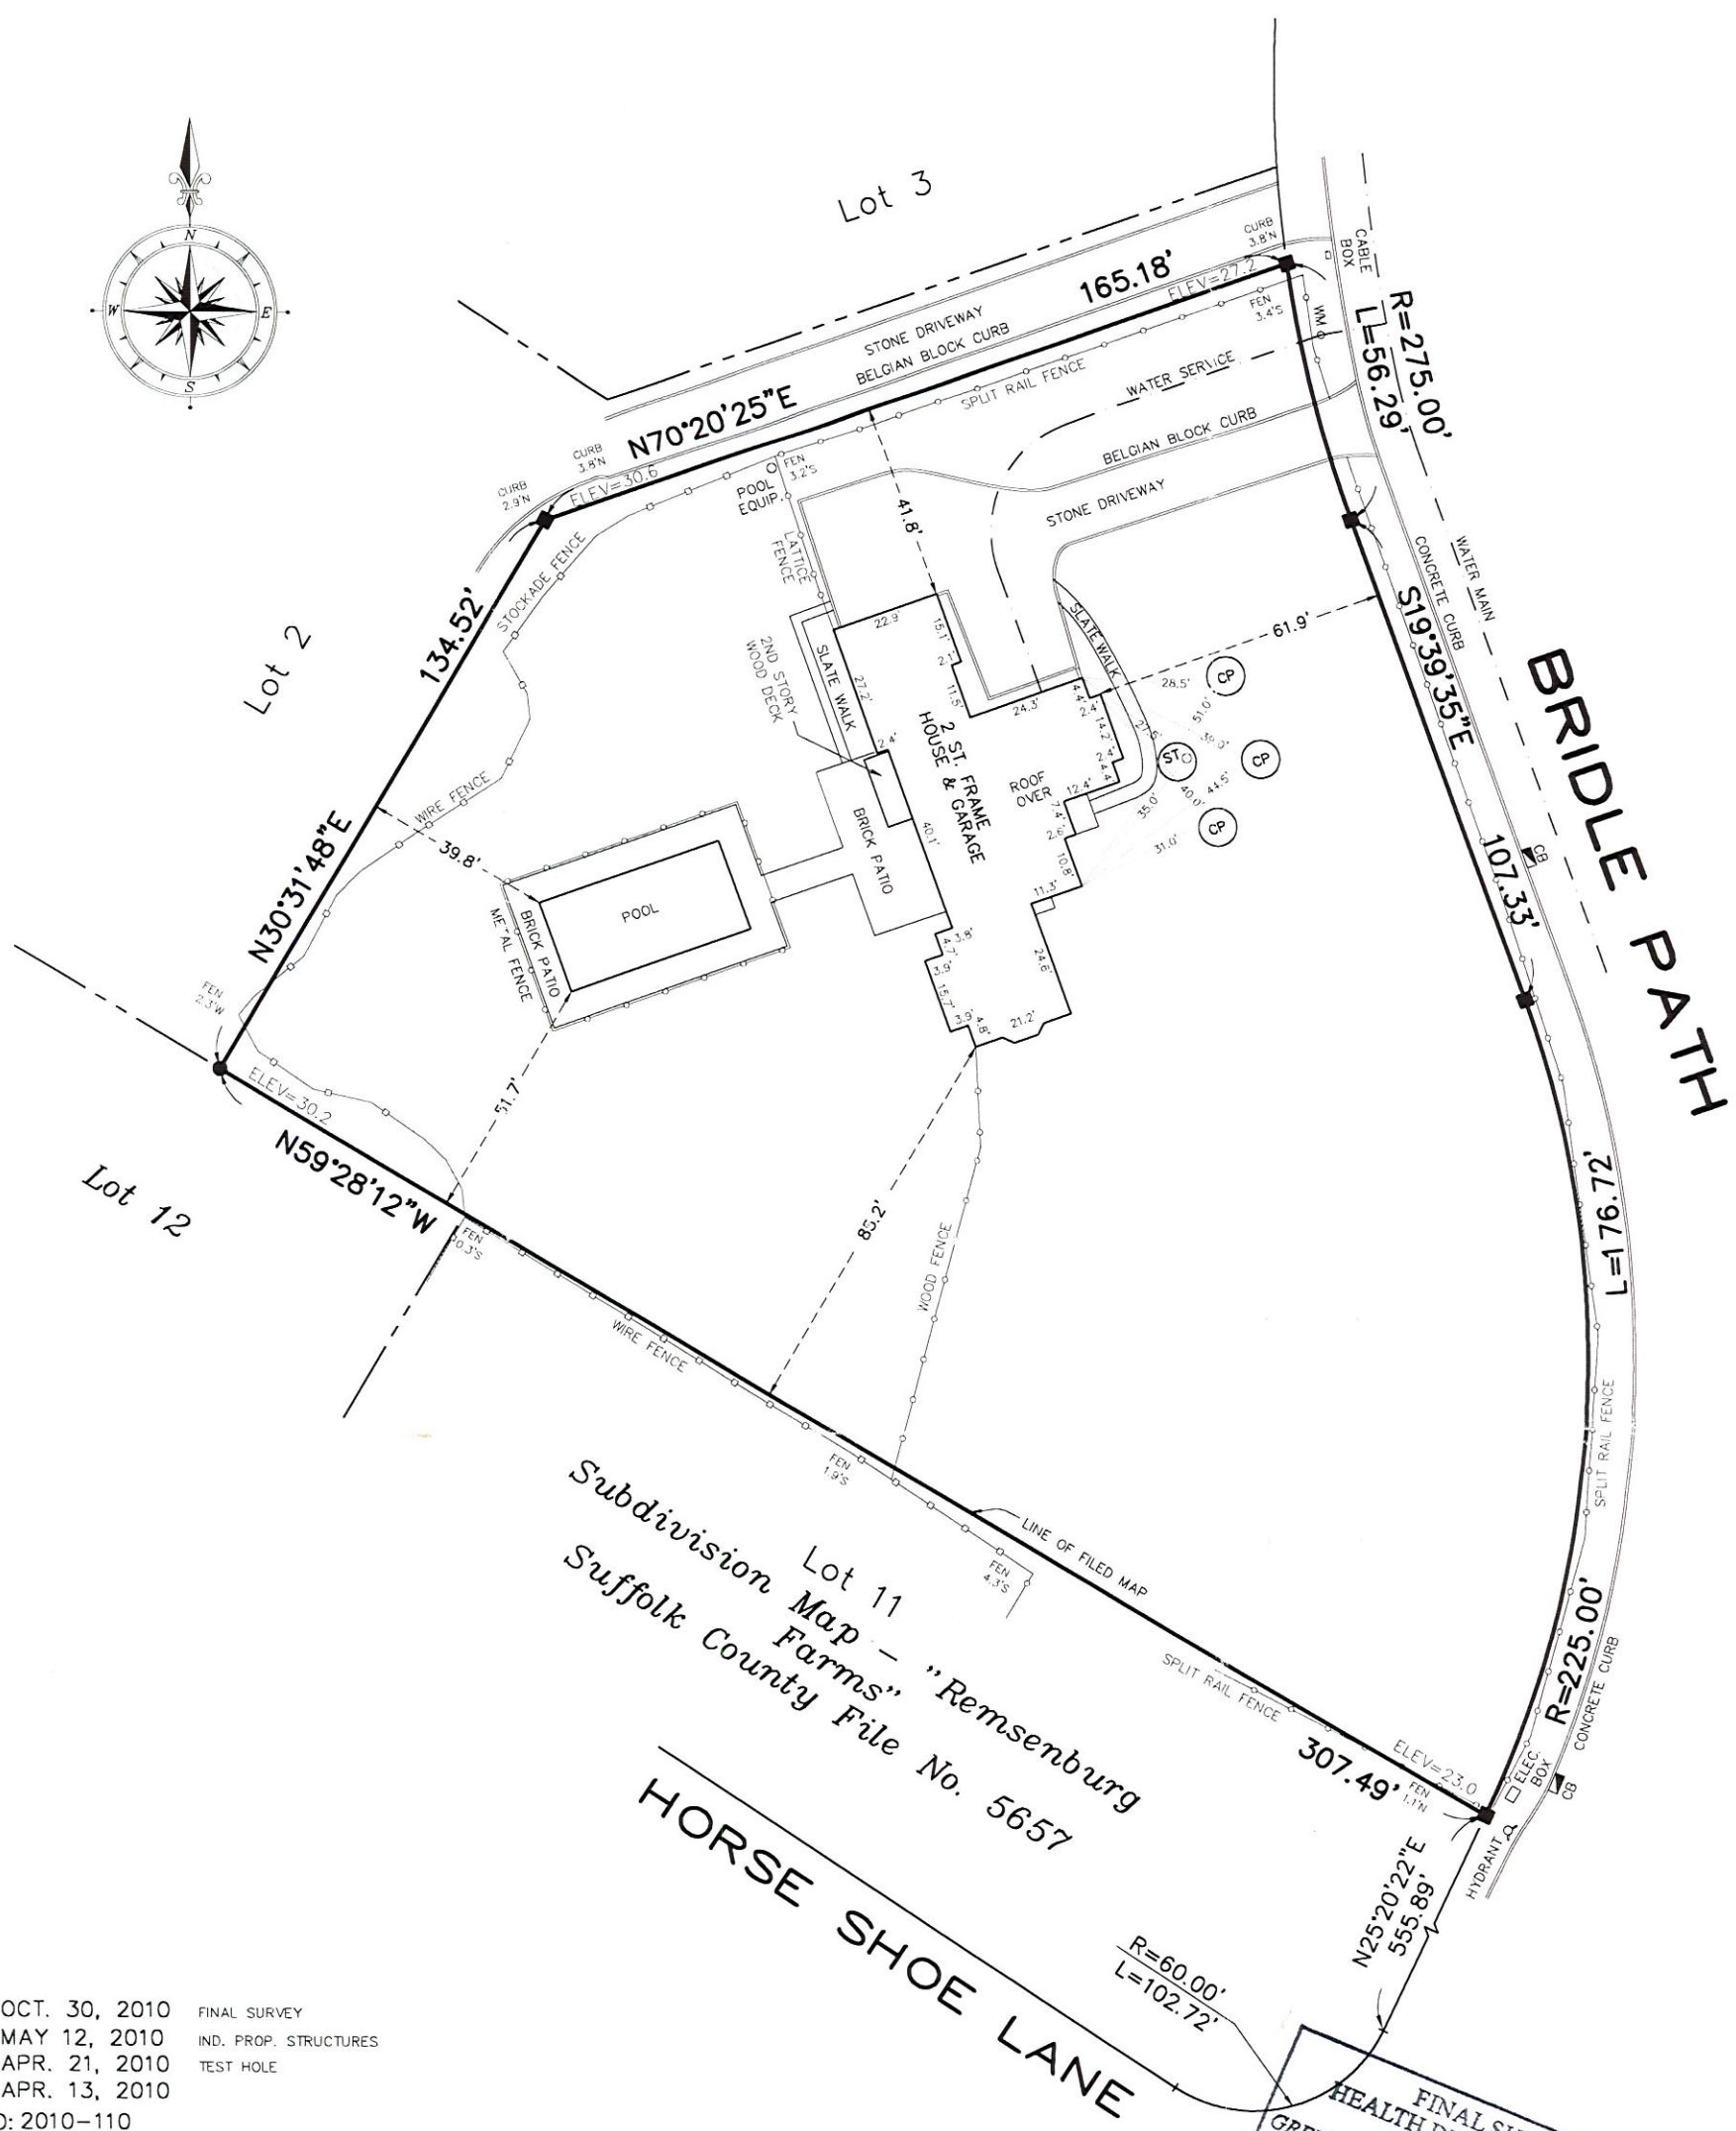


OCT. 30, 2010 FINAL SURVEY
 MAY 12, 2010 IND. PROP. STRUCTURES
 APR. 21, 2010 TEST HOLE
 DATE: APR. 13, 2010
 JOB NO: 2010-110

CERTIFIED TO:
 ROBERT SCHUMACHER
 CATHERINE SCHUMACHER
 WELLS FARGO BANK, N.A.
 STEWART TITLE INSURANCE COMPANY

DAVID H. FOX, L.S. P.C. N.Y.S.L.S. #50234
FOX LAND SURVEYING
 64 SUNSET AVENUE
 WESTHAMPTON BEACH, N.Y. 11978
 (631) 288-0022

Survey for:
ROBERT SCHUMACHER
& CATHERINE SCHUMACHER
 Lot 1, "Remsenburg Acres"
 At
 Remsenburg
 Town of
 Southampton
 Suffolk County, New York
 S.C.T.M.: 0900-368.00-05.00-001.000

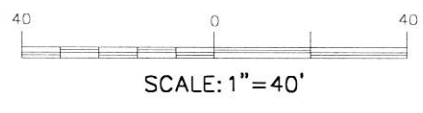

- NOTES:
1. AREA = 53,844 S.F.
 2. ■ = MONUMENT FOUND, ▲ = STAKE FOUND,
 3. SUBDIVISION MAP "REMSENBURG ACRES" FILED IN THE OFFICE OF THE CLERK OF SUFFOLK COUNTY ON APR. 2, 1979 AS FILE NO. 6800.

FINAL SURVEY WITH
 HEALTH DEPARTMENT APPROVAL
 GREEN STAMP DOES NOT SHOW WHEN SCANNED

209-10-0169

SUFFOLK COUNTY DEPARTMENT OF HEALTH SERVICES
 APPROVAL OF CONSTRUCTED WORKS FOR
 A SINGLE FAMILY RESIDENCE
 Date NOV 22 2010 H.S. Ref. No. 209-10-0169
 The sewage disposal and water supply facilities at this location have been
 inspected and/or certified by this Department or other agencies and found to
 be satisfactory FOR A MAXIMUM OF 6 BEDROOMS.
 Walter J. Hilbert, P.E., Chief
 Office of Wastewater Management