


STREET ADDRESS: 910 NEW SUFFOLK AVENUE

NEW SUFFOLK AVENUE

N 88°29'00" E 60.00'

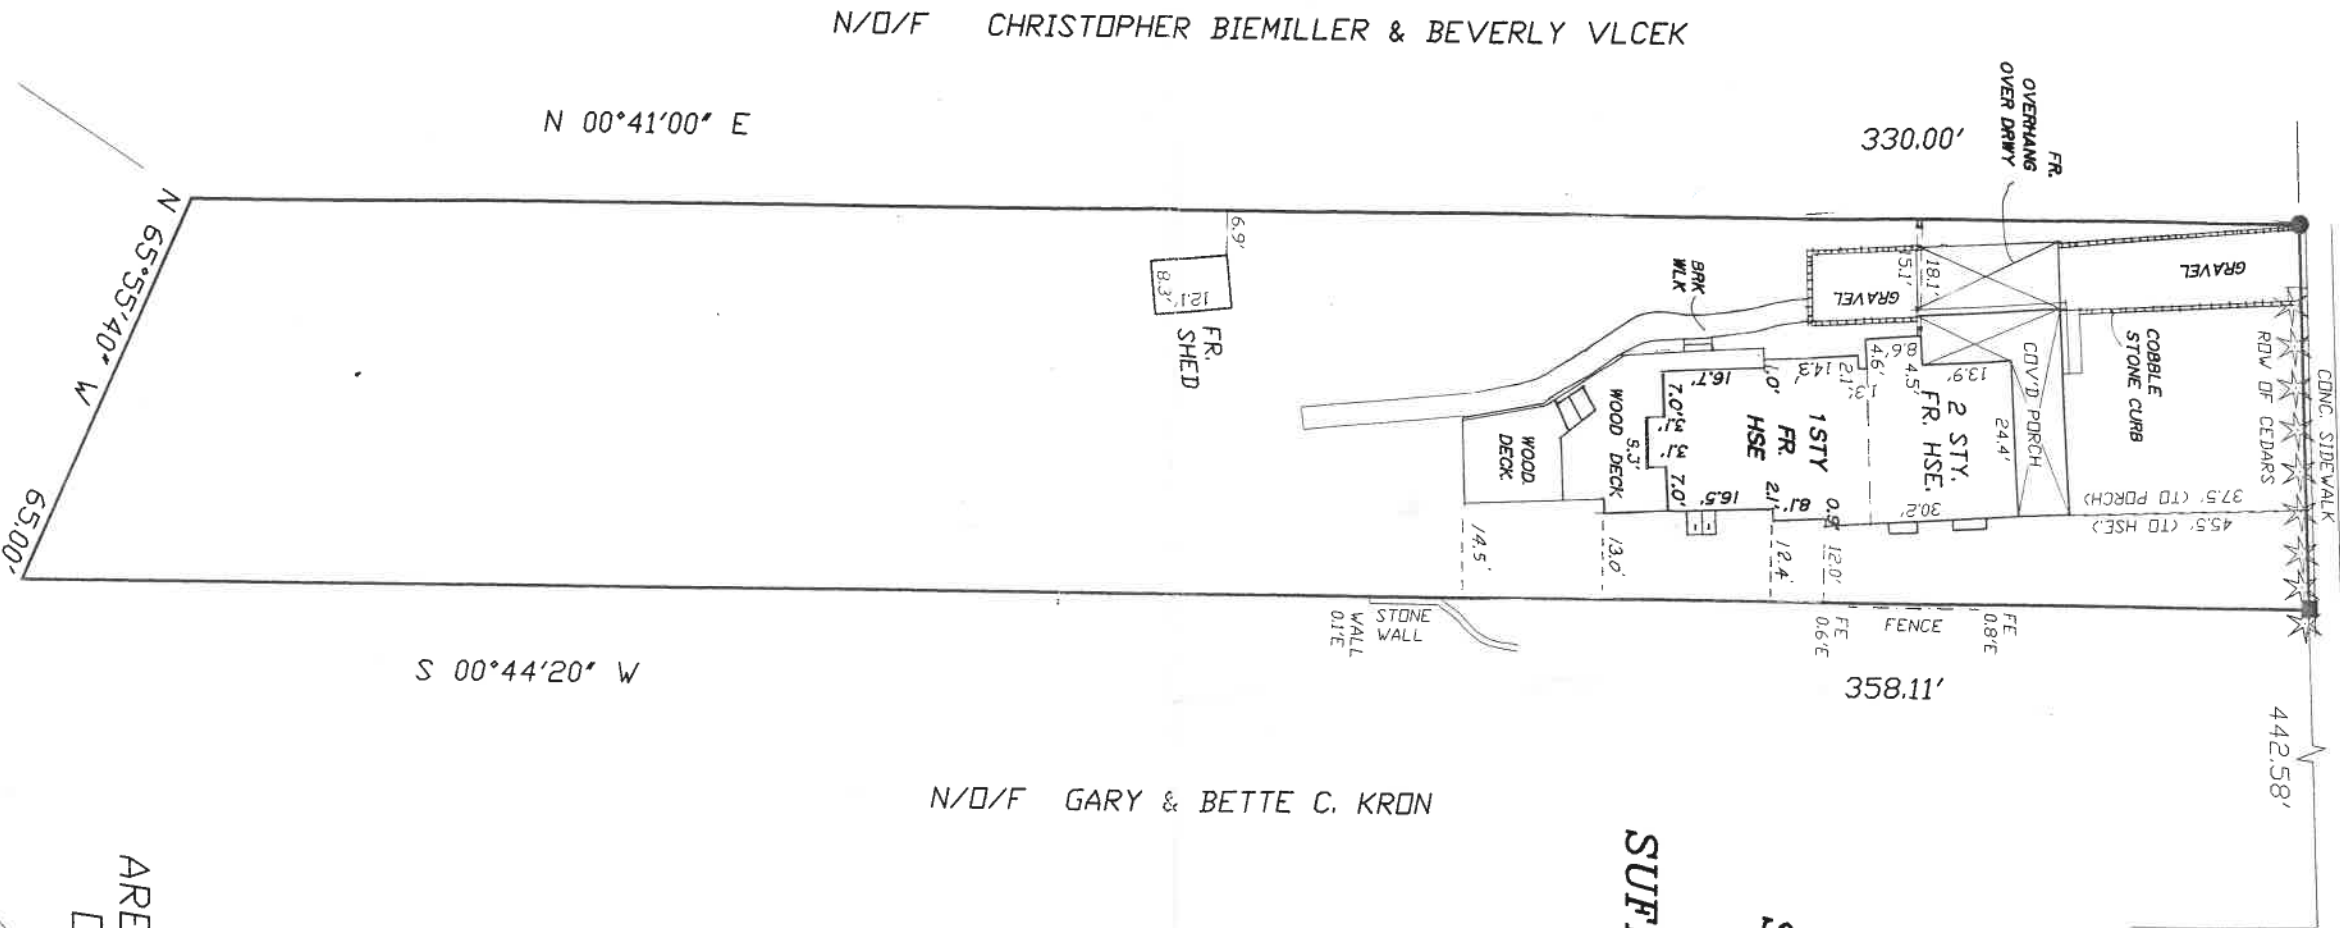

OLEJULE LANE

SURVEY OF PROPERTY
AT MATTTUCK
TOWN OF SOUTHD
SUFFOLK COUNTY, NEW YORK

1000-114-12-08
SCALE: 1"=30'
JAN. 29, 2002
FEB. 1, 2002 (prop. addition)
OCT. 3, 2006 (FINAL)

N/O/F GARY & BETTE C. KRON

N/O/F CHRISTOPHER BIEMILLER & BEVERLY VLCEK

N 00°41'00" E

S 00°44'20" W

AREA=20,579 S.F.
OR 0.4724 ACRES

■=MONUMENT
●=SPIKE

ANY ALTERATION OR ADDITION TO THIS SURVEY IS A VIOLATION
OF SECTION 7209 OF THE NEW YORK STATE EDUCATION LAW,
EXCEPT AS PER SECTION 7209-SUBDIVISION 2. ALL CERTIFICATIONS
HEREON ARE VALID FOR THIS MAP AND COPIES THEREOF ONLY IF
SAID MAP OR COPIES BEAR THE IMPRESSED SEAL OF THE SURVEYOR
WHOSE SIGNATURE APPEARS HEREON.

STATE OF NEW YORK
JOHN T. METZGER
REC'D SURVEYORS, N.Y.S. 11997
P. O. BOX 909
1230 TRAVELER
SOUTHOLD, N.Y. 11971
02-103