


DISTRICT	0904
SECTION	007.00
BLOCK	02.00
PARCEL	005.003

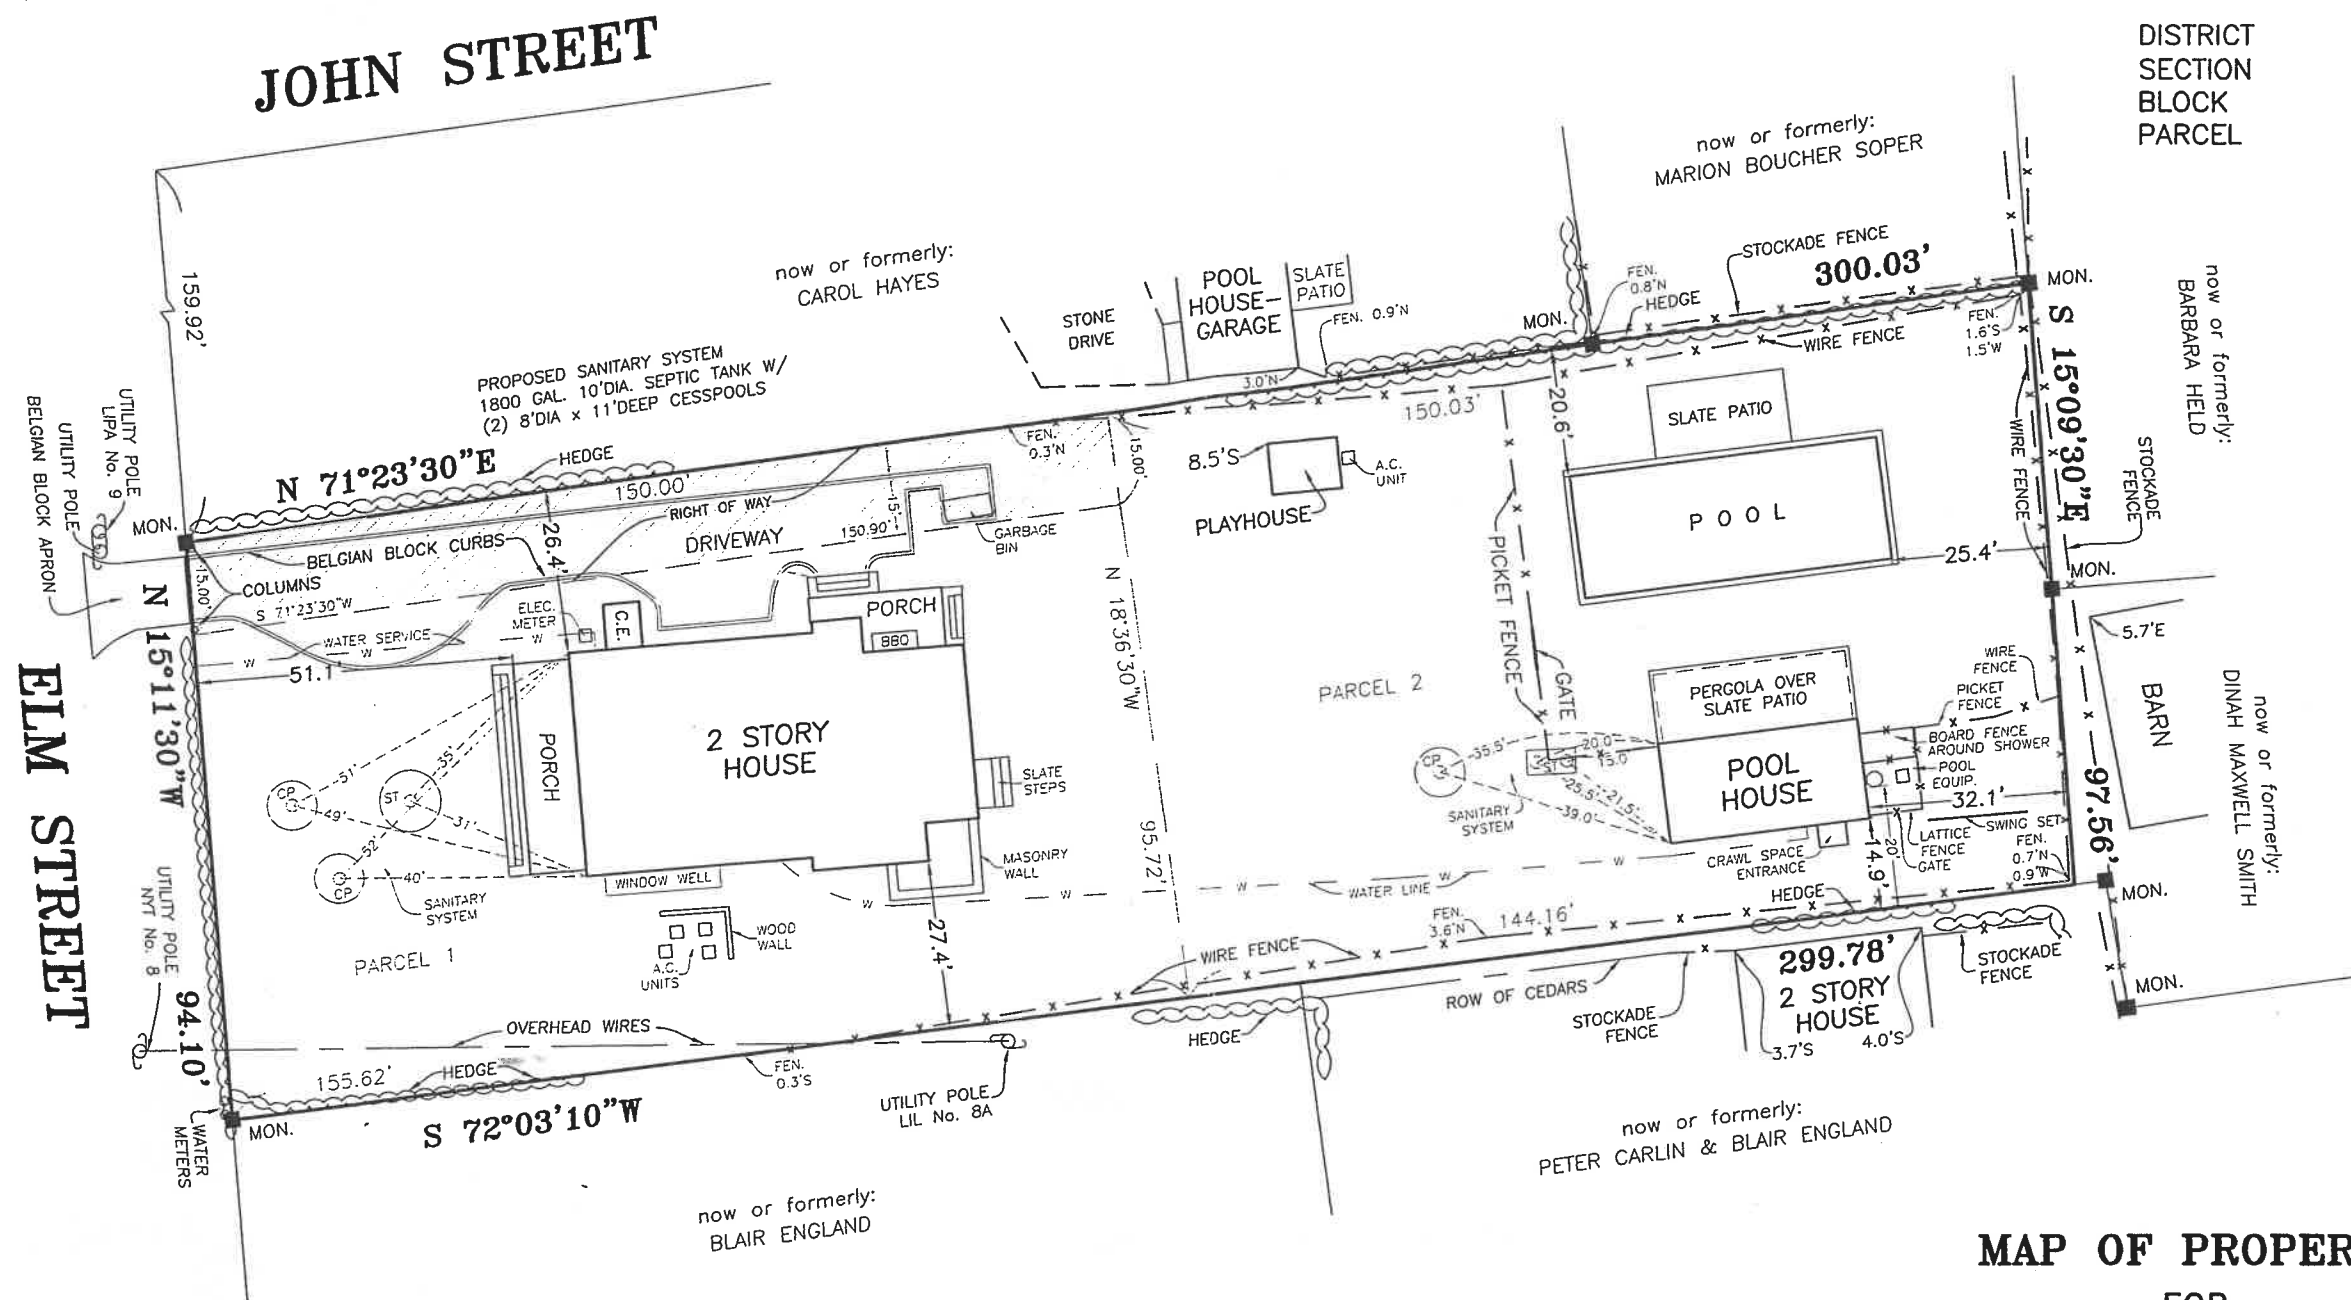

**MAP OF PROPERTY
FOR
82 ELM REALTY, LLC
SITUATE
INC. VILLAGE OF SOUTHAMPTON
TOWN OF SOUTHAMPTON
SUFFOLK COUNTY, NEW YORK**

AREA = 28,696 S.F. (0.659 ACRE)
SCALE: 1" = 30'

NOTES

1. SUBJECT PARCEL APPEARS AS PARCELS 1 & 2 ON THE MINOR SUBDIVISION FOR PETER & PHYLLIS KUBARYK.
2. WATER LINE LOCATIONS SHOWN ARE AS MARKED OUT BY OTHERS.
3. SANITARY SYSTEM LOCATIONS FOR MAIN HOUSE SHOWN AS PER BUILDER.

REVISED: JULY 28, 2011 (FINAL ON IMPROVEMENTS)
REVISED: JULY 16, 2010 (SAN. DIM.)
REVISED: JULY 13, 2010 (WATER LINES)
SURVEYED: SEPTEMBER 16, 2009

THOMAS D. BURKE, L.S. No. 50325
S. H. W. AND S., LAND SURVEYORS, P.C.
SQUIRES, HOLDEN, WEISENBACHER & SMITH
LAND SURVEYING ~ LAND PLANNING ~ ENGINEERING
SOUTHAMPTON ~ NEW YORK