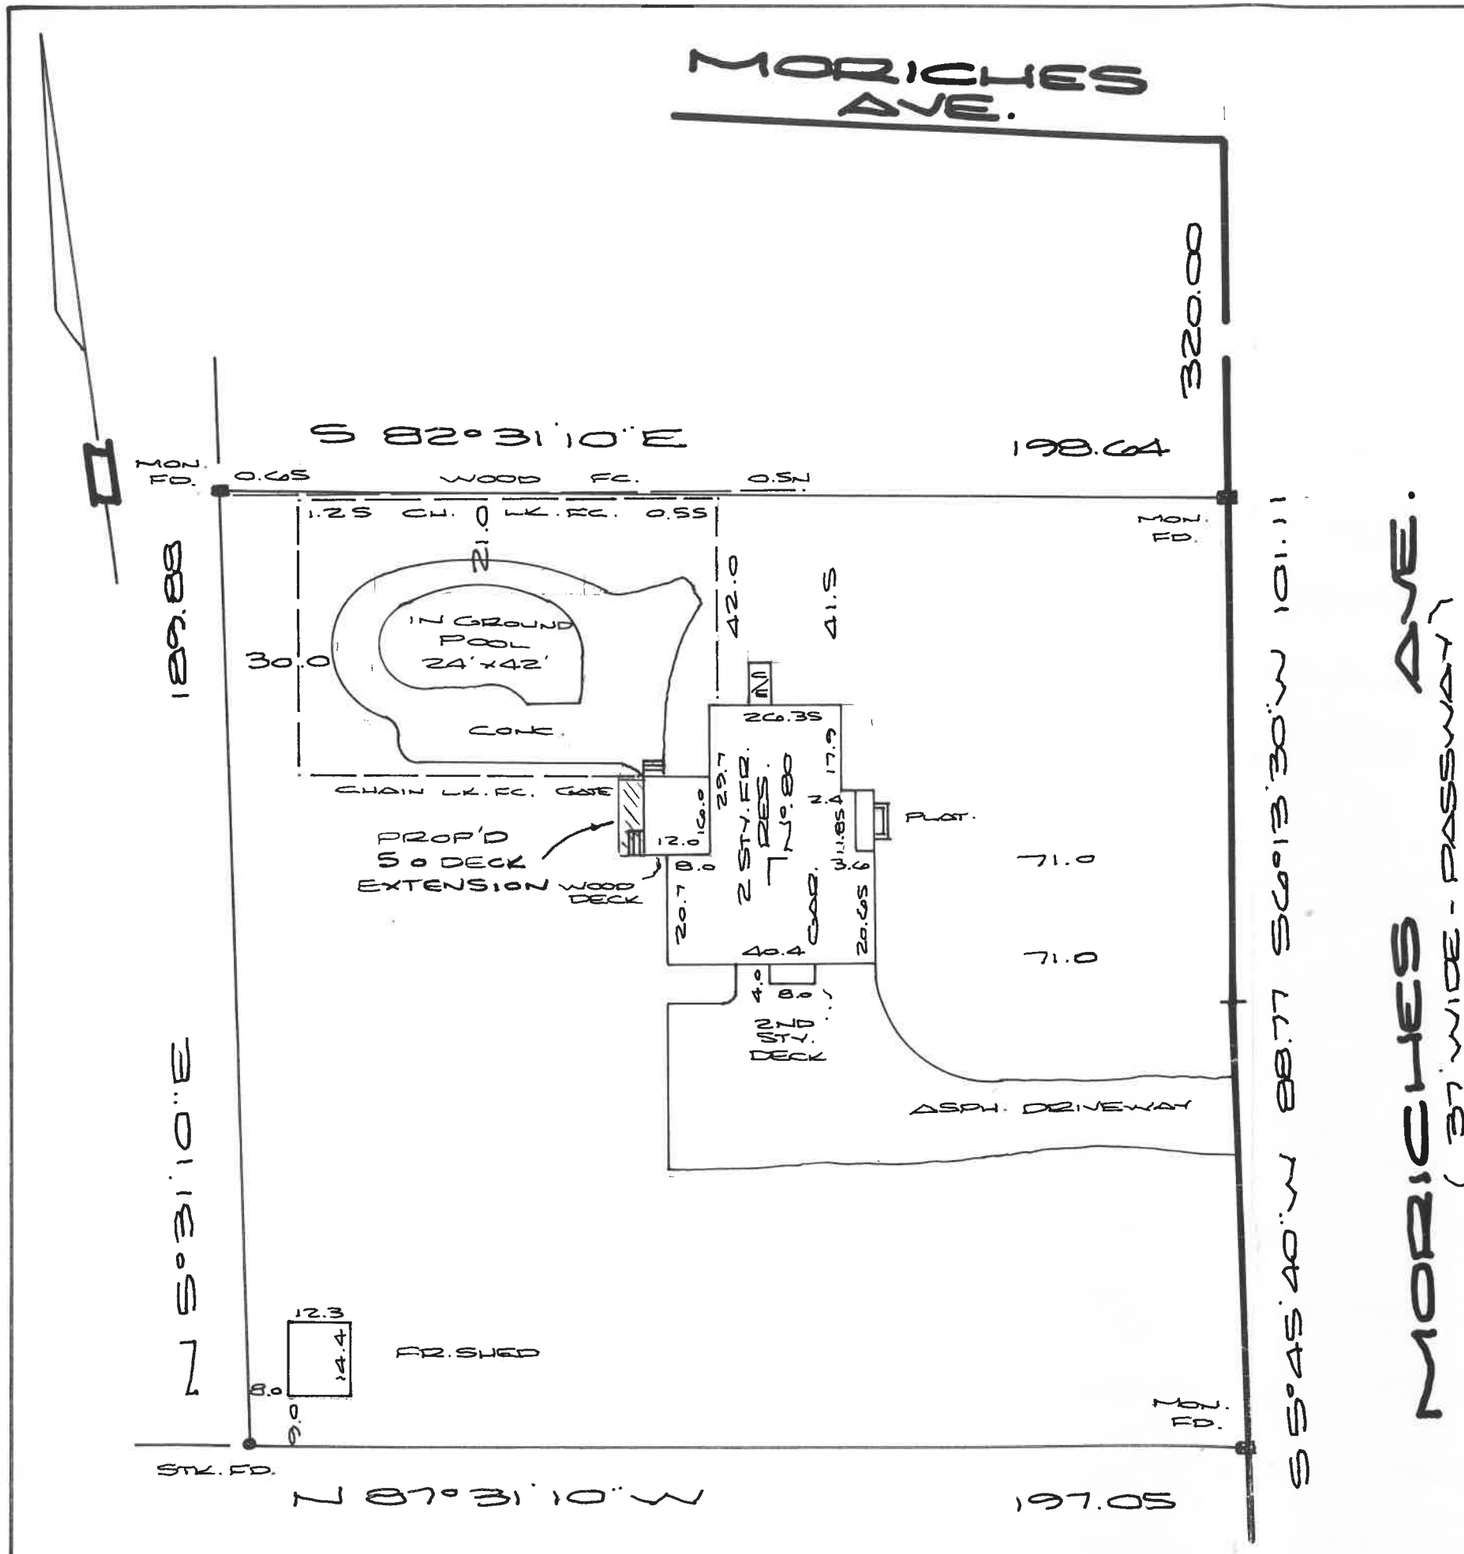

MAP OF
DESCRIBED PROPERTY
LOCATED AT
EAST MORICHES
TOWN OF BROOKHAVEN
SUFFOLK CO. - N.Y.

0200 - 889 - 03 - 23

SURVEYED: APR. 27, 2009

GUAR. TO: LISA NIELSEN

STATE OF NEW YORK
MICHAEL K. WICKS
LICENSED LAND SURVEYOR

MICHAEL K. WICKS
LAND SURVEYOR NYS LIC.
P.O. BOX 493 - LINDENHURST, N.Y.
(631) - 874 - 0156 11757

SCALE 1" = 30'