


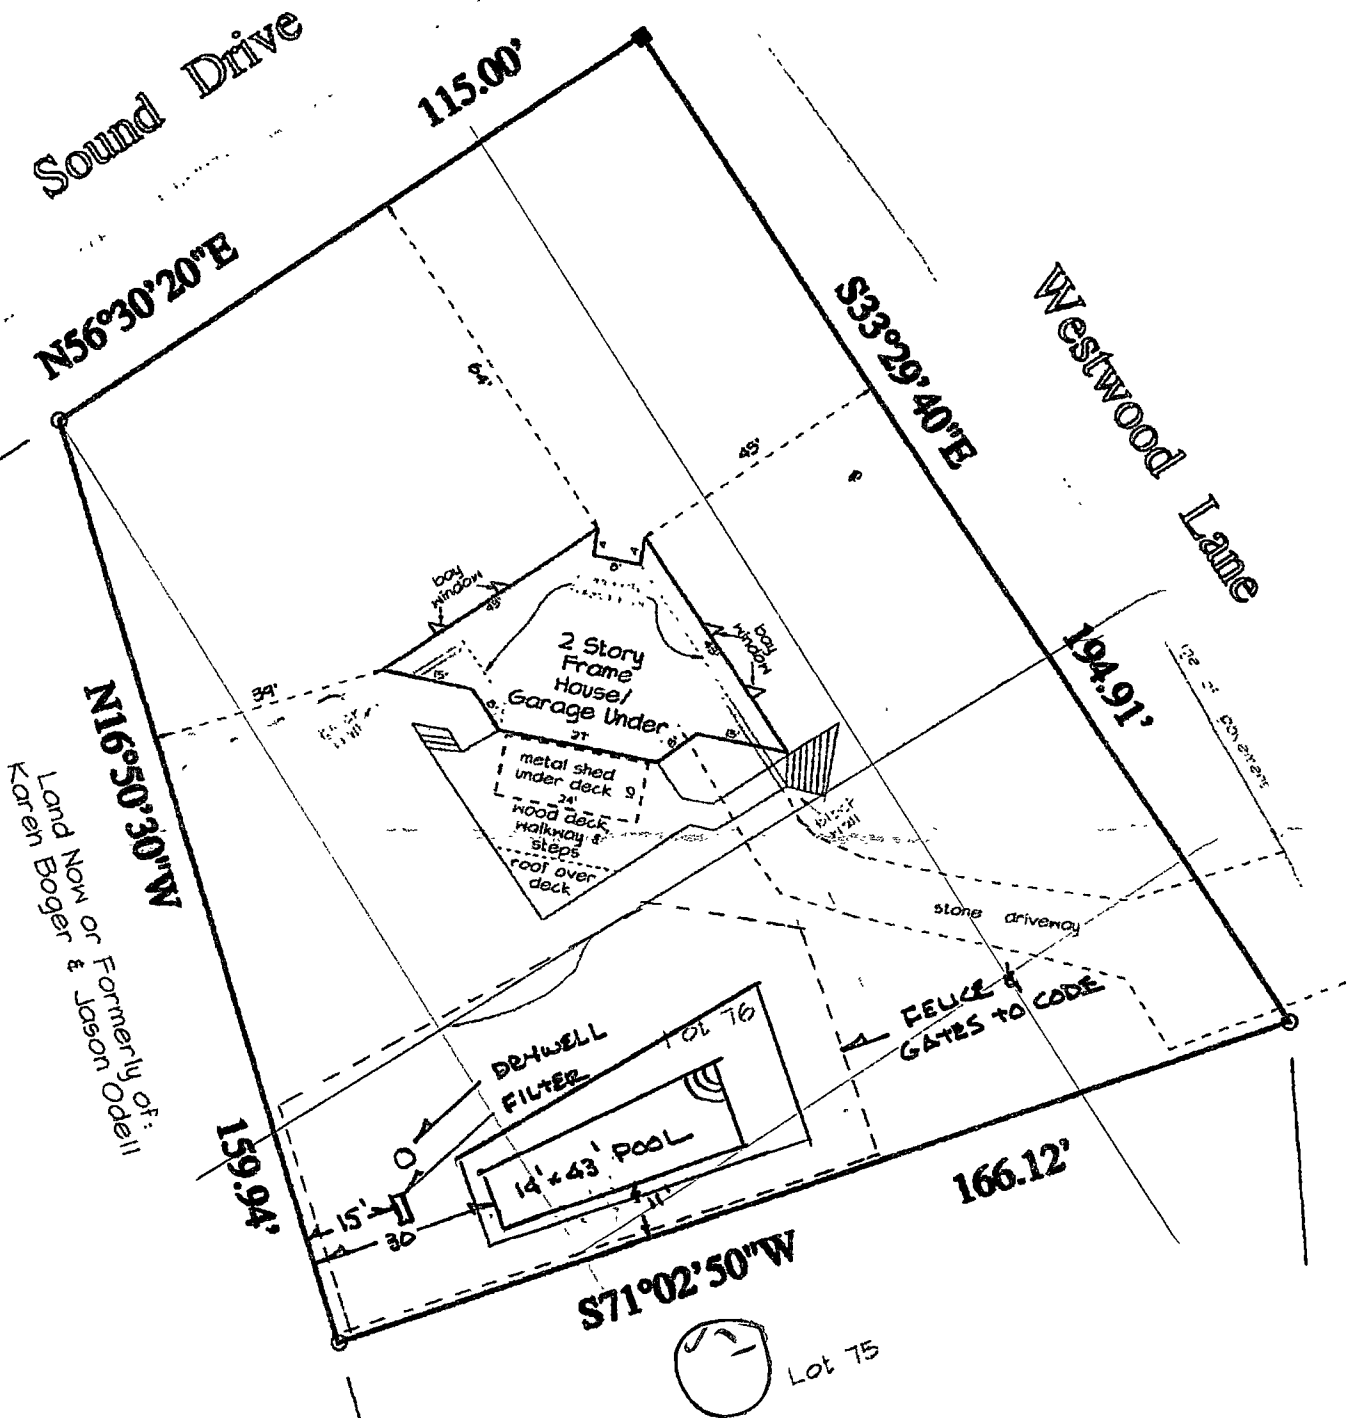

MR & MRS PETRAKIS
2515 SOUND DR.
GREENPORT N.Y.
(631) 477-5968