


TAX MAP NO. 900-131-03-11
 AREA = 15,000 S.F.
 ZONE R-20

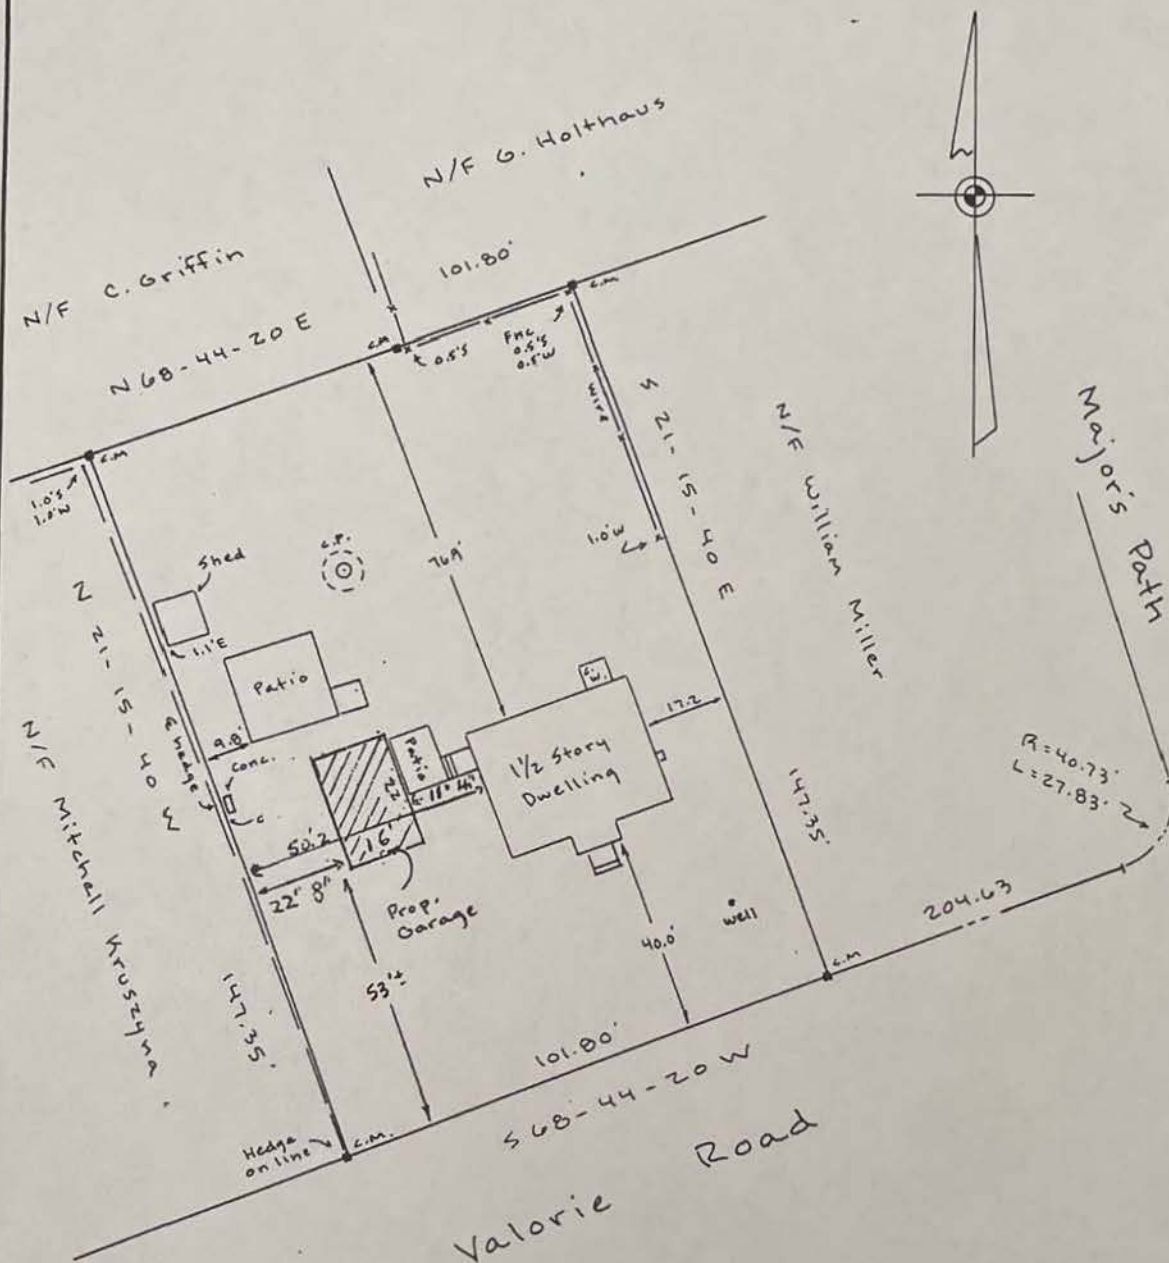

**SURVEY OF PROPERTY
 SITUATE**

Valorie Road
Southampton

TOWN OF SOUTHAMPTON
 SUFFOLK COUNTY, NEW YORK

CERTIFIED TO:

Constantine Colyvas



PREPARED 7-7-98 SURVEYED July 6, 1998

SCALE 1" = 30'

■ DENOTES MONUMENTS

▲ DENOTES STAKES

BK 176 PG 15

UNAUTHORIZED ALTERATION OR ADDITION TO THIS SURVEY IS A VIOLATION OF SECTION 7908 OF THE NEW YORK STATE EDUCATION LAW.

COPIES OF THIS SURVEY MAP NOT BEARING THIS LAND SURVEYOR'S INKED SEAL OR EMBOSSED SEAL SHALL NOT BE CONSIDERED TO BE A VALID TRUE COPY.

GUARANTEES INDICATED HEREON SHALL RUN ONLY TO THE PERSON FOR WHOM THE SURVEY IS PREPARED AND ON HIS BEHALF TO THE TITLE COMPANY, GOVERNMENTAL AGENCY AND TO THE ASSIGNEES OF THE LENDING INSTITUTION. GUARANTEES ARE NOT TRANSFERABLE TO ADDITIONAL INSTITUTIONS OR SUBSEQUENT OWNERS.

R.O.N. EASEMENTS, AND UNDERGROUND UTILITIES WHETHER ABANDONED OR IN USE UNLESS OTHERWISE NOTED ARE NOT SHOWN ON THIS SURVEY.

DOLLIVER ASSOCIATES
 LAND SURVEYORS
 HAMPTON BAYS, N. Y.