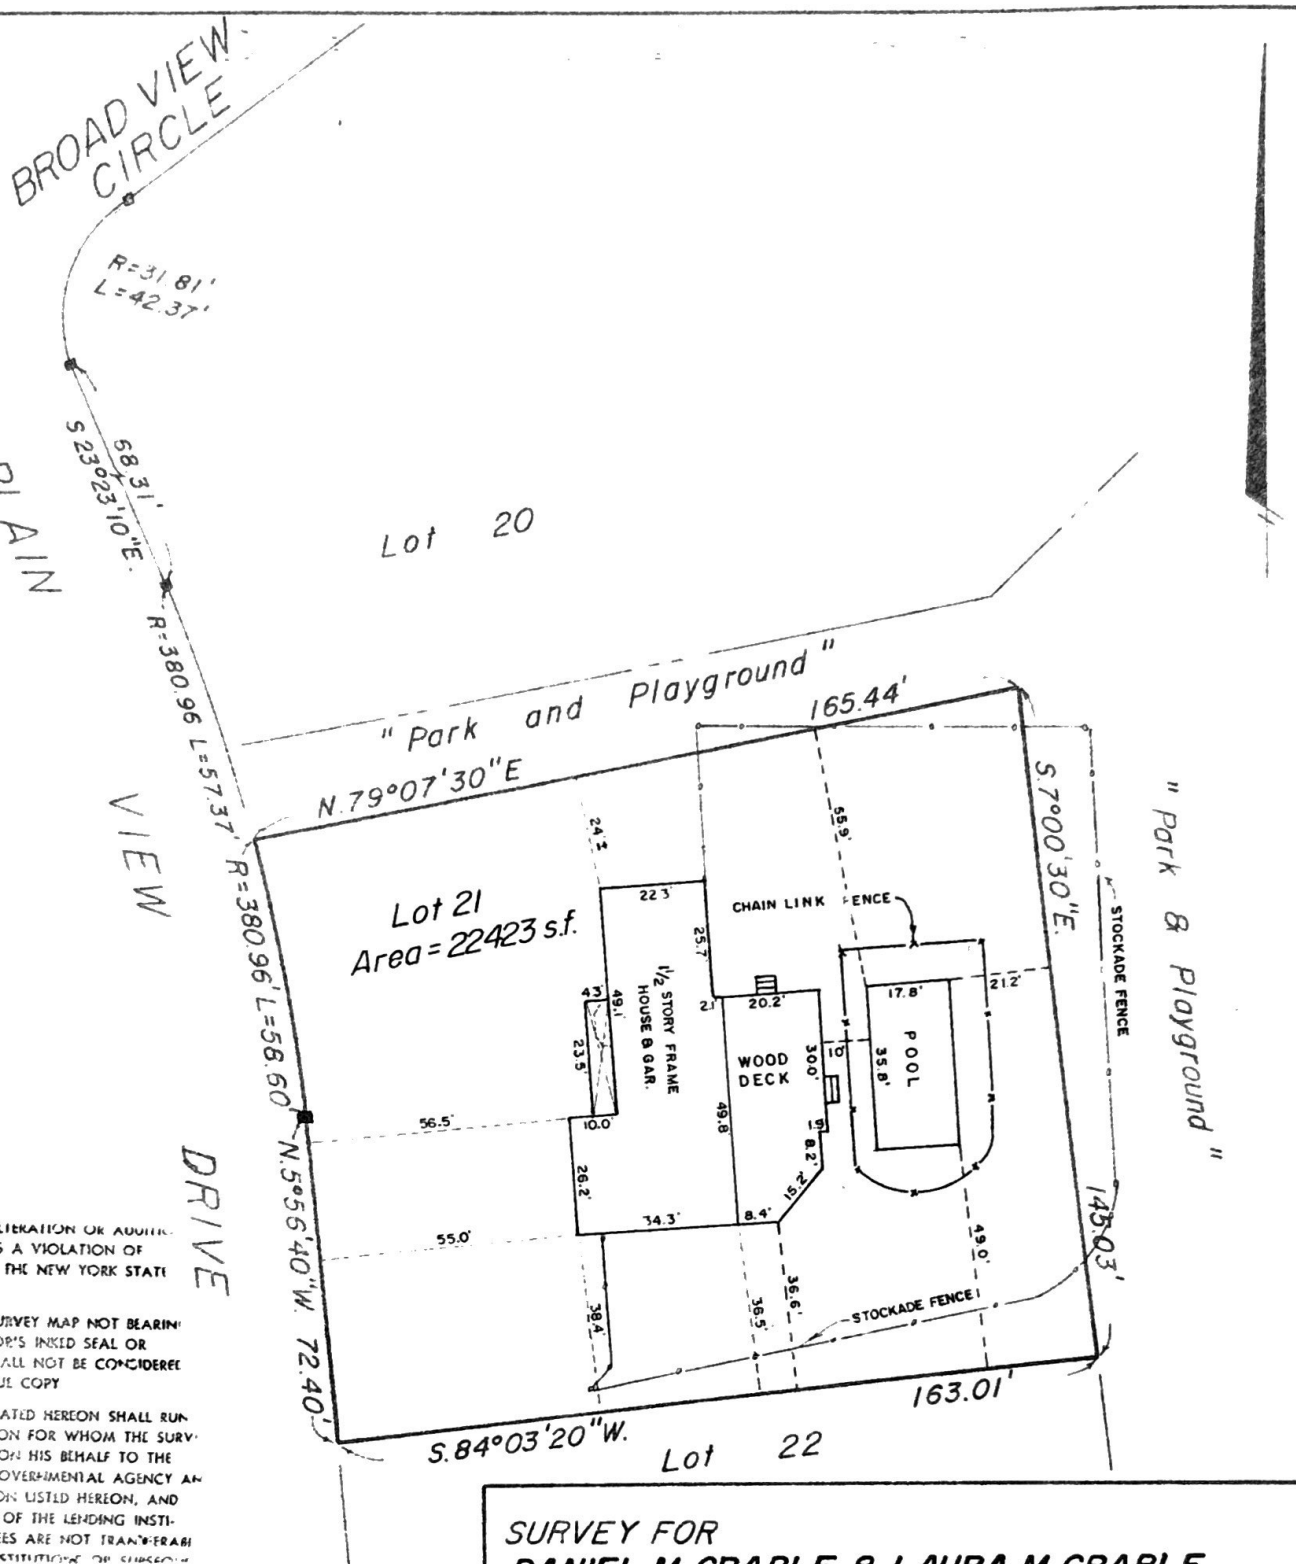

UNAUTHORIZED ALTERATION OR ADDITION TO THIS SURVEY IS A VIOLATION OF SECTION 7209 OF THE NEW YORK STATE EDUCATION LAW.

COPIES OF THIS SURVEY MAP NOT BEARING THE LAND SURVEYOR'S INKED SEAL OR EMBOSSED SEAL SHALL NOT BE CONSIDERED TO BE A VALID TRUE COPY

GUARANTEES INDICATED HEREON SHALL RUN ONLY TO THE PERSON FOR WHOM THE SURVEY IS PREPARED, AND ON HIS BEHALF TO THE TITLE COMPANY, GOVERNMENTAL AGENCY AND LENDING INSTITUTION LISTED HEREON, AND TO THE ASSIGNEES OF THE LENDING INSTITUTION. GUARANTEES ARE NOT TRANSFERABLE TO ADDITIONAL INSTITUTIONS OR SUBSEQUENT OWNERS.

NOTES:
1. ■ = MONUMENT
2. SUBDIVISION MAP FILED IN THE OFFICE OF THE CLERK OF SUFFOLK COUNTY ON FEB. 25, 1969 AS MAP NO. 5259
3. SUFFOLK CO. TAX MAP DIST. 600 SECT. 49 BL. 3 LOT 5

SURVEY FOR
DANIEL M. GRABLE & LAURA M. GRABLE
LOT 21 "TIDE WOODS"
WADING RIVER
TOWN OF RIVERHEAD
SUFF. CO., N.Y.

CERTIFIED TO
DANIEL M. GRABLE & LAURA M. GRABLE
LONG ISLAND SAVINGS BANK
CHICAGO TITLE INSURANCE COMPANY
(TITLE NO. 9108 : 02396)

Alden W. Young

DATE: AUG. 6, 1991
AUG. 10, 1989
SCALE: 1"-40'
NO. 89-0914

YOUNG & YOUNG
400 OSTRANDER AVE. RIVERHEAD, N.Y.
ALDEN W. YOUNG, N.Y.S. PE & L.S. LIC. NO. 12845
HOWARD W. YOUNG, N.Y.S. L.S. LIC. NO. 45893