

OLD FISH COVE ROAD

RECEIVED
SUFFOLK COUNTY
2003 FEB 25 AM 11:14
DEPT OF HEALTH SERVICES
OFFICE WASTEWATER MGMT

UNAUTHORIZED ALTERATION OR ADDITION TO
A SURVEY MAP BEARING A LICENSED LAND
SURVEYOR'S SEAL IS A VIOLATION OF SECTION
7209, SUB-DIVISION 2, OF THE NEW YORK
EDUCATION LAW.
COPIES OF THIS SURVEY MAP NOT BEARING THE
LAND SURVEYOR'S GREEN INKED SEAL OR EMBOSSED
SEAL SHALL NOT BE CONSIDERED TO BE A VALID
COPY.
NOTATIONS INDICATED HEREON SIGNIFY THAT
THIS SURVEY WAS PREPARED IN ACCORDANCE WITH
THE ETHICS CODE OF PRACTICE FOR LAND SURVEYS
ADOPTED BY THE NEW YORK STATE ASSOCIATION OF
PROFESSIONAL LAND SURVEYORS. SAID CERTIFICATIONS
SHALL RUN ONLY TO THE PERSON FOR WHOM THE
SURVEY IS PREPARED, AND ON HIS BEHALF TO THE
COMPANY, GOVERNMENTAL AGENCY AND LENDING
INSTITUTION LISTED HEREON, AND TO THE ASSIGNEE'S
OF THE LENDING INSTITUTION. CERTIFICATIONS ARE NOT
TRANSFERABLE TO ADDITIONAL INSTITUTIONS OR
SUBSEQUENT OWNERS.

MAP OF PROPERTY
FOR

**STEVEN M. & CATHY E.
KAUFMAN**

SITUATE

NORTH SEA

TOWN OF SOUTHAMPTON
SUFFOLK COUNTY, N.Y.

SCALE : 1" = 50'

AREA = 32,953 Sq. Ft. (0.756 Acres)

SUFFOLK COUNTY TAX MAP NO.

DISTRICT 0900


SECTION 077.00

BLOCK 03.00

PARCEL 037.00

CERTIFIED TO :
STEVEN M. KAUFMAN
CATHY E. KAUFMAN
ULSTER SAVINGS BANK
WASHINGTON TITLE INS. CO.

BOOK - PAGE
457 87
776 10

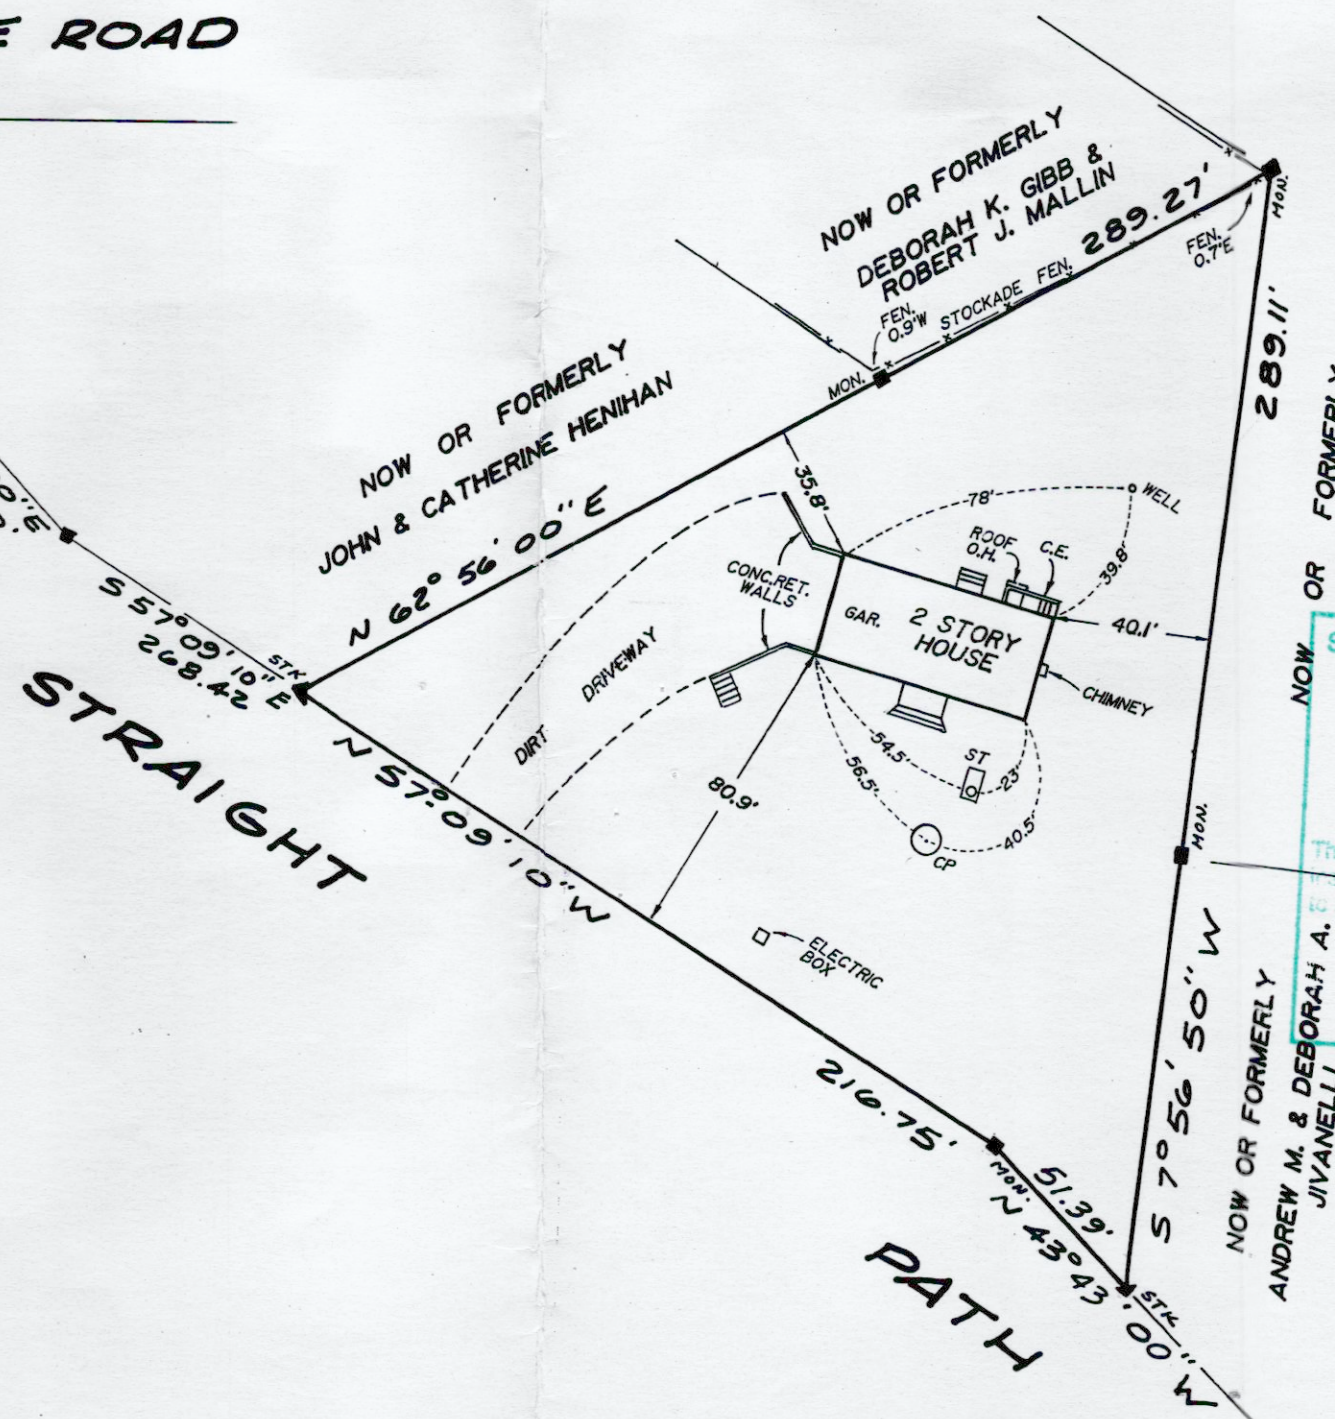

SUFFOLK COUNTY DEPARTMENT OF HEALTH SERVICES

APPROVAL OF CONSTRUCTED WORKS FOR
A SINGLE FAMILY RESIDENCE

Date **MAR 13 2003** H.H. Ref. No. **R09 01 0428**

The sewage disposal and water supply facilities at this location have been
inspected and/or certified by this Department or other agencies and found
to be satisfactory FOR A MAXIMUM OF 4 BEDROOMS.

Stephen A. Costa
Stephen A. Costa, P.E., Chief
Office of Wastewater Management

NOTE: SANITARY LOCATIONS
AS PER BUILDER. WELL
LOCATED IN FIELD.

REVISED: FEB. 4, 2003 (FINAL)
SURVEYED: SEPT. 17, 2002 (U.C.)

Robert A. Smith
ROBERT A. SMITH, L.S. NO. 49239
S.H.W. & S., LAND SURVEYORS, P.C.
SQUIRES, HOLDEN, WEISENBACHER

LAND SURVEYORS & ENGINEERS
SOUTHAMPTON, N.Y.