


MC 7066
A149

Sari Agatston

AVERAGE GRADE AROUND GAZEBO = 45.1'
GAZEBO HEIGHT = 58.9-45.1 = 13.8'

#9040
37 CROSS Hwy.

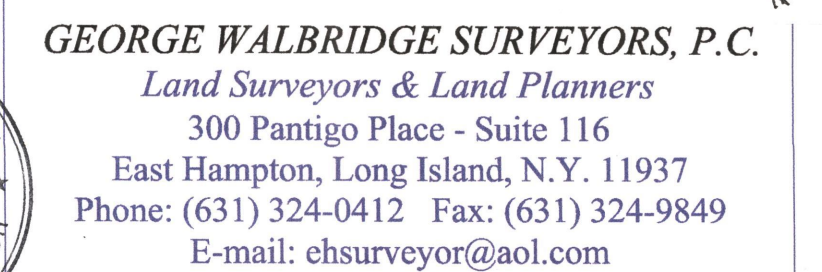

DR

c:\land project\agatston_arthur\dwg\survey_11-19-14