



**SURVEY OF PROPERTY
AT ORIENT
TOWN OF SOUTHDOLD
SUFFOLK COUNTY, N.Y.**

1000-13-02-8.16

SCALE: 1"=60'

SEPT. 5, 2002 (survey & fndtn. loc.)

OCT. 9, 2002 (certification)

FEB. 26, 2004 (final)

SUFFOLK COUNTY DEPARTMENT OF HEALTH SERVICES

APPROVAL OF CONSTRUCTED WORKS FOR
A SINGLE FAMILY RESIDENCE

Date MAY 04 2004 H.S. Ref. No. R10000081

The sewage disposal and water supply facilities at this location have been
inspected and/or certified by this Department or other agencies and found to
be satisfactory FOR A MAXIMUM OF 4 BEDROOMS.

Walter J. Hilbert, P.E., Chief
Office of Wastewater Management

	B	C
WELL	150'	100'

	A	B	
1	52'	30.5'	SEPTIC TANK
2	71'	42'	LEACHING POOL
3	22.5'	30'	CATCH BASIN
4	32.5'	62.5'	DRYWELL

NOTE:


"SUBDIVISION MAP OF HILL CREST ESTATES,
SECTION 1" FILED IN THE SUFFOLK COUNTY
CLERK'S OFFICE ON AUG. 15, 1983 AS FILE
7218.

CERTIFIED TO:

ALVIN BERMAN
ELLEN BUCHBINDER - BERMAN
WEBSTER BANK
COMMONWEALTH LAND TITLE INSURANCE COMPANY

ANY ALTERATION OR ADDITION TO THIS SURVEY IS A VIOLATION
OF SECTION 7000 OF THE NEW YORK STATE EDUCATION LAW.
EXCEPT AS FOR SECTION 7000-SUBDIVISION 2. ALL CERTIFICATIONS
HEREON ARE VALID FOR THIS MAP AND COPIES THEREOF ONLY IF
THIS MAP OR COPIES BEAR THE DEPOSED SEAL OF THE SURVEYOR
WHOSE SIGNATURE APPEARS HEREON.

AREA=75,471 SF.
TO TIE LINE

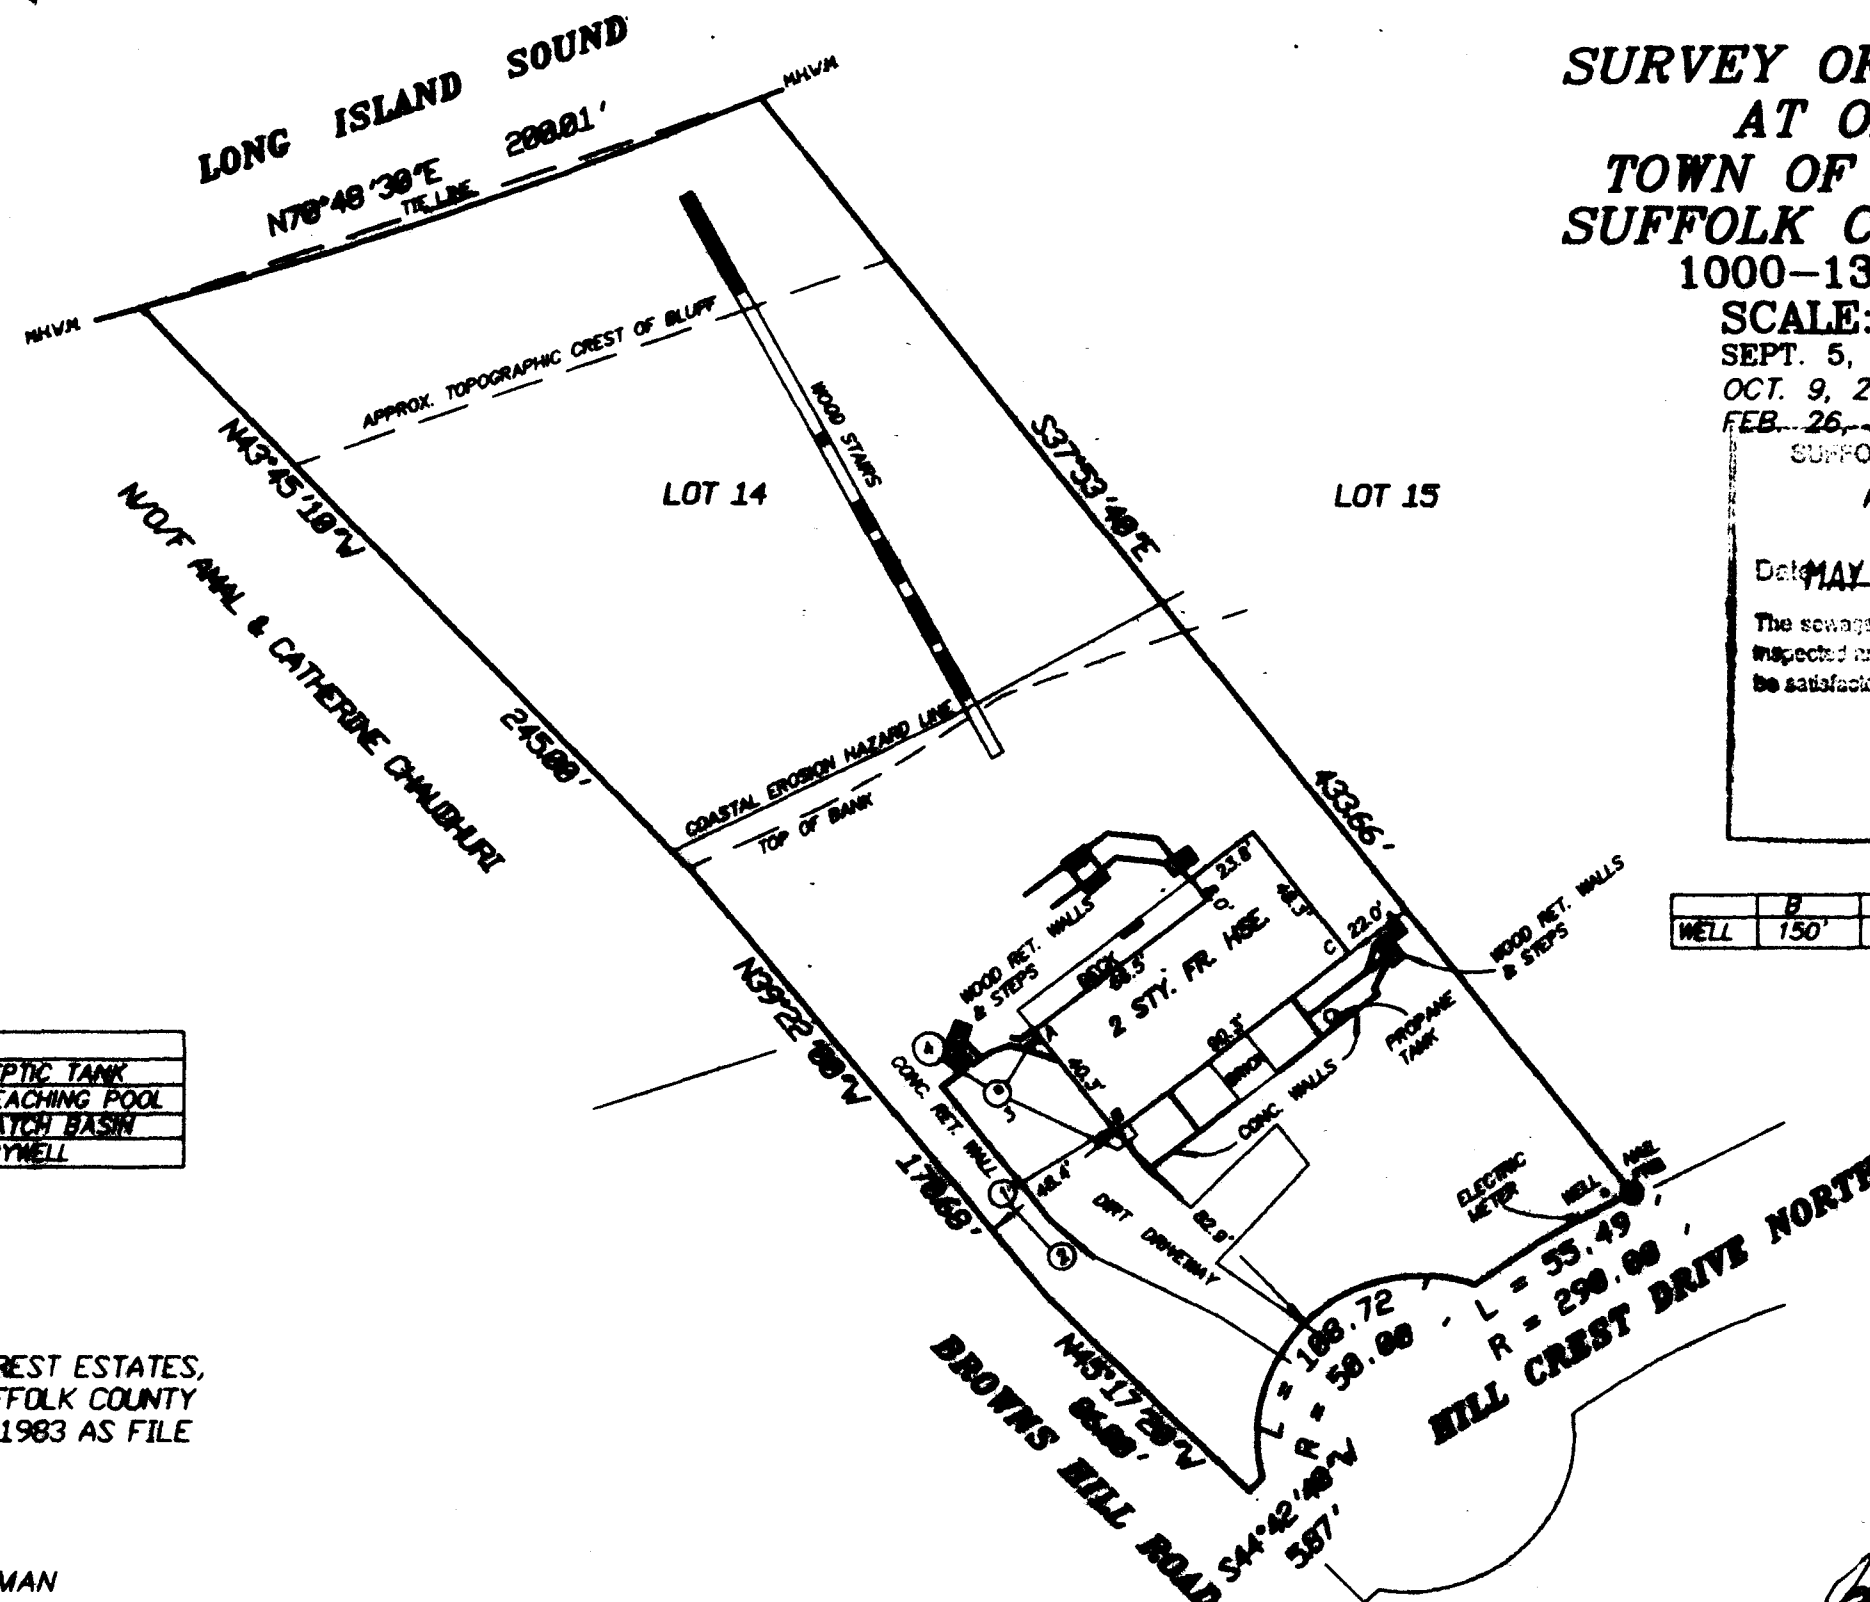

STATE OF NEW YORK
JOHN T. METZGER
N.Y.S. DEC. NO. 49618
PECONIC SURVEYORS, P.C.
(631) 765-5820 FAX (631) 765-1797
P. O. BOX 500 No. 49618
1230 TRAVELMAN DRIVE
SOUTHDOLD, N.Y. 11971

02-267

RECEIVED
SUFFOLK COUNTY
MAR-2 2004