


4.20/70. ENJOYING 101 COVERED
 HOUSE - 3485 S.A.F.
 3485 ± 21,000 x 100 = 3,9170
 (3485 + 800) ÷ 29,000 x 100
 = 4.8170

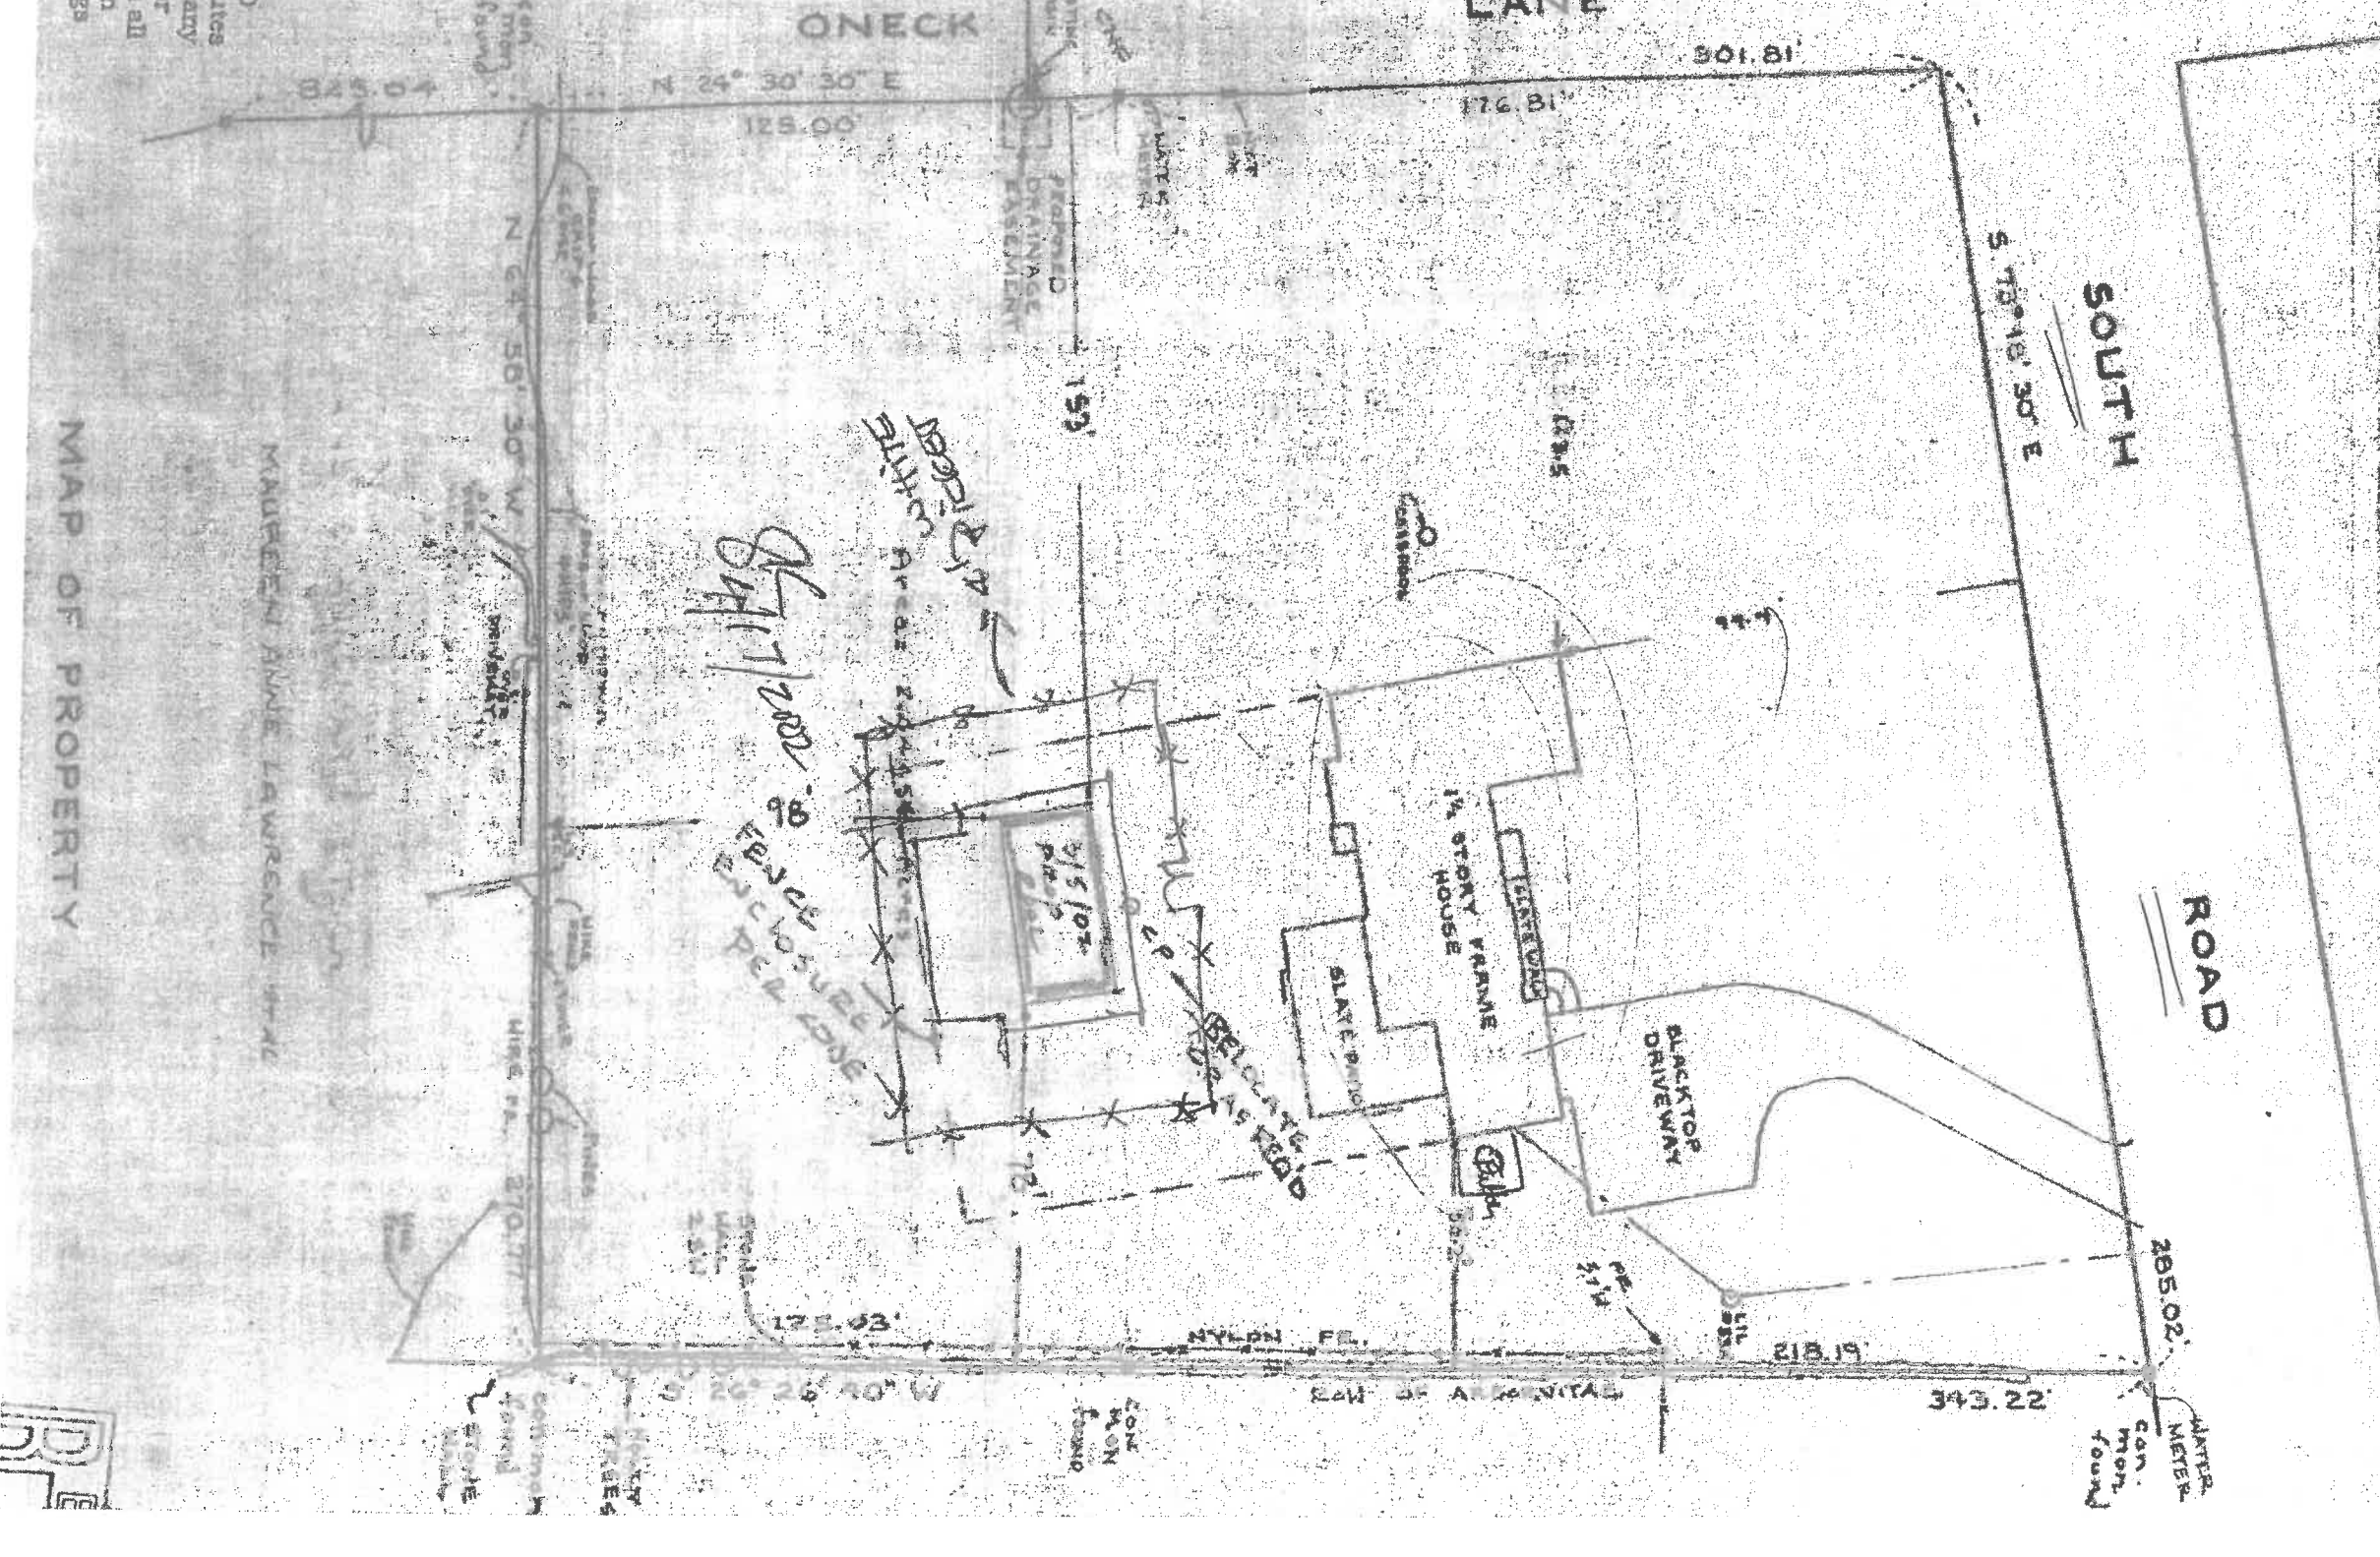

MAP OF PROPERTY