

SUFFOLK COUNTY DEPARTMENT OF HEALTH SERVICES
 APPROVAL OF CONSTRUCTED WORKS FOR
 A SINGLE FAMILY RESIDENCE
 Date SEP 16 1998 U.S. Ref. No. R09.97.0519
 The sewage disposal and water supply facilities at this location have been
 inspected and/or certified by this Department or other agencies and found to
 be satisfactory for MAXIMUM OF 4 BEDROOMS.
 Stephen A. Costa, P.E., Chief
 Office of Water and Wastewater Management

QUOGUE ST.



SHINNECOCK AVE.
 (DIRT ROAD)

N07°48'10"E 100.00'

N82°11'50"W 100.00'

S07°48'10"W 100.00'

S82°11'50"E 100.00'

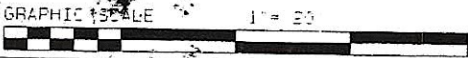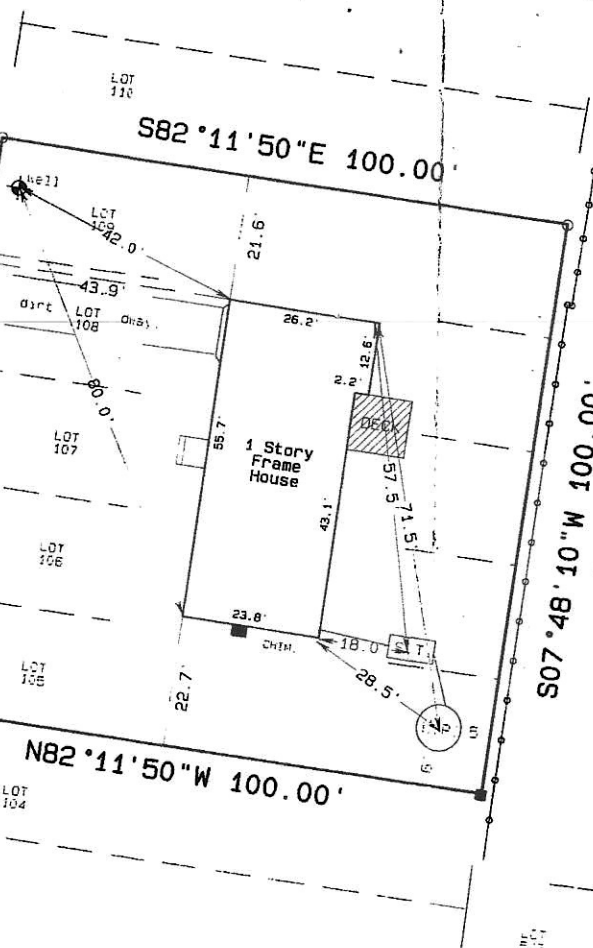

SURVEY OF LOTS 105-109
 "MAP OF PINE NECK"
 FILED NOV. 9, 1911 AS # 351
 SITUATE: EAST QUOGUE
 TOWN OF SOUTHAMPTON,
 SUFFOLK COUNTY, NY

SURVEYED 10-23-97
 CERTIFICATIONS ADDED 12-15-97
 FINAL 6-25-98

SUFFOLK COUNTY TAX MAP
 0900 241 01 26

CERTIFIED TO:
 HAMPTON HOLDINGS
 FIDELITY NATIONAL TITLE
 INSURANCE COMPANY OF NY
 TITLE # 4112702

NOTES:
 ■ DENOTES MONUMENT FOUND
 ○ DENOTES IRON PIN FOUND
 — DENOTES WOOD FENCE
 AREA = 10,000 S.F.




JOHN C. EHLERS LAND SURVEYOR
 6 EAST MAIN STREET
 RIVERHEAD, N.Y. 11901
 369-8288 Fax 369-8287
 N.Y.S. LIC. NO. 50202

Received
 Suffolk County
 AUG 17 1998
 Dept. Of Health Services
 Office Of Wastewater Mgmt.

"Unauthorized alteration or addition to a survey map bearing a licensed land surveyor's seal is a violation of section 7202, subdivision 2, of the New York State Education Law."
 "Only copies from the original of this survey, when accompanied by an original of the land surveyor's stamped seal shall be considered to be valid true copies."
 "Certifications indicated hereon signify that this survey was prepared in accordance with the existing Code of Practice for Land Surveys adopted by the New York State Association of Professional Land Surveyors. Said certifications shall run only to the person for whom the survey is prepared, and on his behalf to the title company, governmental agency and lending institution listed hereon, and to the assignees of the lending institution. Certifications are not transferable to additional institutions."

REFERENCE # 97-0077C