

MAGEE STREET

NOW OR FORMERLY: ANTHONY CARPENTER & LILLIAN CARPENTER

S 64° 52' 30" E


1/4 HEDGE 2.0' NORTH

180.17'

N 19° 59' 10" E

S 19° 59' 10" W

NOW OR FORMERLY: JOYCE P. & CATESBY KILMER

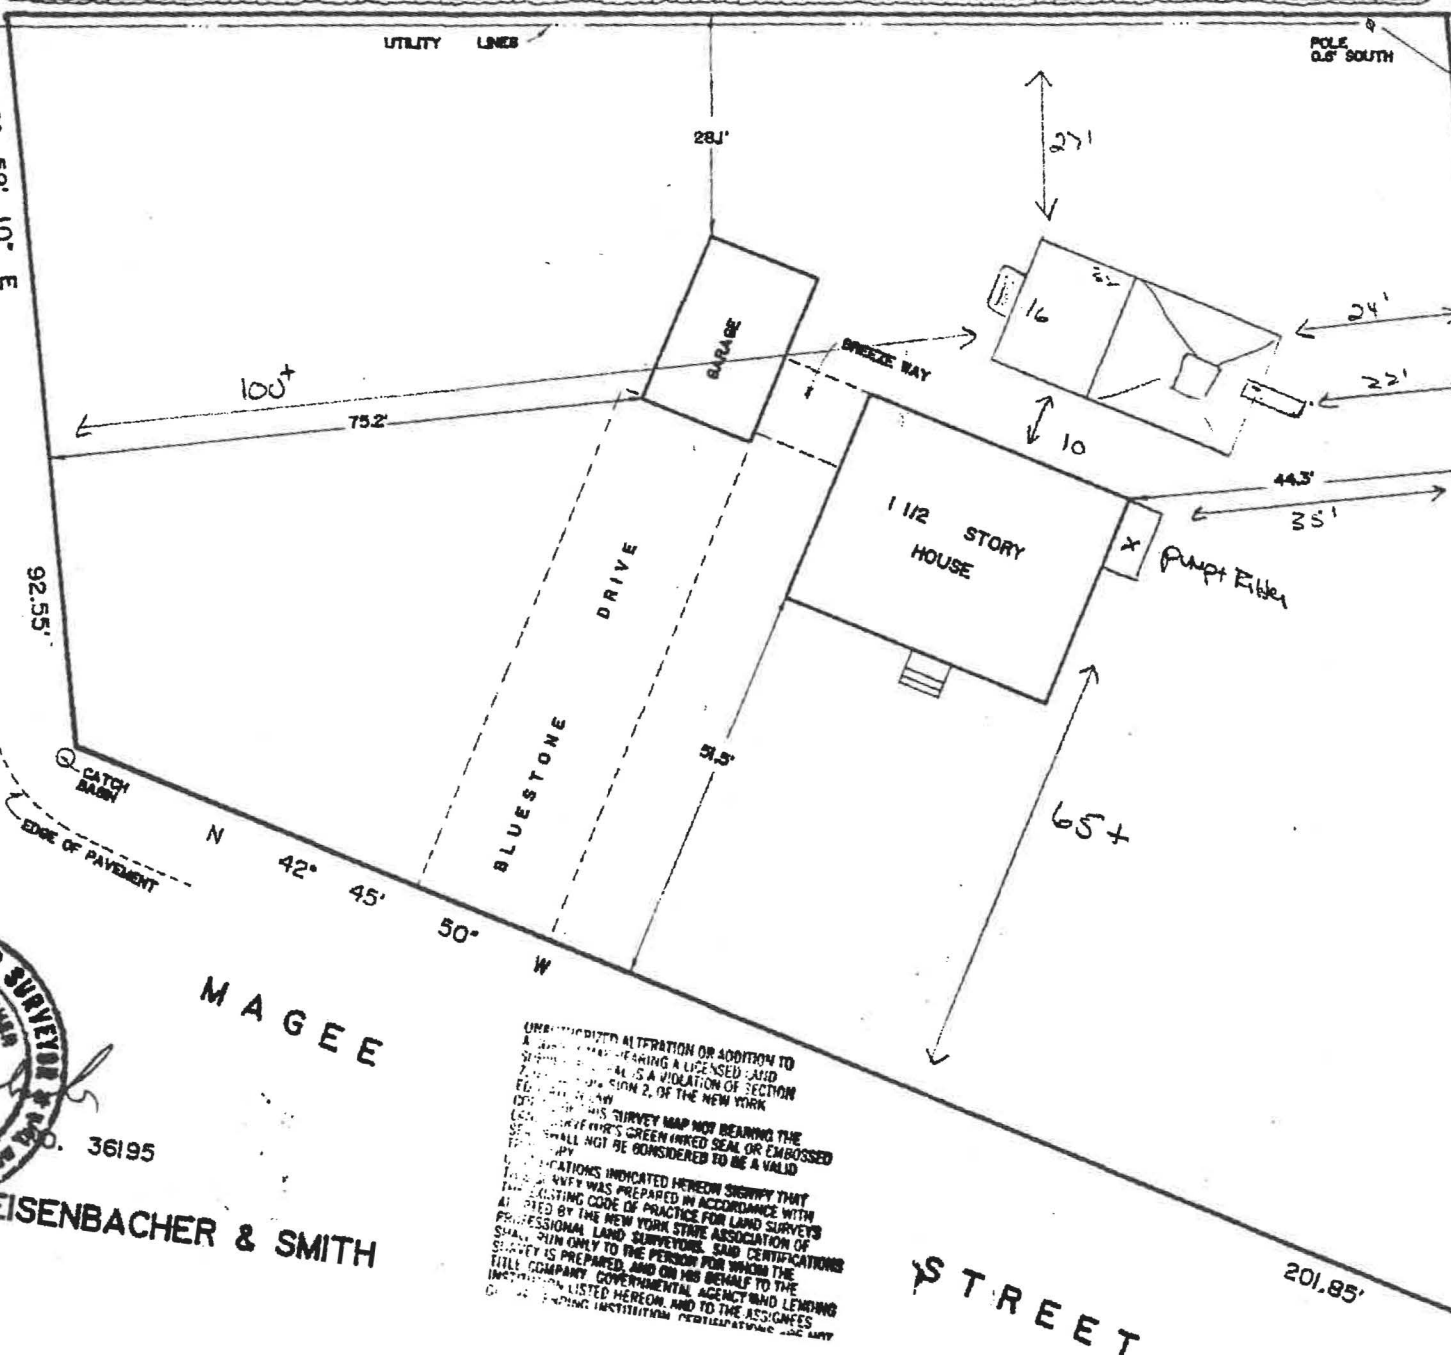

INC. VILLAGE OF SOUTHAMPTON

TOWN OF SOUTHAMPTON
SUFFOLK COUNTY, N.Y.

SCALE: 1" = 20'

AREA = 23,452 SQ. FT.

SUFFOLK COUNTY TAX MAP
DISTRICT 0904
SECTION 01.000
BLOCK 03.000
PARCEL 03.000

CERTIFIED TO:
MICHAEL McCALLEN & JOANNE NORSIC
McCALLEN
SOUTHOLD SAVINGS BANK

SURVEYED: JULY 1991
KARL W. WEISENBACHER L.S.
No. 36195
DIPIRES, HOLDEN, WEISENBACHER & SMITH

UNAUTHORIZED ALTERATION OR ADDITION TO
A SURVEY MAP BEARING A LICENSED LAND
SURVEYOR'S SEAL IS A VIOLATION OF SECTION
2, OF THE NEW YORK
EDUCATION LAW
THIS SURVEY MAP NOT BEARING THE
LAND SURVEYOR'S GREEN INKED SEAL OR EMBOSSED
SEAL SHALL NOT BE CONSIDERED TO BE A VALID
SURVEY MAP
NOTATIONS INDICATED HEREON SIGNIFY THAT
THE SURVEY WAS PREPARED IN ACCORDANCE WITH
THE EXISTING CODE OF PRACTICE FOR LAND SURVEYS
AS ADOPTED BY THE NEW YORK STATE ASSOCIATION OF
PROFESSIONAL LAND SURVEYORS. SAID CERTIFICATIONS
SHALL RUN ONLY TO THE PERSON FOR WHOM THE
SURVEY IS PREPARED, AND ON HIS BEHALF TO THE
TITLE COMPANY, GOVERNMENTAL AGENCY AND LENDING
INSTITUTION LISTED HEREON, AND TO THE ASSIGNEES
OF SAID LENDING INSTITUTION, PERTAINING TO THE SURVEY