



now or formerly
Anne K. Betty Qualified
Trust
Personal Residence

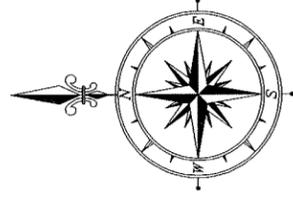

BEACH LANE

now or formerly
Martha Kelly

QUAJAQUANANTUCK LANE

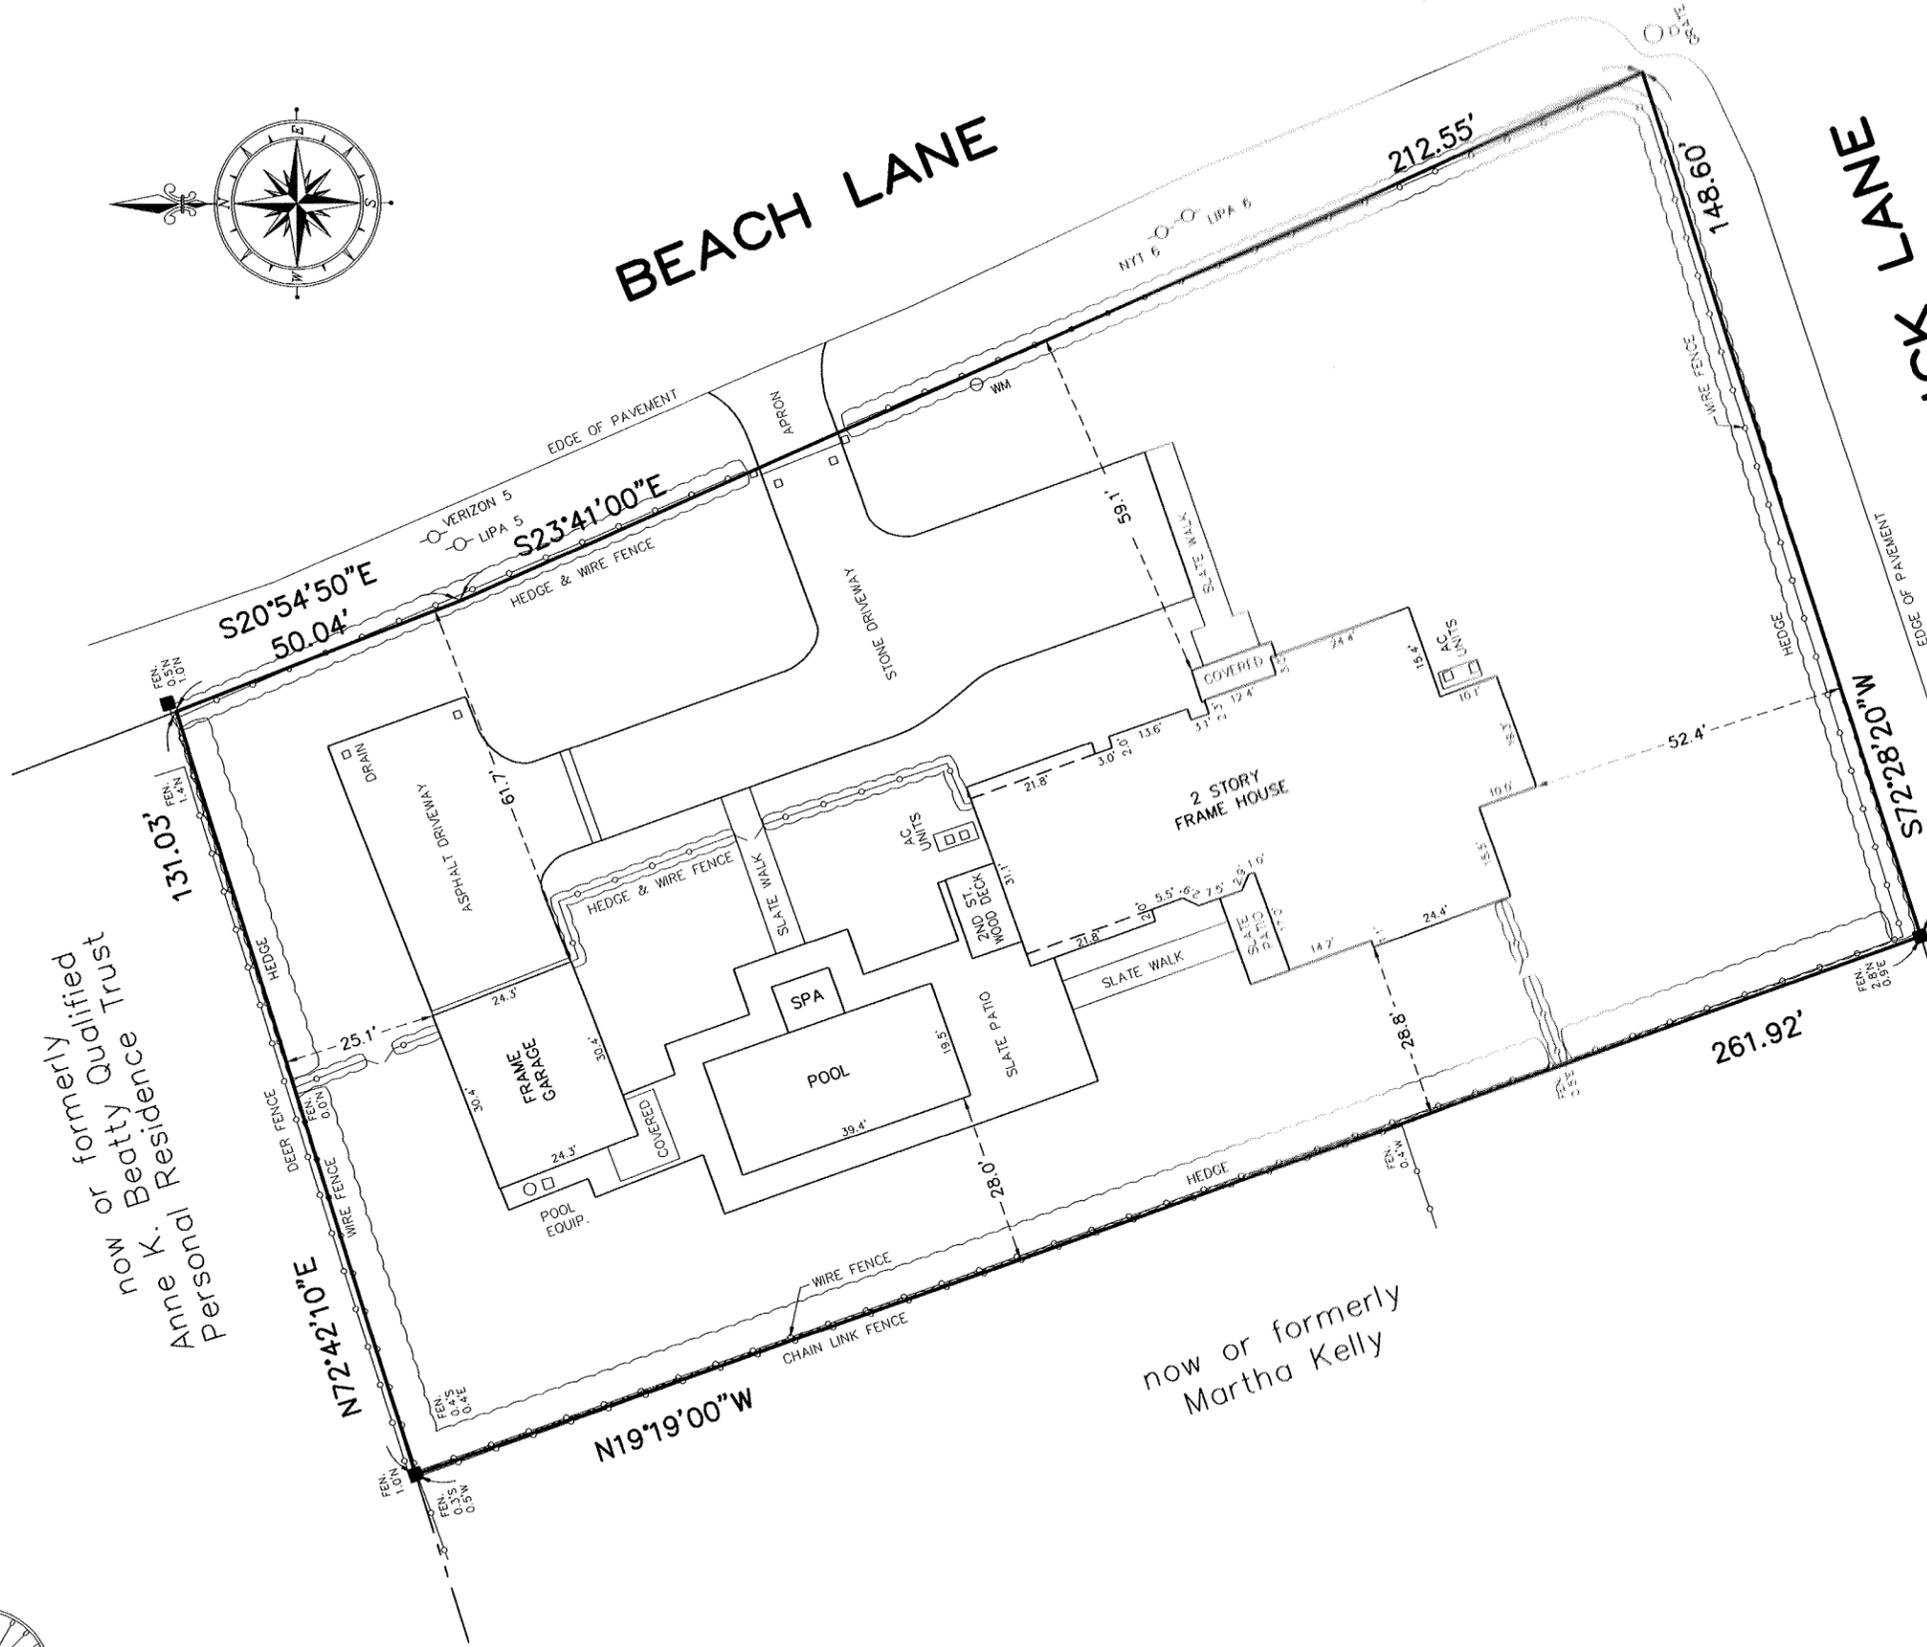

Survey for:

JENNIFER NELSON COLAO
ANDREW COLAO


At
Quogue
Town of
Southampton
Suffolk County, New York

LOT COVERAGE

- HOUSE = 3,284 S.F.
- GARAGE = 740 S.F.
- PORCH = 71 S.F.
- POOL & SPA = 846 S.F.
- DECK = 116 S.F.
- PATIO = 1,518 S.F.
- WALKS = 489 S.F.

TOTAL

= 7,064 S.F. OR 19.5%

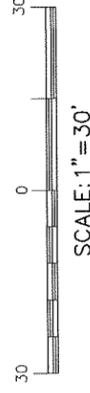

NOTES:

1. AREA = 36,304 S.F.
2. ■ = MONUMENT FOUND, ▲ = STAKE FOUND.
3. REFERENCE DEED L. 7245 CP. 470

DATE: FEB. 12, 2021
JOB NO: 2021-050

CERTIFIED TO:
JENNIFER NELSON COLAO
ANDREW COLAO
OLD REPUBLIC NATIONAL TITLE
INSURANCE COMPANY
CITIBANK N.A.



DAVID H. FOX, E.S.I.B.C. N.Y.S.L.S. #50234
FOX LAND SURVEYING

64 SUNSET AVENUE
WESTHAMPTON BEACH, N.Y. 11978
(631) 288-0022

UNAUTHORIZED ALTERATION OR ADDITION TO THIS SURVEY IS A VIOLATION OF SECTION 7209 OF THE NEW YORK STATE EDUCATION LAW. COPIES OF THIS SURVEY MAY NOT BEARING SHALL NOT BE CONSIDERED TO BE A VALID TRUE COPY.
CERTIFICATION INDICATED HEREON SHALL RUN ONLY TO THE PERSON FOR WHOM THE SURVEY IS PREPARED AND ON HIS BEHALF TO THE TITLE COMPANY, GOVERNMENTAL AGENCY AND LENDING INSTITUTION LISTED HEREON, AND TO THE ASSIGNEES OF THE LENDING INSTITUTION. CERTIFICATIONS ARE NOT TRANSFERABLE TO ADDITIONAL INSTITUTIONS OR SUBSEQUENT OWNERS.