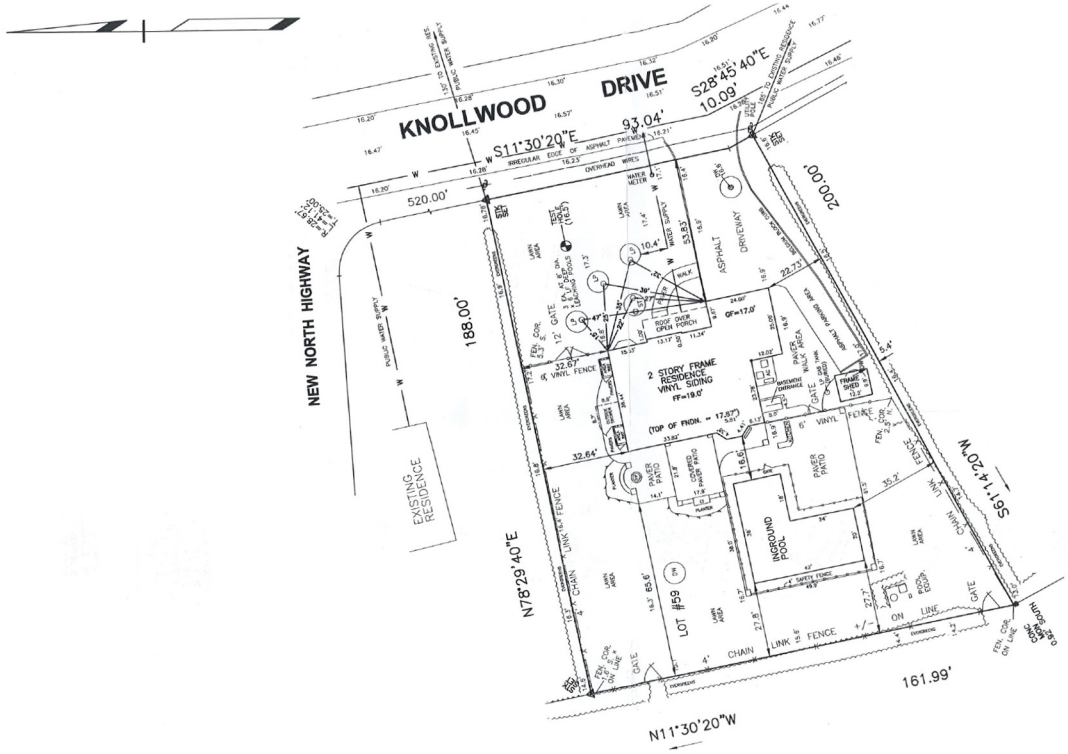
KNOLLWOOD DRIVE
NEW NORTH HIGHWAY
S11°30'20"E
93.04'
S28°45'40"E
10.09'
520.00'
188.00'
200.00'
S61°14'20"W
161.99'
N11°30'20"W
N78°29'40"E
EXISTING RESIDENCE
2 STORY FRAME RESIDENCE VINYL SIDING
FF=19.0'
(TOP OF FNDN. = 17.67')
GF=17.0'
ASPHALT DRIVEWAY
INGROUND POOL
LOT #59
PAVER PATIO
FRAME SHED
LINK FENCE
CHAIN
GATE
VINYL FENCE
ON LINE