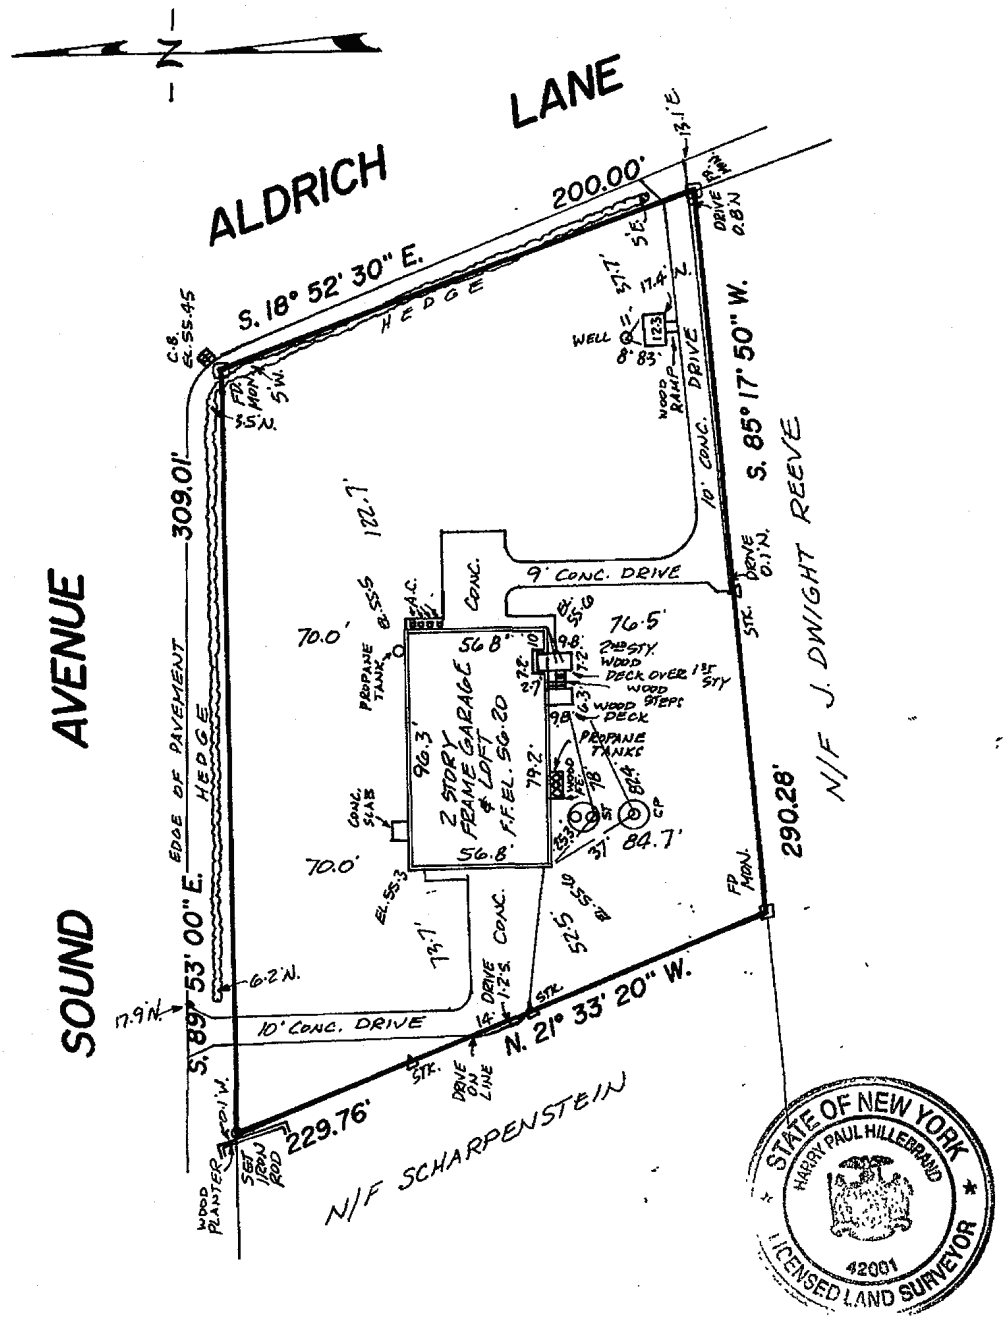

SURVEY OF DESCRIBED PROPERTY AT MATTITUCK
TOWN OF SOUTHOLD, SUFFOLK COUNTY, N. Y.

EASEMENTS AND/OR SUBSURFACE STRUCTURES RECORDED OR UNRECORDED ARE NOT GUARANTEED UNLESS PHYSICALLY EVIDENT ON THE PREMISES AT TIME OF SURVEY

IF OFFSETS OR DIMENSIONS SHOWN HEREON FROM THE PROPERTY LINES TO THE STRUCTURES ARE FOR A SPECIFIC PURPOSE AND USE. THEREFORE, THEY ARE NOT INTENDED TO MONUMENT THE PROPERTY LINES OR TO GUIDE THE ERECTION OF FENCES, ADDITIONAL STRUCTURES OR ANY OTHER IMPROVEMENT

SURVEYED : MAY 16, 1998 U.C.
MAY 21, 1998 REV.
FINAL OCT. 28, 2000
Harry P. Hillebrand

SCALE * 1" = 60'

HARRY P. HILLEBRAND
LAND SURVEYOR
11 CHURCHILL LANE - SMITHTOWN, N.Y.
TEL. 543-5139

SUFFOLK COUNTY TAX MAP			
DISTRICT	SECTION	BLOCK	LOT
1000	120	3	6

599377

NASSAU SUFFOLK BLUEPRINTING