JOB No. 3123 ~ D4000

UNAUTHORIZED ALTERATION OR ADDITION TO A SURVEY MAP BEARING A LICENSED LAND SURVEYOR'S SEAL IS A VIOLATION OF SECTION 7209, SUB-DIVISION 2, OF THE NEW YORK EDUCATION LAW.
COPIES OF THIS SURVEY MAP NOT BEARING THE LAND SURVEYOR'S GREEN INKED SEAL OR EMBOSSED SEAL SHALL NO. BE CONSIDERED TO BE A VALID TRUE COPY.
CERTIFICATIONS INDICATED HEREON SIGNIFY THAT THIS SURVEY WAS PREPARED IN ACCORDANCE WITH THE EXISTING CODE OF PRACTICE FOR LAND SURVEYS ADOPTED BY THE NEW YORK STATE ASSOCIATION OF PROFESSIONAL LAND SURVEYORS. SAID CERTIFICATIONS SHALL RUN ONLY TO THE PERSON FOR WHOM THE SURVEY IS PREPARED, AND ON HIS BEHALF TO THE TITLE COMPANY, GOVERNMENTAL AGENCY AND LENDING INSTITUTION LISTED HEREON, AND TO THE ASSIGNEE'S OF THE LENDING INSTITUTION. CERTIFICATIONS ARE NOT TRANSFERABLE TO ADDITIONAL INSTITUTIONS OR SUBSEQUENT OWNERS

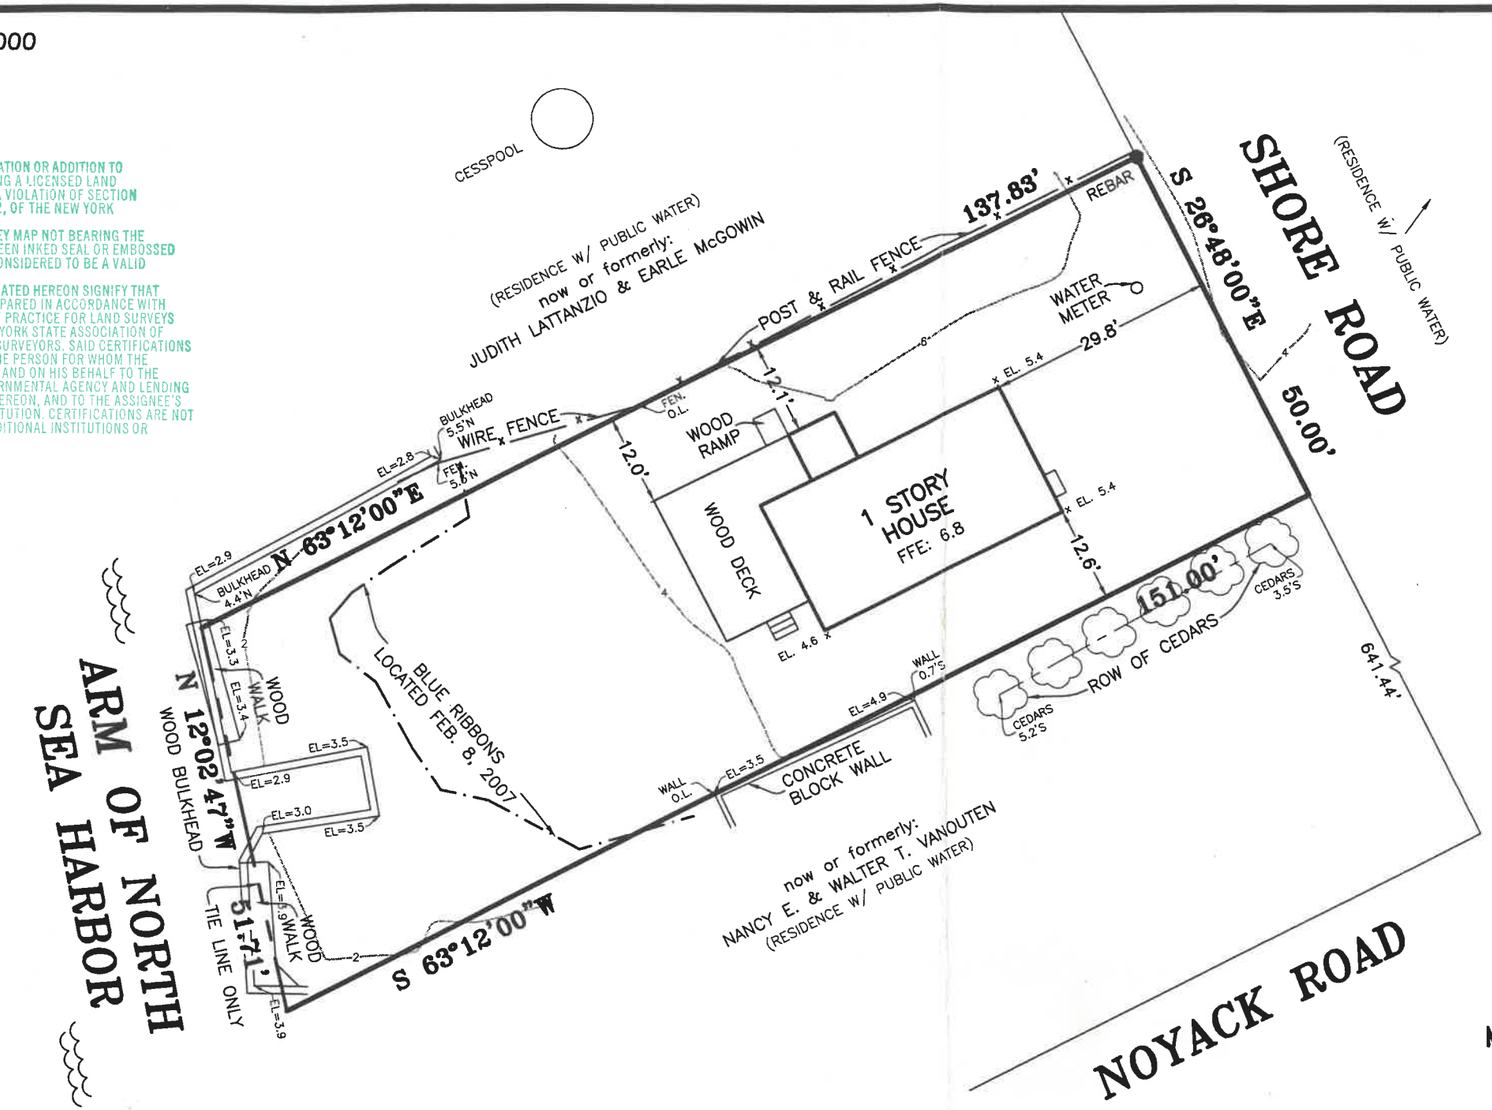

SUFFOLK COUNTY TAX MAP

DISTRICT	0900
SECTION	076.00
BLOCK	02.00
PARCEL	008.000

NOTE

1. DATUM IS N.G.V.D. OF 1929. CONTOURS ARE BASED ON AN ACTUAL FIELD SURVEY.

CERTIFIED TO:
LORI MENDOLA

SURVEYED: FEBRUARY 28, 2007

Karl W. Weisenbacher

KARL W. WEISENBACHER, L.S. No. 36195
S. H. W. & S. LAND SURVEYORS P.C.

SQUIRES, HOLDEN, WEISENBACHER & SMITH
LAND SURVEYING ~ LAND PLANNING ~ ENGINEERING
SOUTHAMPTON ~ NEW YORK

PROFESSIONAL LAND SURVEYOR
KARL W. WEISENBACHER
Lic. No. 36195
University of the State of New York

MAP OF LOT No. 22

BLOCK "O"
REVISED MAP "A"
SUBDIVISION MAP OF
NORTH SEA PARK
MAP No. 109 ~ FILED: APRIL 11, 1927
FOR
LORI MENDOLA
SITUATE
NORTH SEA
TOWN OF SOUTHAMPTON
SUFFOLK COUNTY, NEW YORK

AREA = 7,221 S.F. (0.166 ACRE)
(TO TIE LINE)

SCALE: 1" = 20'

3123.dwg BK 829 PG 123