JOB No. 15773 ~ D5188

NOTE:

1. SUBJECT PACEL FALLS WITHIN THE STORMWATER MANAGEMENT AREA.

MAP OF PART OF LOTS No. 3, 4, 5, & 6

SUBDIVISION MAP OF

WATER MILL PROPERTY

MAP No. 244 FILED: FEBRUARY 13, 1926

FOR

JONATHAN BRAM

SITUATE:

WATER MILL

TOWN OF SOUTHAMPTON

SUFFOLK COUNTY, NEW YORK

AREA = 51,079 S.F. (1.1726 ACRES TO TIE LINE)

SCALE: 1" = 40'

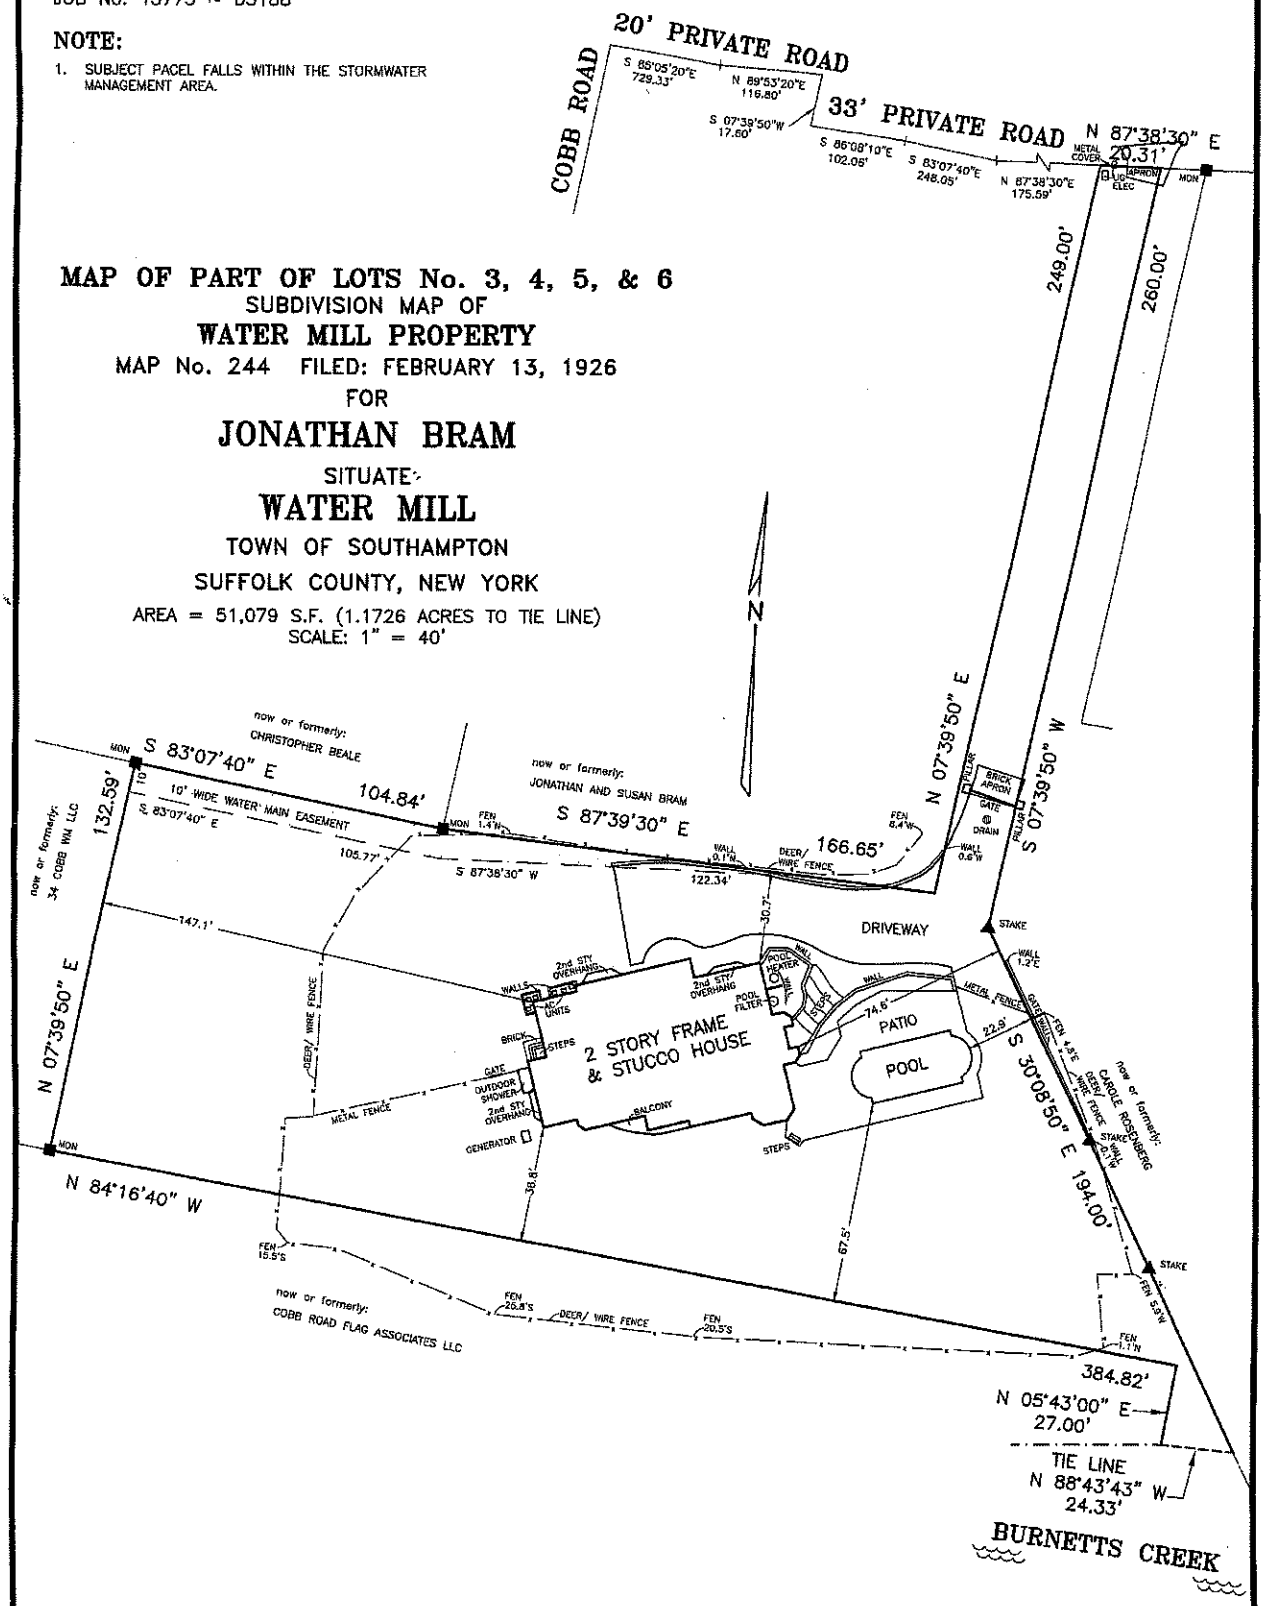

SURVEYED: FEBRUARY 2, 2023

LESTER HOLDEN, L.S. 49548
S. H. W. and S., LAND SURVEYORS, P.C.

SQUIRES, HOLDEN, WEISENBACHER & SMITH

LAND SURVEYING ~ LAND PLANNING ~ ENGINEERING
SOUTHAMPTON ~ NEW YORK

SUFFOLK COUNTY TAX MAP

DISTRICT	0900
SECTION	160.00
BLOCK	03.00
PARCEL	011.002

15773.dwg B 936 P 22