


DISTRICT	0903
SECTION	03.00
BLOCK	01.00
PARCEL	055.000

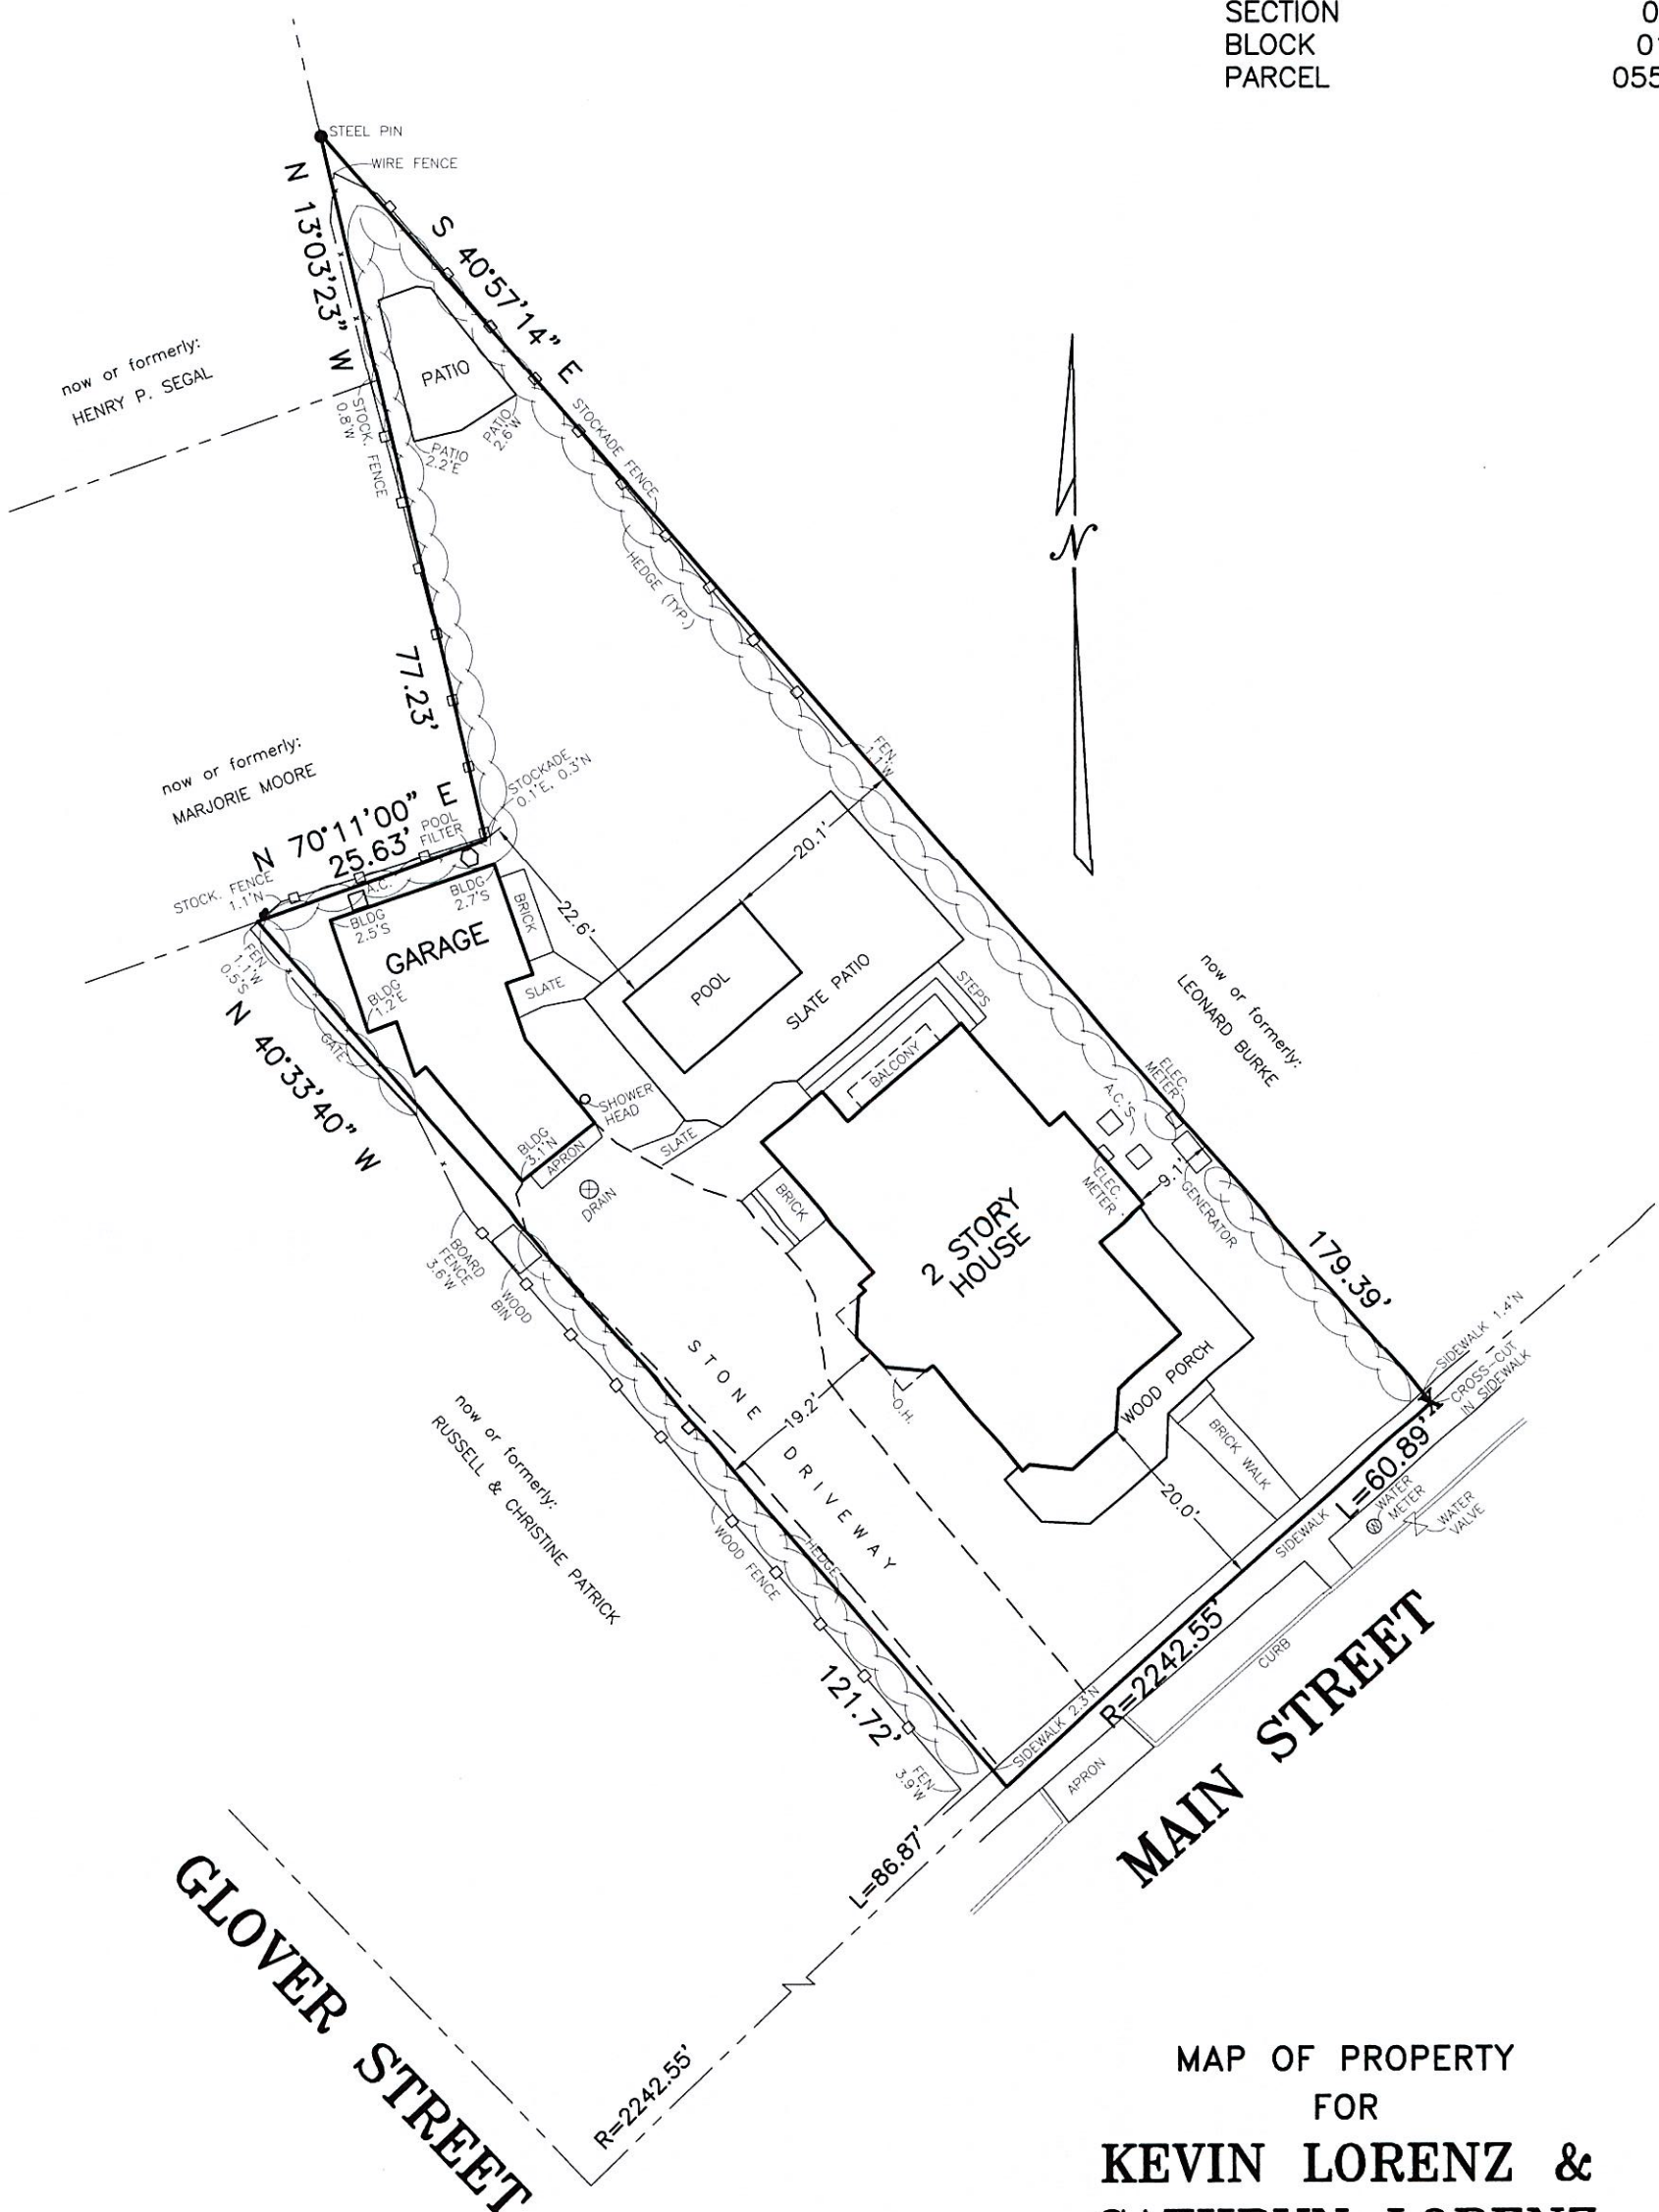

MAP OF PROPERTY
FOR
**KEVIN LORENZ &
CATHRYN LORENZ**
SITUATE
INC. VILLAGE OF SAG HARBOR
TOWN OF SOUTHAMPTON
SUFFOLK COUNTY, NEW YORK

REVISED: JULY 13, 2026 (UPDATE)
SURVEYED: JANUARY 27, 2010

LESTER HOLDEN, L.S. 49548
S. H. W. and S., LAND SURVEYORS, P.C.

SQUIRES, HOLDEN, WEISENBACHER & SMITH

LAND SURVEYING ~ LAND PLANNING ~ ENGINEERING
SOUTHAMPTON ~ NEW YORK

AREA = 8,098 S.F. (0.1859 AC.)

SCALE: 1" = 20'