

Map of Lot 14 Oceanside at Montauk

Filed Aug. 7, 1957 Map 2730
Situate
Montauk Town of East Hampton
Suffolk Co. N.Y.

Scale: 1"=20'

Guaranteed to:

Ellen A. Siber
Eastern Federal Savings
& Loan Assoc.
Home Title Division
The Chicago Title
Insurance Co. #8108-00374

UNAUTHORIZED ALTERATION OR ADDITION
TO THIS SURVEY IS A VIOLATION OF
SECTION 7209 OF THE NEW YORK STATE
EDUCATION LAW.

COPIES OF THIS SURVEY MAP NOT BEARING
THE LAND SURVEYOR'S INKED SEAL OR
EMBOSSED SEAL SHALL NOT BE CONSIDERED
TO BE A VALID TRUE COPY.


GUARANTEES INDICATED HEREON SHALL RUN
ONLY TO THE PERSON FOR WHOM THE SURVEY
IS PREPARED, AND ON HIS BEHALF TO THE
TITLE COMPANY, GOVERNMENTAL AGENCY AND
LENDING INSTITUTION LISTED HEREON, AND
TO THE ASSIGNEES OF THE LENDING INSTI-
TUTION. GUARANTEES ARE NOT TRANSFERABLE
TO ADDITIONAL INSTITUTIONS OR SUBSEQUENT
OWNERS.

GEORGE H. WALBRIDGE CO.

BY *Charles B. Kline*

Revised April 30, 1981 (added dimensions)
Surveyed Feb. 27, 1981

George H. Walbridge Co.
Land Surveyors & Land Planners
East Hampton, N.Y.

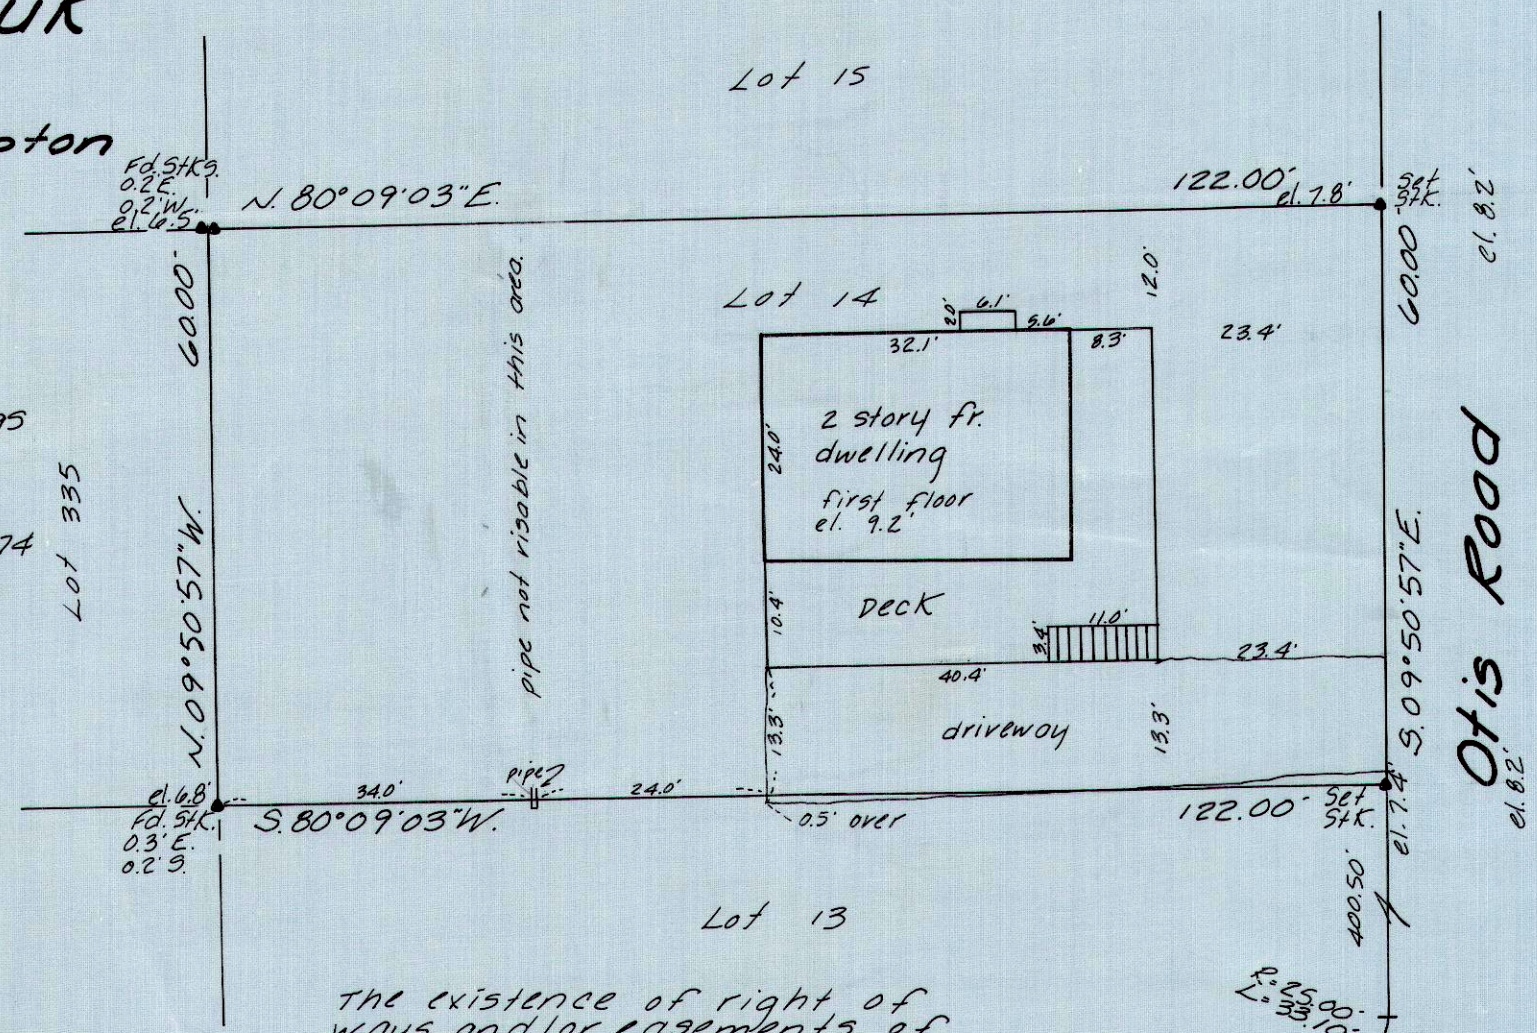

The existence of right of
ways and/or easements of
record, if any not shown,
are not guaranteed.

De Forest Road