

SURVEYED FOR GIANFRANCO & SURBHI D'ATTIS
PROPERTY LOCATED AT THE INC VILLAGE OF EAST HAMPTON
TOWN OF EAST HAMPTON
SUFFOLK COUNTY, NEW YORK
S.C.T.M. # 301-001-01-12
AREA = 15,679 SF = 0.3599 AC
SCALE: 1"=30'


NOTE: THE EXISTENCE OF RIGHT OF WAYS,
WETLANDS AND/OR EASEMENTS OF RECORD
IF ANY, NOT SHOWN ARE NOT GUARANTEED.

LOT COVERAGE CALCULATIONS:
MAX ALLOWED COV. = 20% + 500 = 3,636 SF
EXIST. COVERAGE = 3,612 SF
RES, PORCH, POOL, & DECK

NOTE: WATER SERVICE AND SEPTIC SYSTEM LOCATION
BY OTHERS.

SEPTIC LOCATION

	"A"	"B"
IA UNIT	61.5	12
L.P.	73	13.5

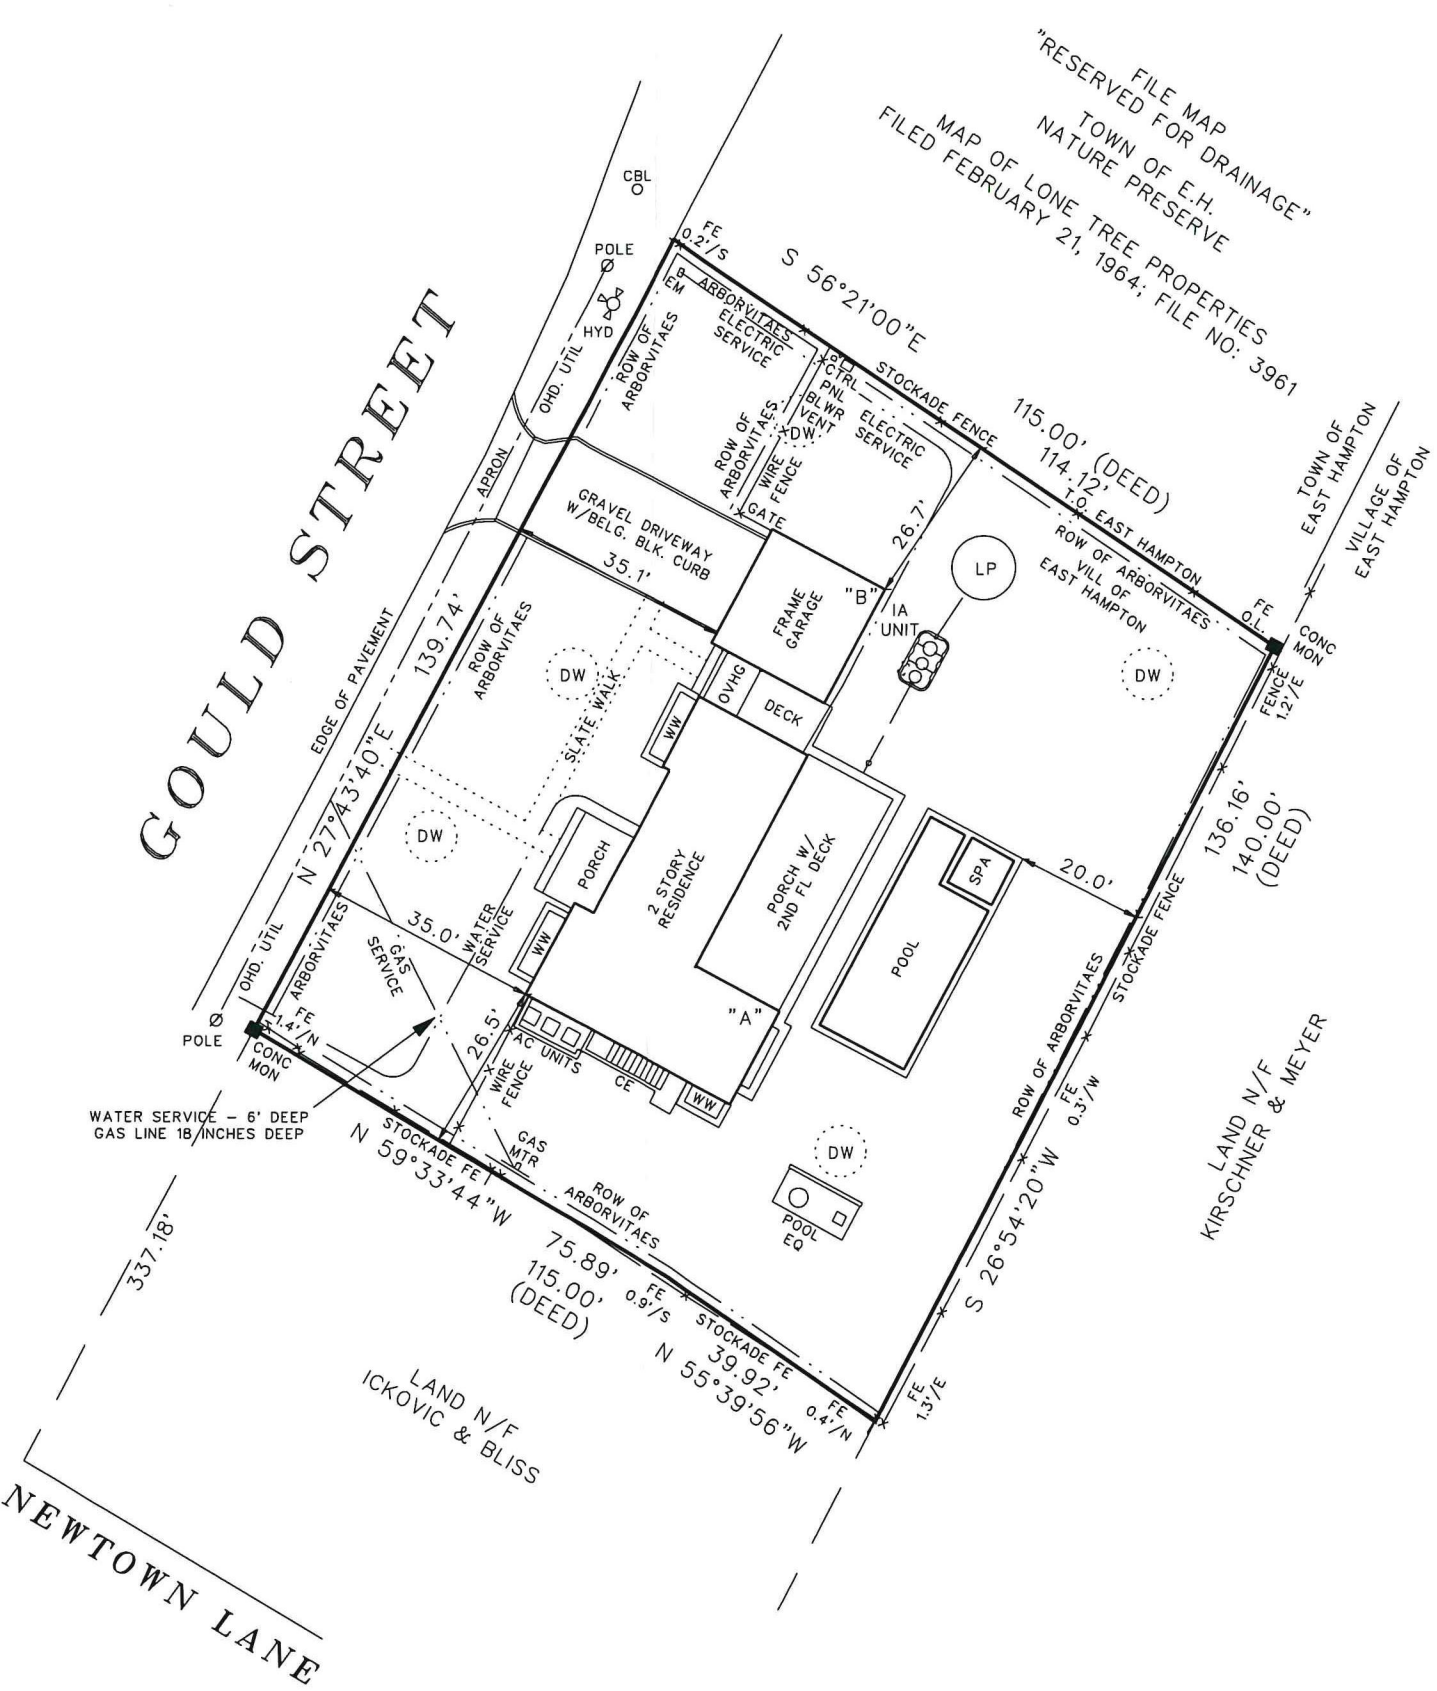

CERTIFIED TO:
GIANFRANCO D'ATTIS
SURBHI D'ATTIS

John Barylski

25261-2A



SURVEYED BY:
BARYLSKI LAND SURVEYING
2320 MAIN ST. P.O. BOX 1302
NEWMAN VILLAGE CONDO.
BRIDGEHAMPTON, NEW YORK
631-537-7944
MAY 21, 2021
3-28-2022; TOPOGRAPHY / TREE LOCATION
6-13-2022; SITE PLAN
7-18-2022; REVISED SITE PLAN
9-28-2022; REVISED SITE PLAN
11-3-2022; REVISIONS
4-4-2023; REVISED SITE PLAN
8-30-2023; REVISION
12-5-2023; STAKEOUT
9-10-2025; FINAL SURVEY

RECEIVED

SEP 29 2025

BUILDING DEPARTMENT
VILLAGE OF EAST HAMPTON