



JOB No. 13543 ~ A7084

SUFFOLK COUNTY TAX MAP

|          |         |
|----------|---------|
| DISTRICT | 0900    |
| SECTION  | 177.00  |
| BLOCK    | 01.00   |
| PARCEL   | 016.001 |

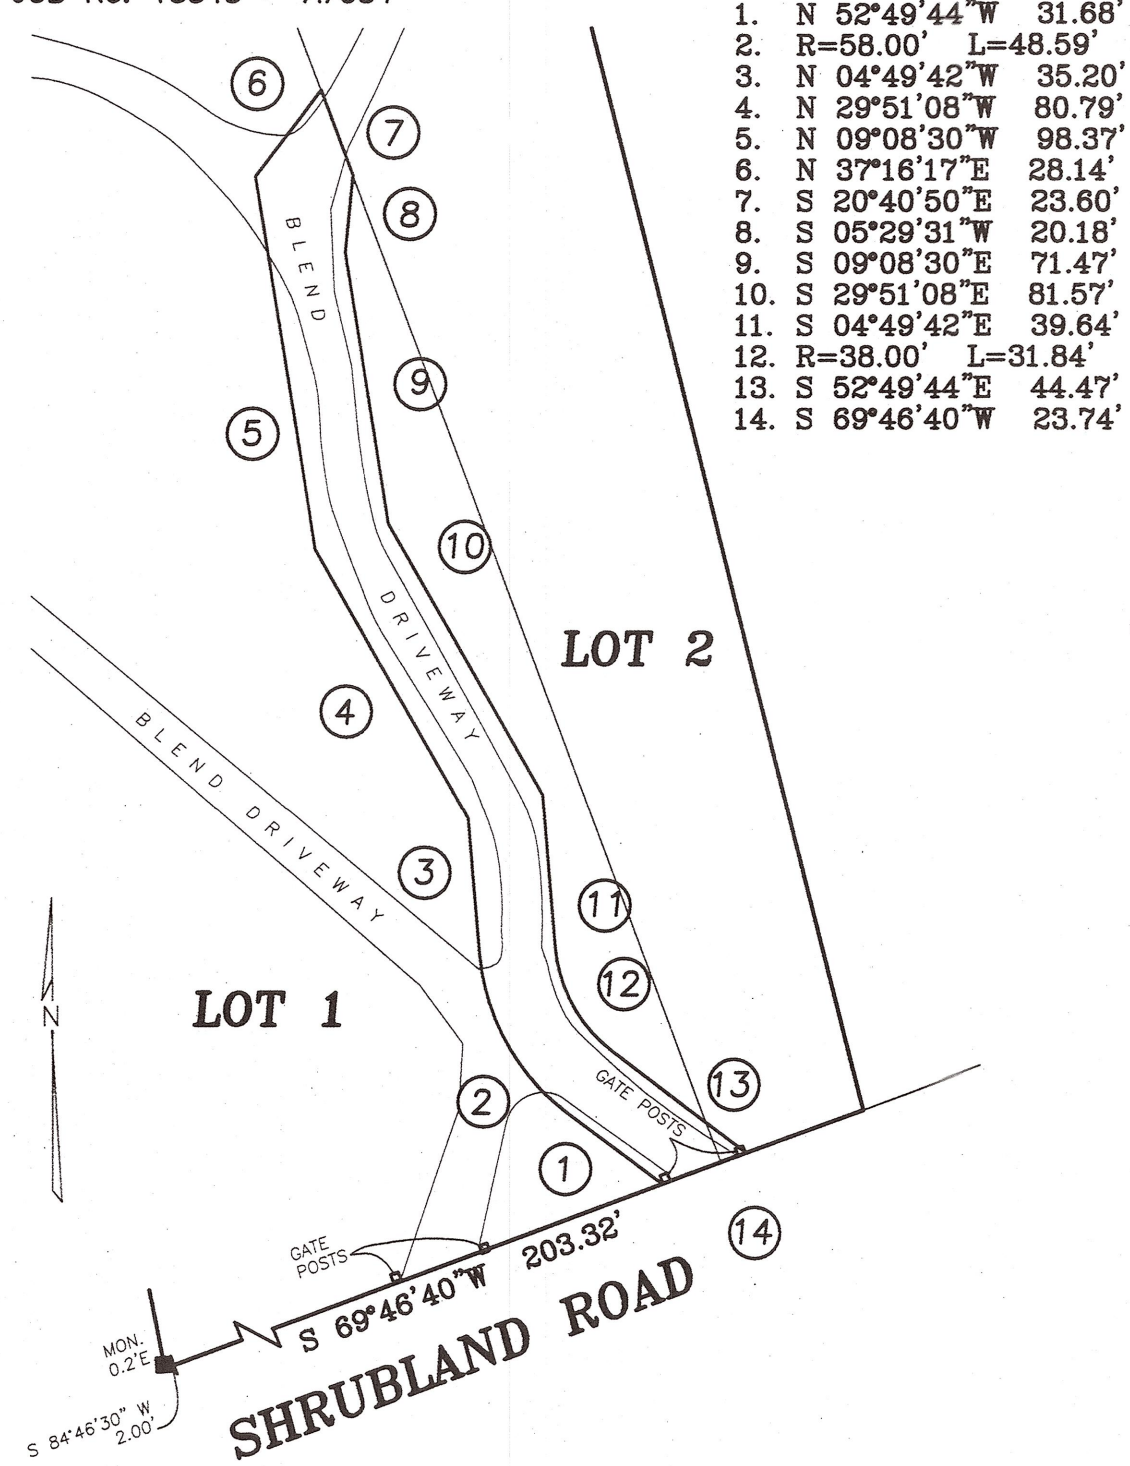


DETAIL OF DRIVEWAY EASEMENT  
NOT TO SCALE

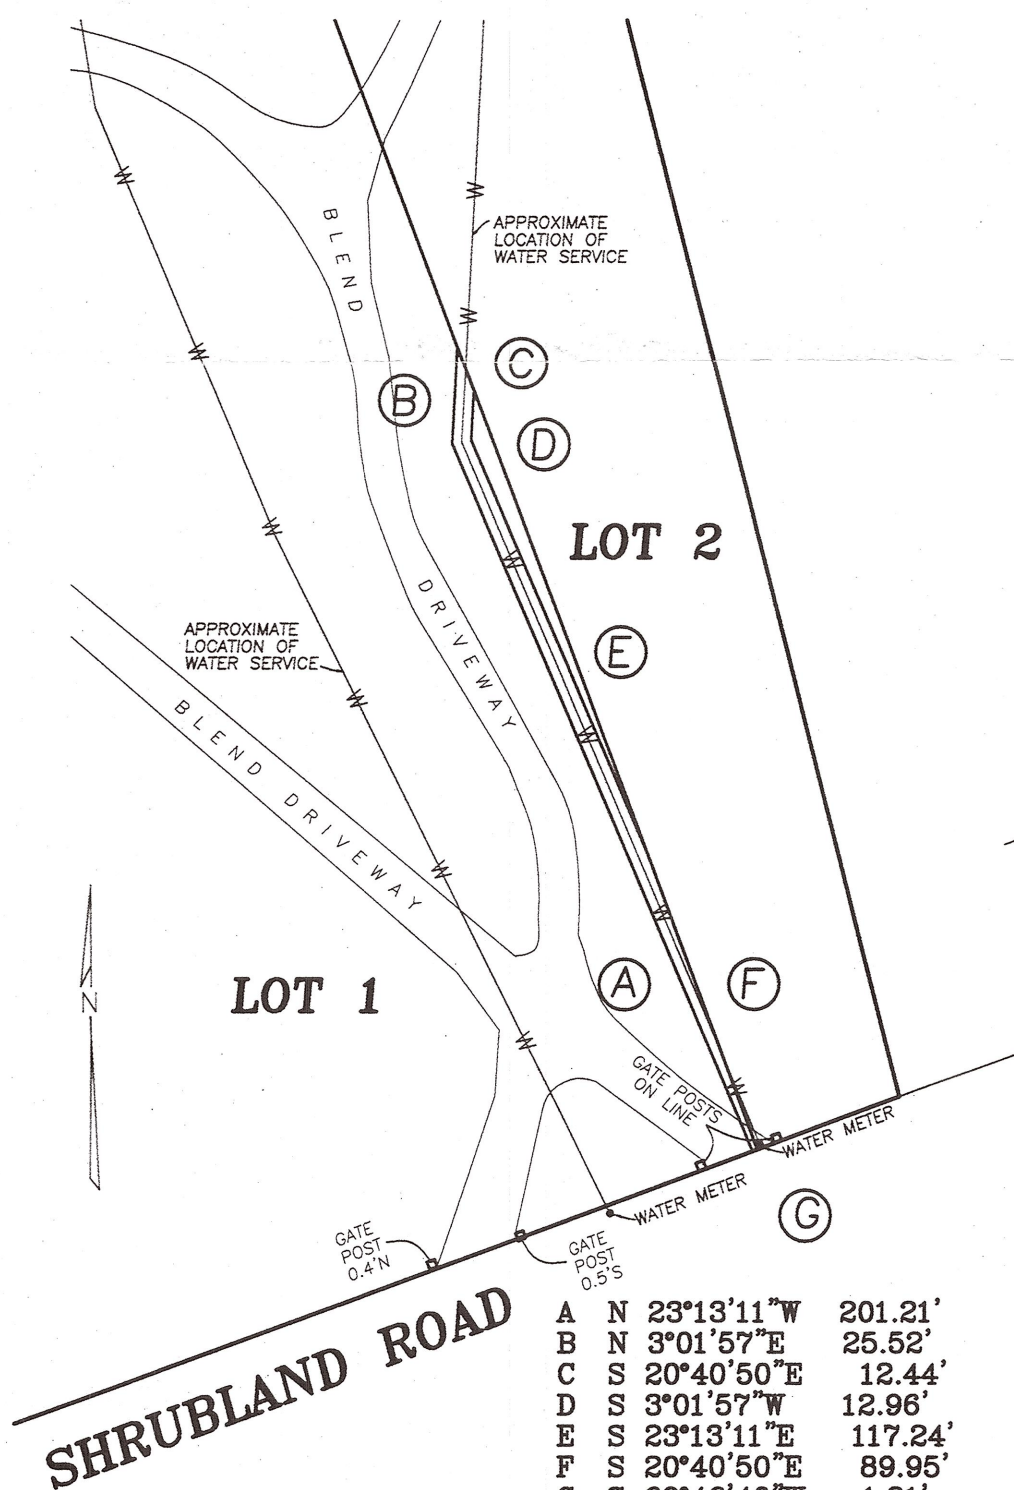

DETAIL OF WATER SERVICE EASEMENT  
NOT TO SCALE

1. N 52°49'44\"/>

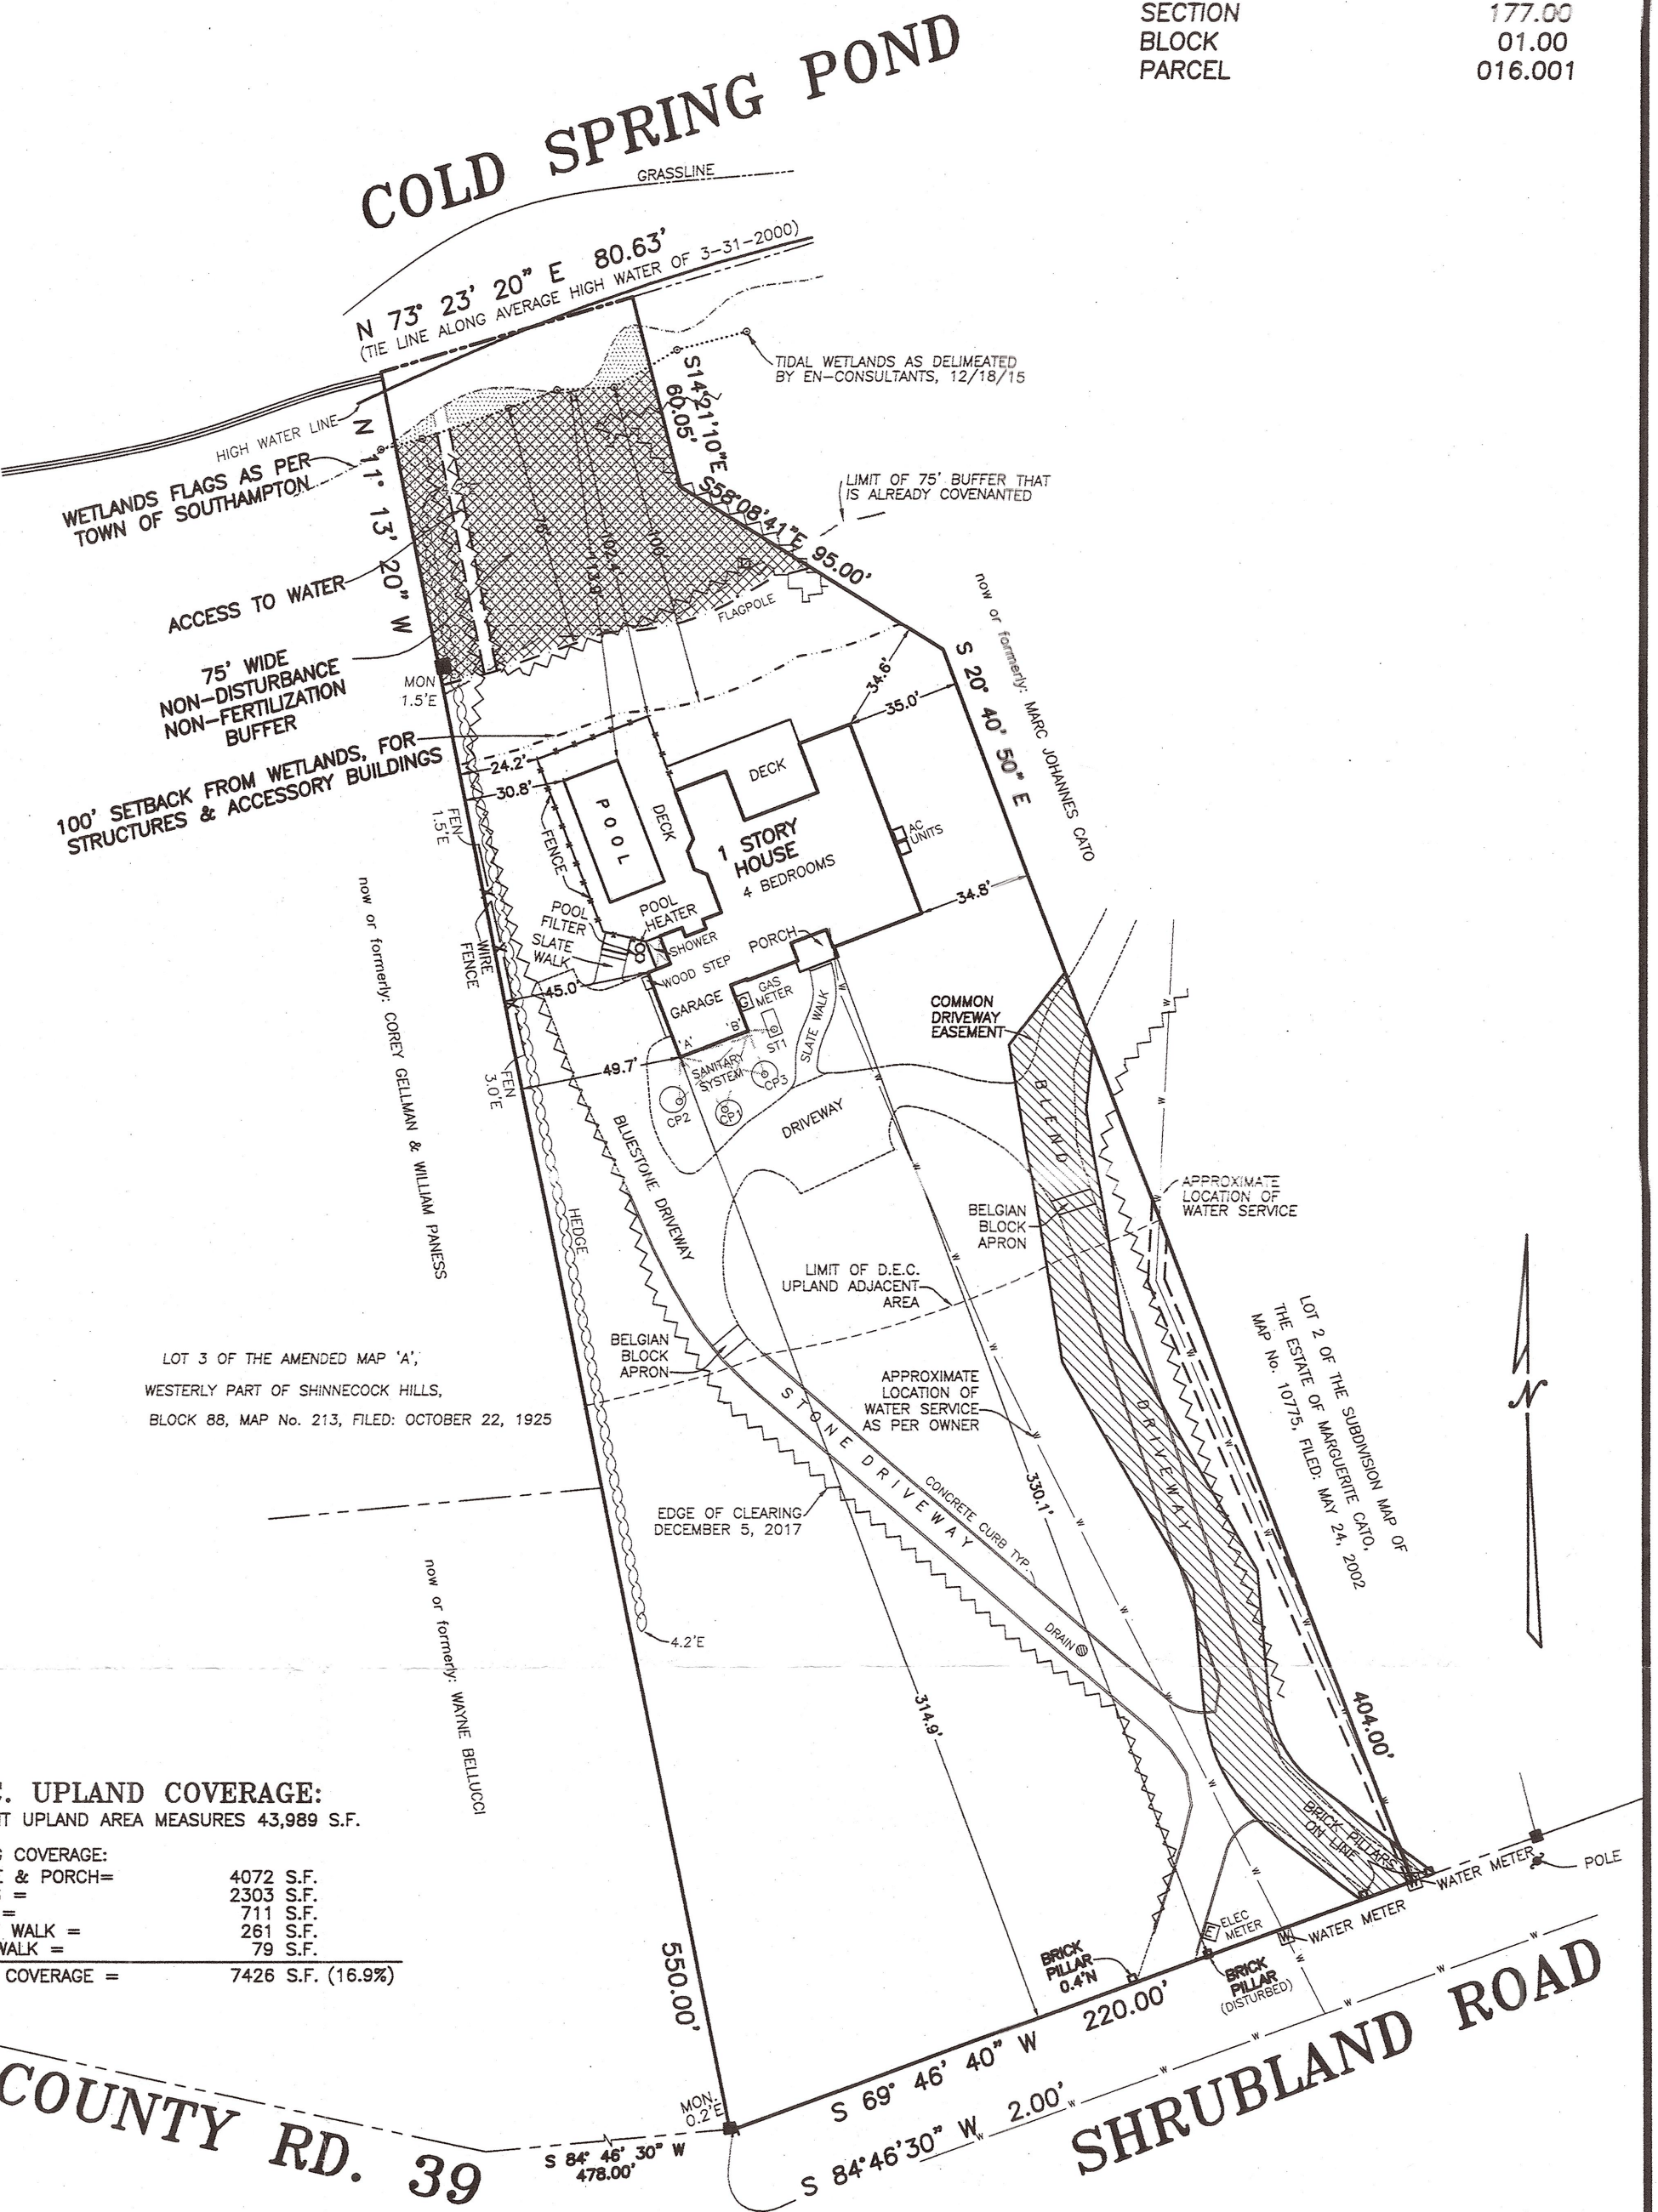



D.E.C. UPLAND COVERAGE:  
ADJACENT UPLAND AREA MEASURES 43,989 S.F.

|                    |                   |
|--------------------|-------------------|
| EXISTING COVERAGE: |                   |
| HOUSE & PORCH =    | 4072 S.F.         |
| DECKS =            | 2303 S.F.         |
| POOL =             | 711 S.F.          |
| FRONT WALK =       | 261 S.F.          |
| SIDE WALK =        | 79 S.F.           |
| TOTAL COVERAGE =   | 7426 S.F. (16.9%) |

#### NOTES

1. CURRENT ZONING: R-40.
2. PUBLIC WATER IS AVAILABLE IN THE R.O.W. OF SHRUBLAND ROAD.
3. WATER SERVICE LINE LOCATION IS SHOWN AS PER OWNER.
4. SANITARY SYSTEM STRUCTURE LOCATIONS ARE SHOWN AS PER INSTALLER. (H.D. #R09-62-0324)  
SEPTIC TANK SIZE IS 1000 GALLON.  
THREE CESSPOOLS; EACH IS 8' DIA. X 4' DEEP.

| KEY | STRUCTURE   | DISTANCE FROM 'A' | DISTANCE FROM 'B' | EXISTING |
|-----|-------------|-------------------|-------------------|----------|
| ST1 | SEPTIC TANK | 29.9'             | 8.0'              | EXISTING |
| CP1 | CESSPOOL    | 21'               | 25'               | EXISTING |
| CP2 | CESSPOOL    | 13.5'             | 30'               | NEW      |
| CP3 | CESSPOOL    | 26.3'             | 14.2'             | EXISTING |

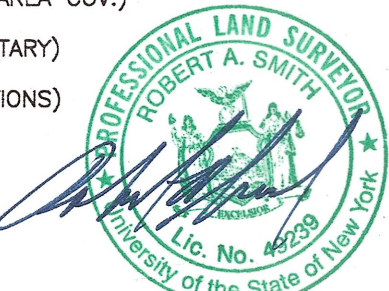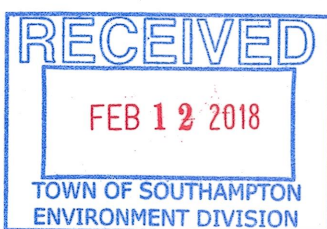

REVISED: JANUARY 26, 2018 (FINAL SAN. LOC.)  
REVISED: DECEMBER 5, 2017 (FINAL WITH CLEARING)  
REVISED: JULY 20, 2016 (FUTURE EXPANSION POOL)  
REVISED: MAY 17, 2016 (CESSPOOL LOC.)  
REVISED: MARCH 25, 2016 (FLOOD ZONES & DEC UPLAND AREA COV.)  
REVISED: MARCH 22, 2016 (TEST HOLE)  
REVISED: MARCH 17, 2016 (TOPO, WETLANDS & PROP. SANITARY)  
REVISED: MARCH 14, 2016 (PROP. SANITARY & DRIVEWAY)  
REVISED: DECEMBER 1, 2005 (REV. SANITARY SYSTEM LOCATIONS)  
REVISED: JUNE 24, 2005 (LOC. DRIVEWAY)  
REVISED: DECEMBER 23, 2004 (FINAL)  
SURVEYED: MARCH 31, 2000

ROBERT A. SMITH, L.S. No. 49239  
S. H. W. and S., LAND SURVEYORS, P.C.  
**SQUIRES, HOLDEN, WEISENBACHER & SMITH**  
LAND SURVEYING ~ LAND PLANNING ~ ENGINEERING  
SOUTHAMPTON ~ NEW YORK

UNAUTHORIZED ALTERATION OR ADDITION TO A SURVEY MAP BEARING A LICENSED LAND SURVEYOR'S SEAL IS A VIOLATION OF SECTION 7209, SUB-DIVISION 2, OF THE NEW YORK EDUCATION LAW.  
COPIES OF THIS SURVEY MAP NOT BEARING THE LAND SURVEYOR'S GREEN INKED SEAL OR EMBOSSED SEAL SHALL NOT BE CONSIDERED TO BE A VALID TRUE COPY.  
CERTIFICATIONS INDICATED HEREON SIGNIFY THAT THIS SURVEY WAS PREPARED IN ACCORDANCE WITH THE EXISTING CODE OF PRACTICE FOR LAND SURVEYS ADOPTED BY THE NEW YORK STATE ASSOCIATION OF PROFESSIONAL LAND SURVEYORS. SAID CERTIFICATIONS SHALL RUN ONLY TO THE PERSON FOR WHOM THE SURVEY IS PREPARED, AND ON HIS BEHALF TO THE TITLE COMPANY, GOVERNMENTAL AGENCY AND LENDING INSTITUTION LISTED HEREON, AND TO THE ASSIGNEE'S OF THE LENDING INSTITUTION. CERTIFICATIONS ARE NOT TRANSFERABLE TO ADDITIONAL INSTITUTIONS OR SUBSEQUENT OWNERS.

Approved

APR 30 2018

Town of Southampton  
Environment Division

MAP OF LOT No. 1  
SUBDIVISION MAP OF  
THE ESTATE OF MARGUERITE CATO  
MAP No. 10775 FILED: MAY 24, 2002  
FOR  
**FRANK LIANTONIO**  
SITUATE  
**SHINNECOCK HILLS**  
TOWN OF SOUTHAMPTON  
SUFFOLK COUNTY, NEW YORK  
AREA: 90,256 S.F. (2.072 ACRES)  
SCALE: 1" = 50'

