
SURVEY OF PROPERTY
AT LAUREL
TOWN OF SOUTHOLD
SUFFOLK COUNTY, N.Y.

1000–145–02–09

SCALE: 1"=40

DECEMBER 9, 1991

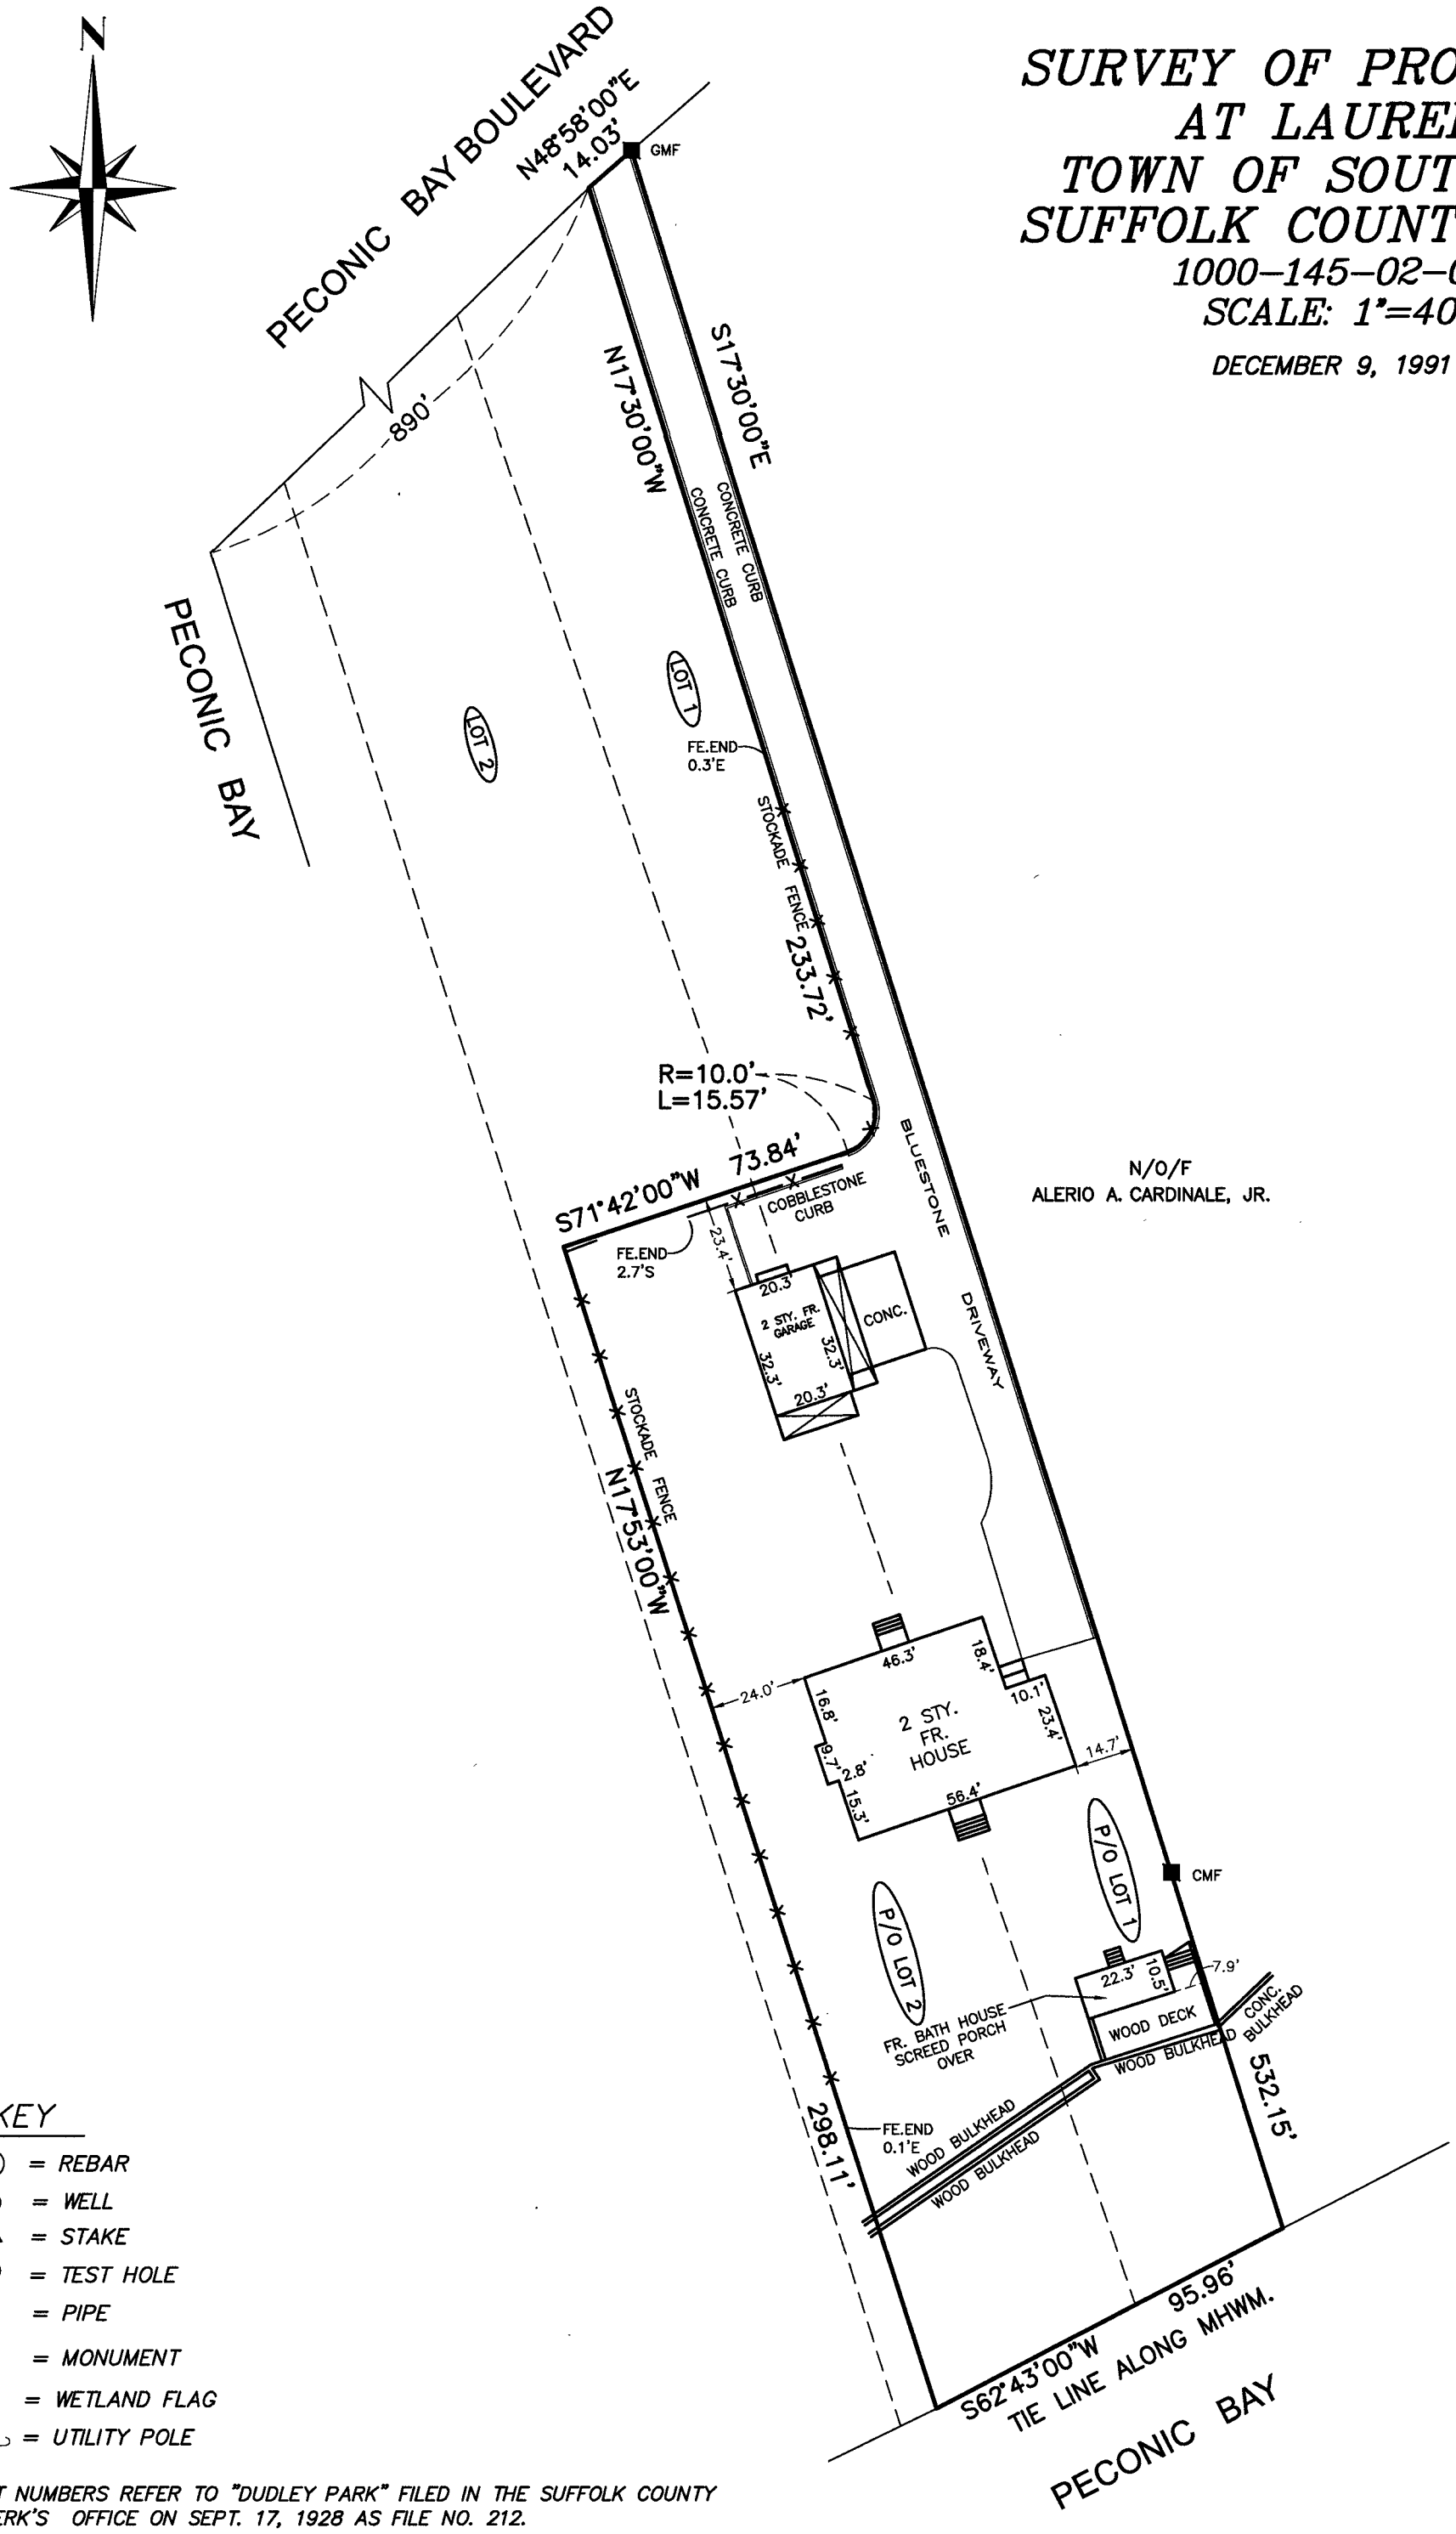

KEY

- ◉ = REBAR
- ⊗ = WELL
- ▲ = STAKE
- ◒ = TEST HOLE
- ● = PIPE
- ■ = MONUMENT
- ♦ = WETLAND FLAG
- ⌀ = UTILITY POLE

LOT NUMBERS REFER TO "DUDLEY PARK" FILED IN THE SUFFOLK COUNTY CLERK'S OFFICE ON SEPT. 17, 1928 AS FILE NO. 212.

ANY ALTERATION OR ADDITION TO THIS SURVEY IS A VIOLATION OF SECTION 7209OF THE NEW YORK STATE EDUCATION LAW. EXCEPT AS PER SECTION 7209–SUBDIVISION 2. ALL CERTIFICATIONS HEREON ARE VALID FOR THIS MAP AND COPIES THEREOF ONLY IF SAID MAP OR COPIES BEAR THE IMPRESSED SEAL OF THE SURVEYOR WHOSE SIGNATURE APPEARS HEREON.

AREA= 30,970 SQ.FT.

N.Y.S. LIC. NO. 49618

PECONIC SURVEYORS, P.C.
(631) 765–5020 FAX (631) 765–1797
P.O. BOX 909
1230 TRAVELER STREET
SOUTHOLD, N.Y. 11971

91–299