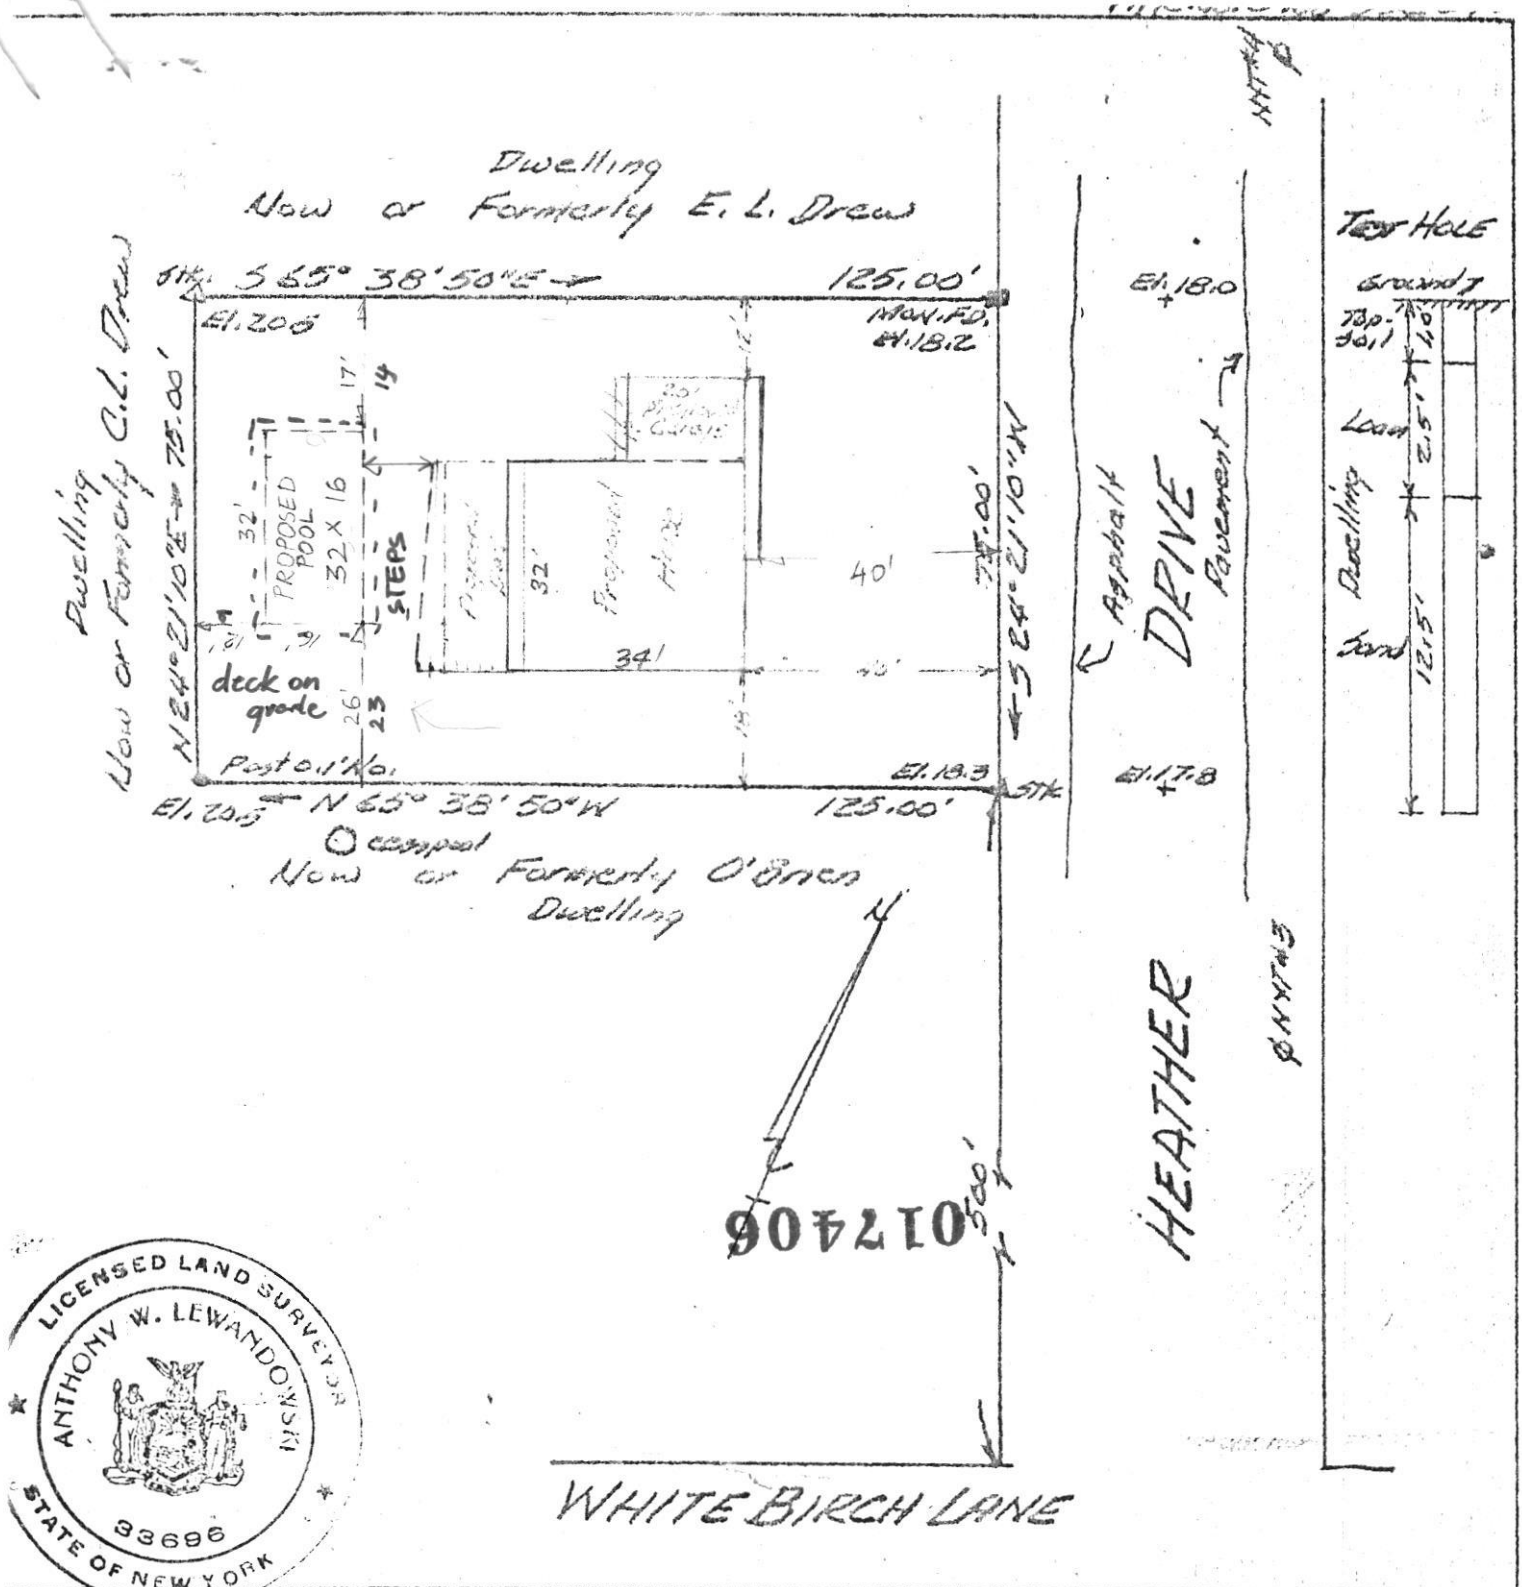


MADE FOR: BARBARA DIETZ

MAP OF: PROPERTY

LOCATION: REMSENBURG, SUFFOLK COUNTY, N.Y.

ANTHONY W. LEWANDOWSKI
LAND SURVEYOR
SOUTHOLD, N. Y.

GUARANTEED TO: CENTURY ABSTRACT CORP. & CHICAGO TITLE INSURANCE CO.

DATE: NOVEMBER 27, 1984

SCALE: 1" = 30'

Anthony W. Lewandowski