


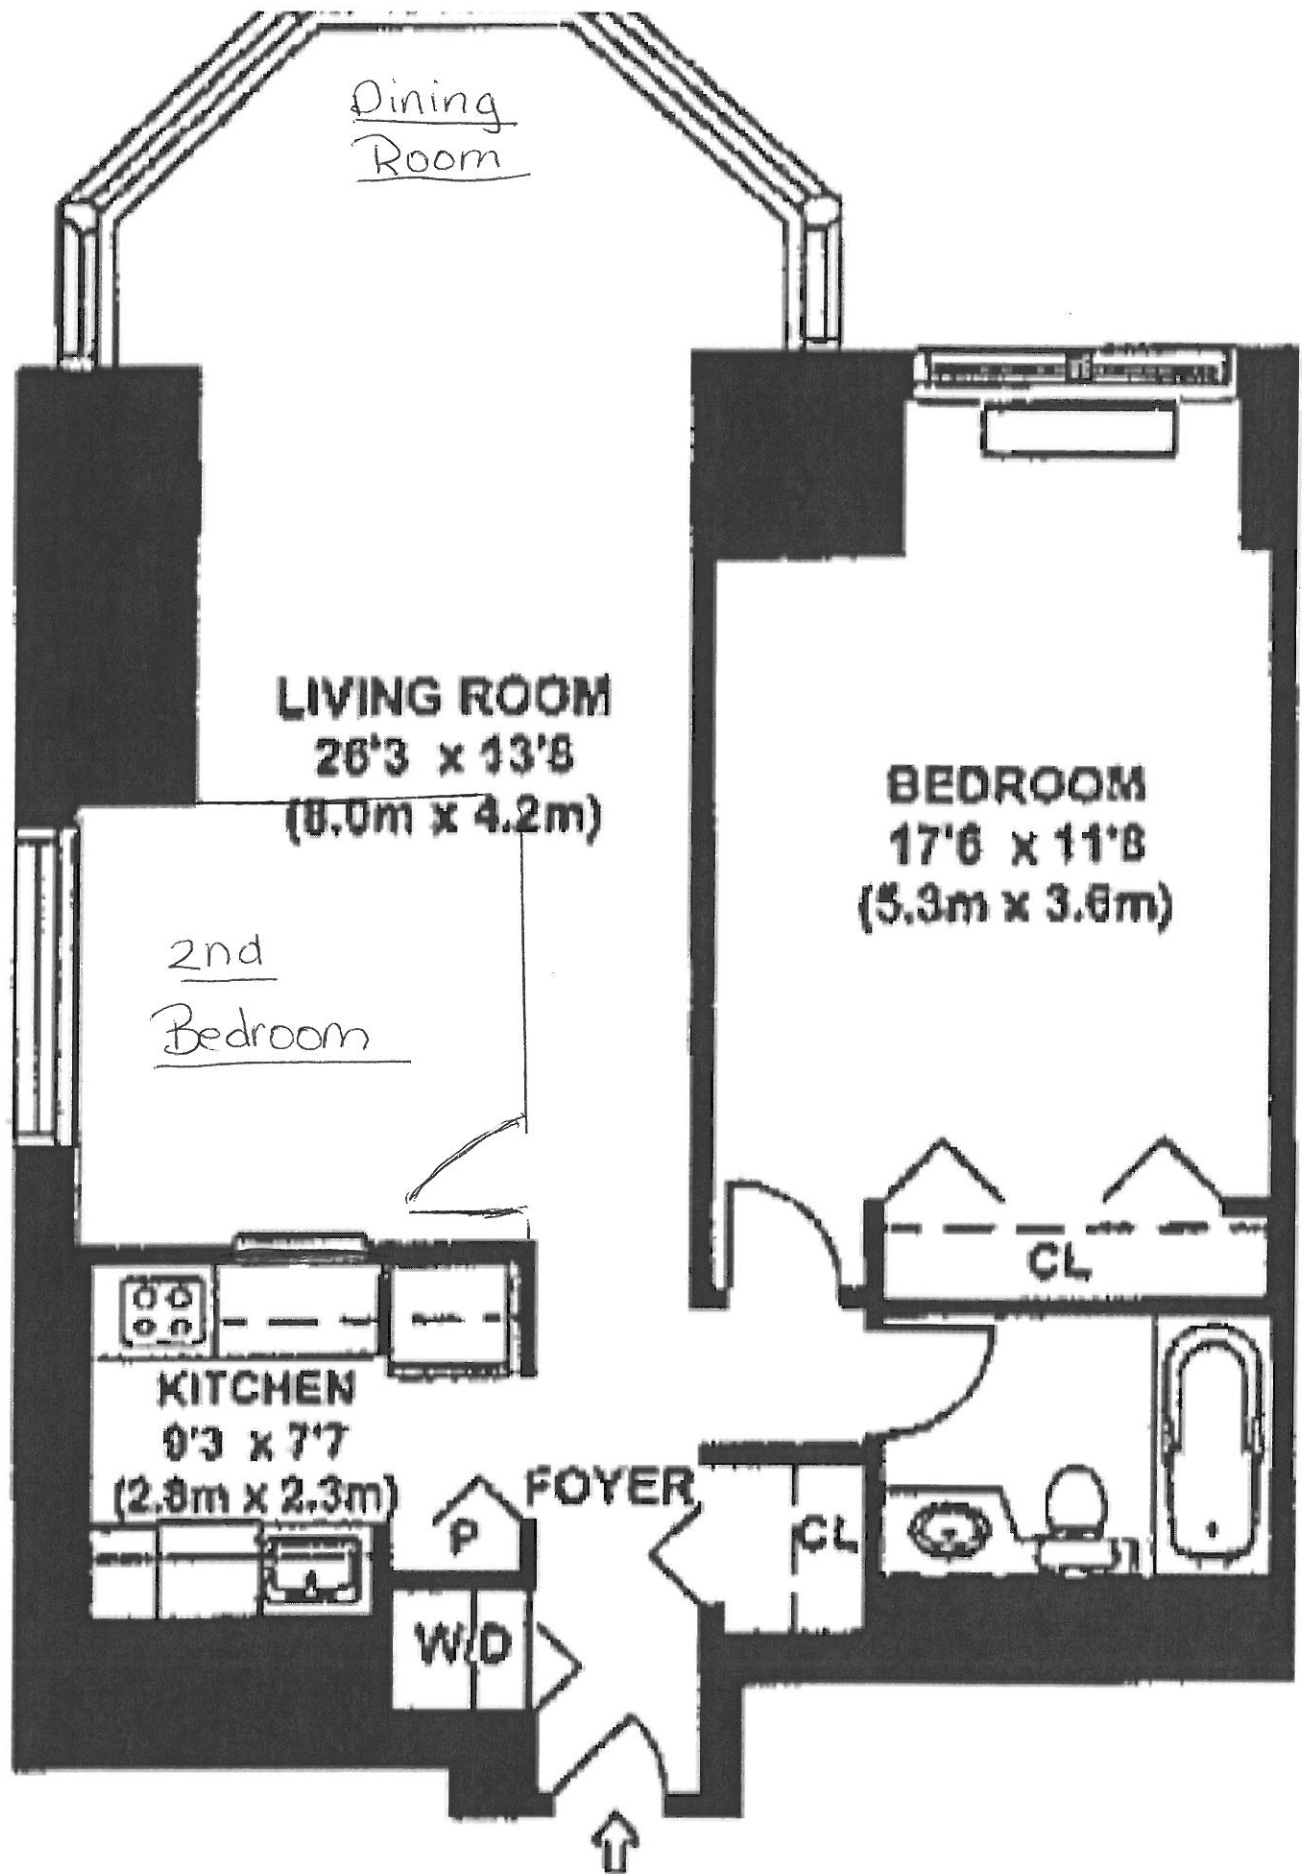

Central Park Place