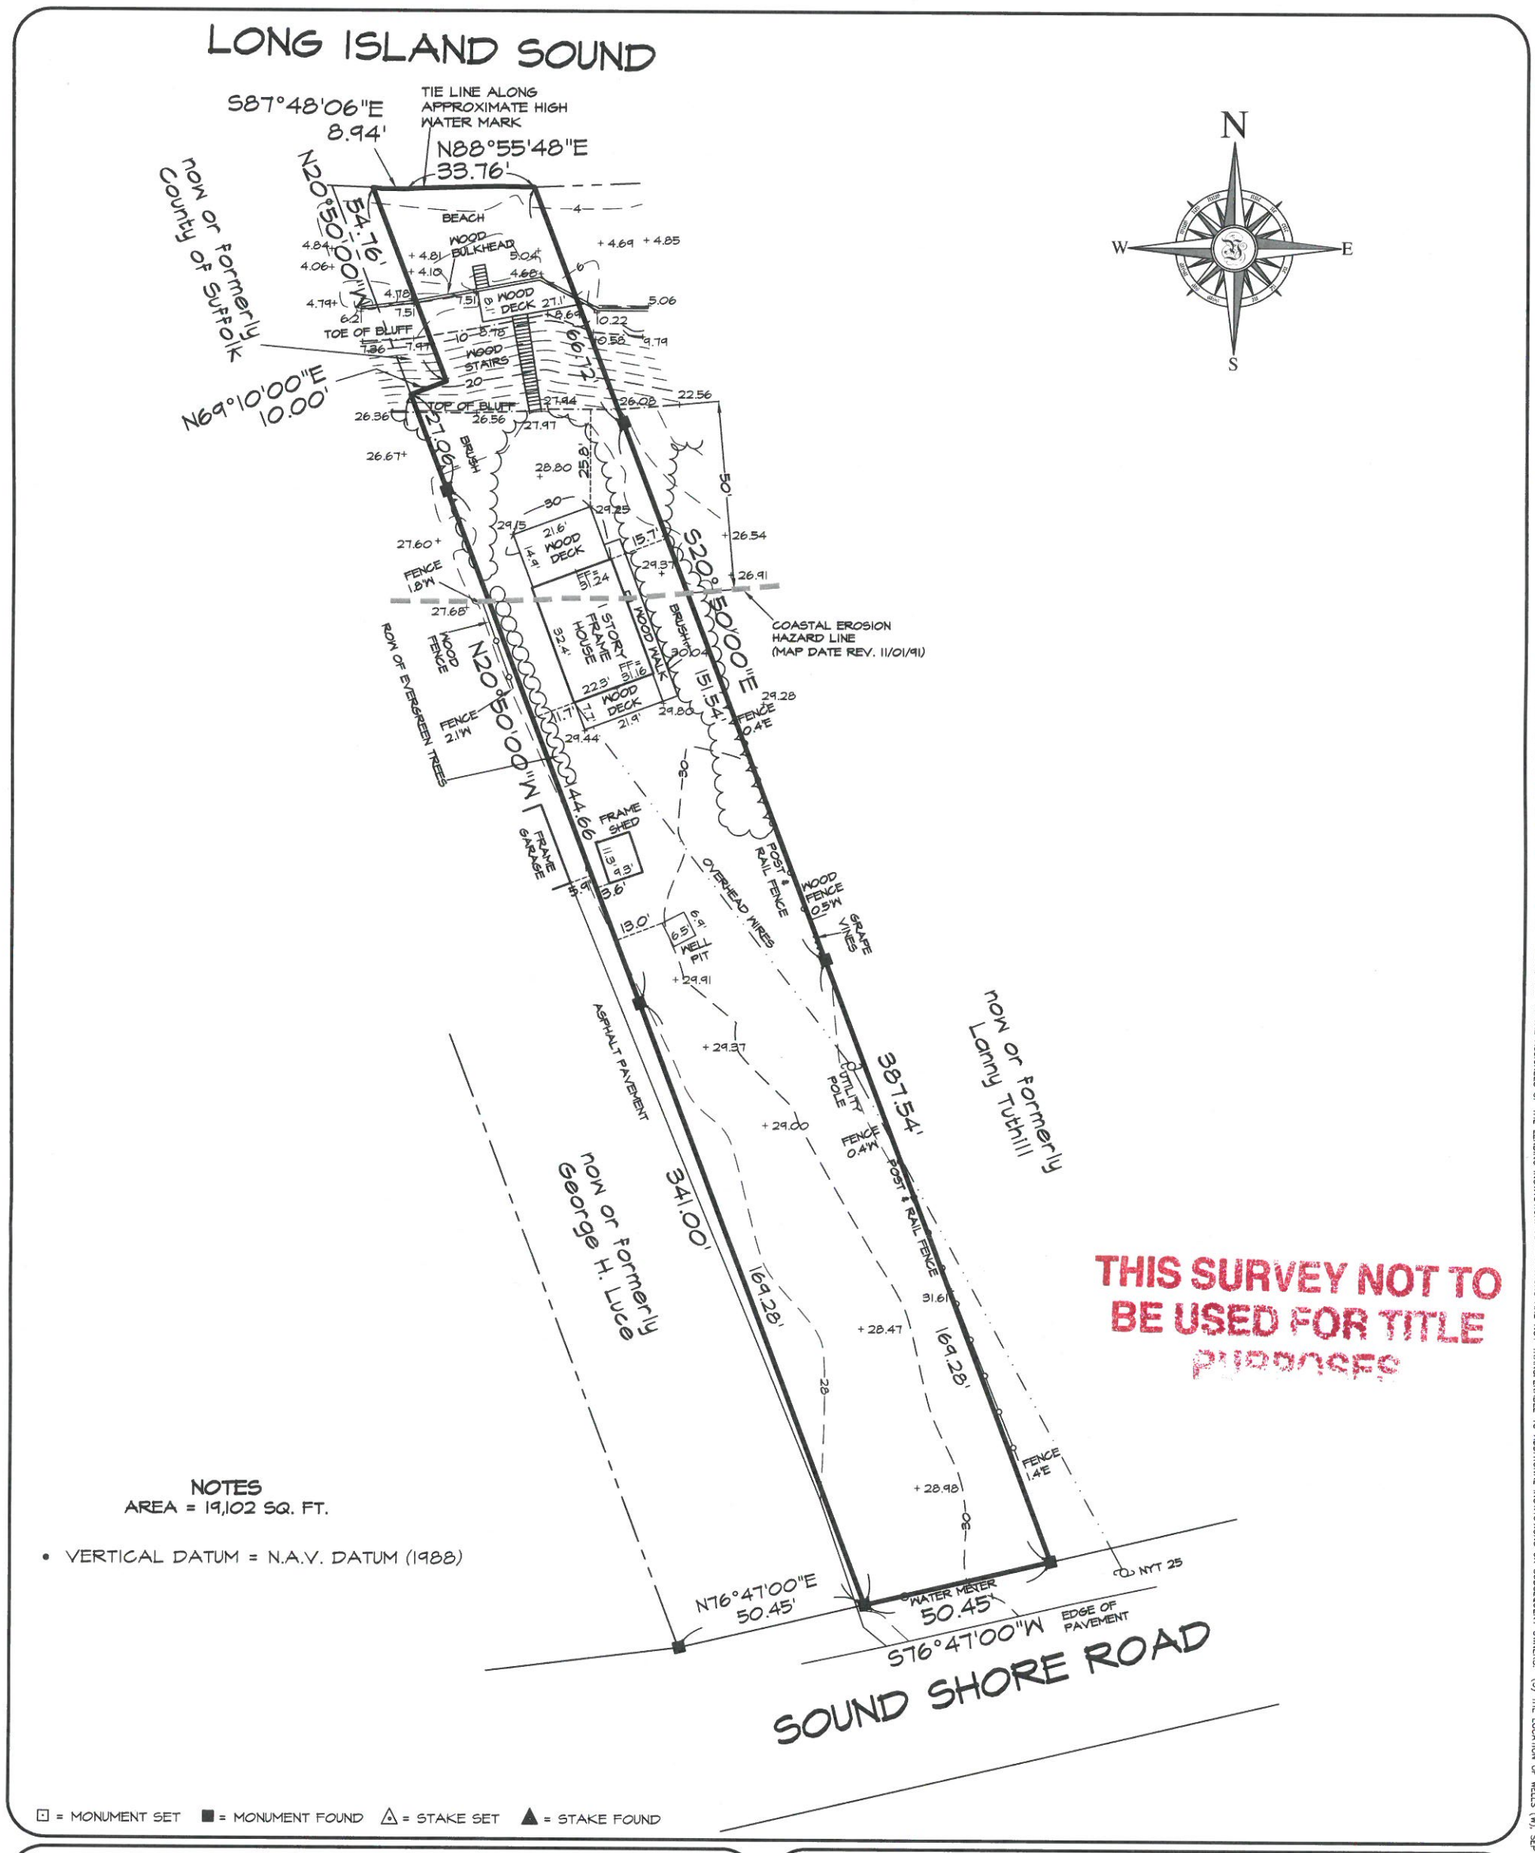

THIS SURVEY NOT TO BE USED FOR TITLE PURPOSES

NOTES

AREA = 19,102 SQ. FT.

- VERTICAL DATUM = N.A.V. DATUM (1988)

⊡ = MONUMENT SET ■ = MONUMENT FOUND △ = STAKE SET ▲ = STAKE FOUND

400 Ostrander Avenue, Riverhead, New York 11901
tel. 631.727.2303 fax. 631.727.0144
admin@youngengineering.com

Young & young

Howard W. Young, Land Surveyor
Thomas C. Wolpert, Professional Engineer
Douglas E. Adams, Professional Engineer
Robert C. Tast, Architect

SURVEYOR'S CERTIFICATION

* WE HEREBY CERTIFY TO ELIAS KASSAPIDIS THAT THIS SURVEY WAS PREPARED IN ACCORDANCE WITH THE CODE OF PRACTICE FOR LAND SURVEYS ADOPTED BY THE NEW YORK STATE ASSOCIATION OF PROFESSIONAL LAND SURVEYORS.

HOWARD W. YOUNG, N.Y.S. L.S. NO. 45893

SURVEY FOR

ELIAS KASSAPIDIS

at Sound Avenue, Town of Riverhead
Suffolk County, New York

CERTIFIED SURVEY

County Tax Map District 600 Section 07 Block 03 Lot 33.2

FIELD SURVEY COMPLETED	AUG. 20, 2014
MAP PREPARED	AUG. 21, 2014

Record of Revisions

RECORD OF REVISIONS	DATE
SPOT ELEVATIONS	SEPT. 03, 2014
GENERAL AMENDMENTS	SEPT. 30, 2014

40 0 20 40 80

Scale: 1" = 40'

JOB NO. 2014-0156
DWG. 2014_0156_certified

1 OF 1

PLOTTED BY: Diana Lopez PLOT DATE: Sep 30, 2014 – 12:17pm DWG FILE: R:\2014\2014_0156\dwg\2014_0156_certified.dwg

(1) UNAUTHORIZED ALTERATION OR ADDITION TO THIS SURVEY IS A VIOLATION OF SECTION 7209 OF THE NEW YORK STATE EDUCATION LAW. (2) DISTANCES SHOWN HEREON FROM PROPERTY LINES TO EXISTING STRUCTURES ARE FOR A SPECIFIC PURPOSE AND ARE NOT TO BE USED TO ESTABLISH PROPERTY LINES OR FOR ERECTION OF FENCES. (3) COPIES OF THIS SURVEY MAP NOT BEARING THE LAND SURVEYOR'S INKED SEAL OR EMBOSSED SEAL SHALL NOT BE CONSIDERED TO BE A VALID TRUE COPY. (4) CERTIFICATION INDICATED HEREON SHALL RUN ONLY TO THE PERSON FOR WHOM THE SURVEY IS PREPARED AND ON HIS BEHALF TO THE TITLE COMPANY, GOVERNMENTAL AGENCY AND LENDING INSTITUTION LISTED HEREON, AND TO THE ASSIGNEES OF THE LENDING INSTITUTION. CERTIFICATIONS ARE NOT TRANSFERABLE TO ADDITIONAL INSTITUTIONS OR SUBSEQUENT OWNERS. (5) THE LOCATION OF WELLS (W), SEPTIC TANKS (ST) & CESSPOOLS (CP) SHOWN HEREON ARE FROM FIELD OBSERVATIONS AND OR DATA OBTAINED FROM OTHERS.