


PROPERTY LOCATED IN BRIDGEHAMPTON
TOWN OF SOUTHAMPTON
SUFFOLK COUNTY, NEW YORK
AREA = 43,095 $\pm$
SCALE: 1" = 40'

FILED AUGUST 29, 1980; FILE NO 6930
TOWN OF SOUTHAMPTON
SUFFOLK COUNTY, NEW YORK
AREA = 43,095 $\pm$
SCALE: 1" = 40'

Unauthorized alteration or addition to this survey is a violation
of Section 7209 of the New York State Education Law.

Copies of this survey map not bearing the Land Surveyor's inked
seal or embossed seal shall not be considered to be a valid true
copy.

Guarantees or certifications indicated hereon shall run only to
the person for whom the survey is prepared, and on his behalf to
the title company, governmental agency and lending institution
listed hereon, and to the assignees of the lending institution.
Guarantees or certifications are not transferable to additional
institutions or subsequent owners.

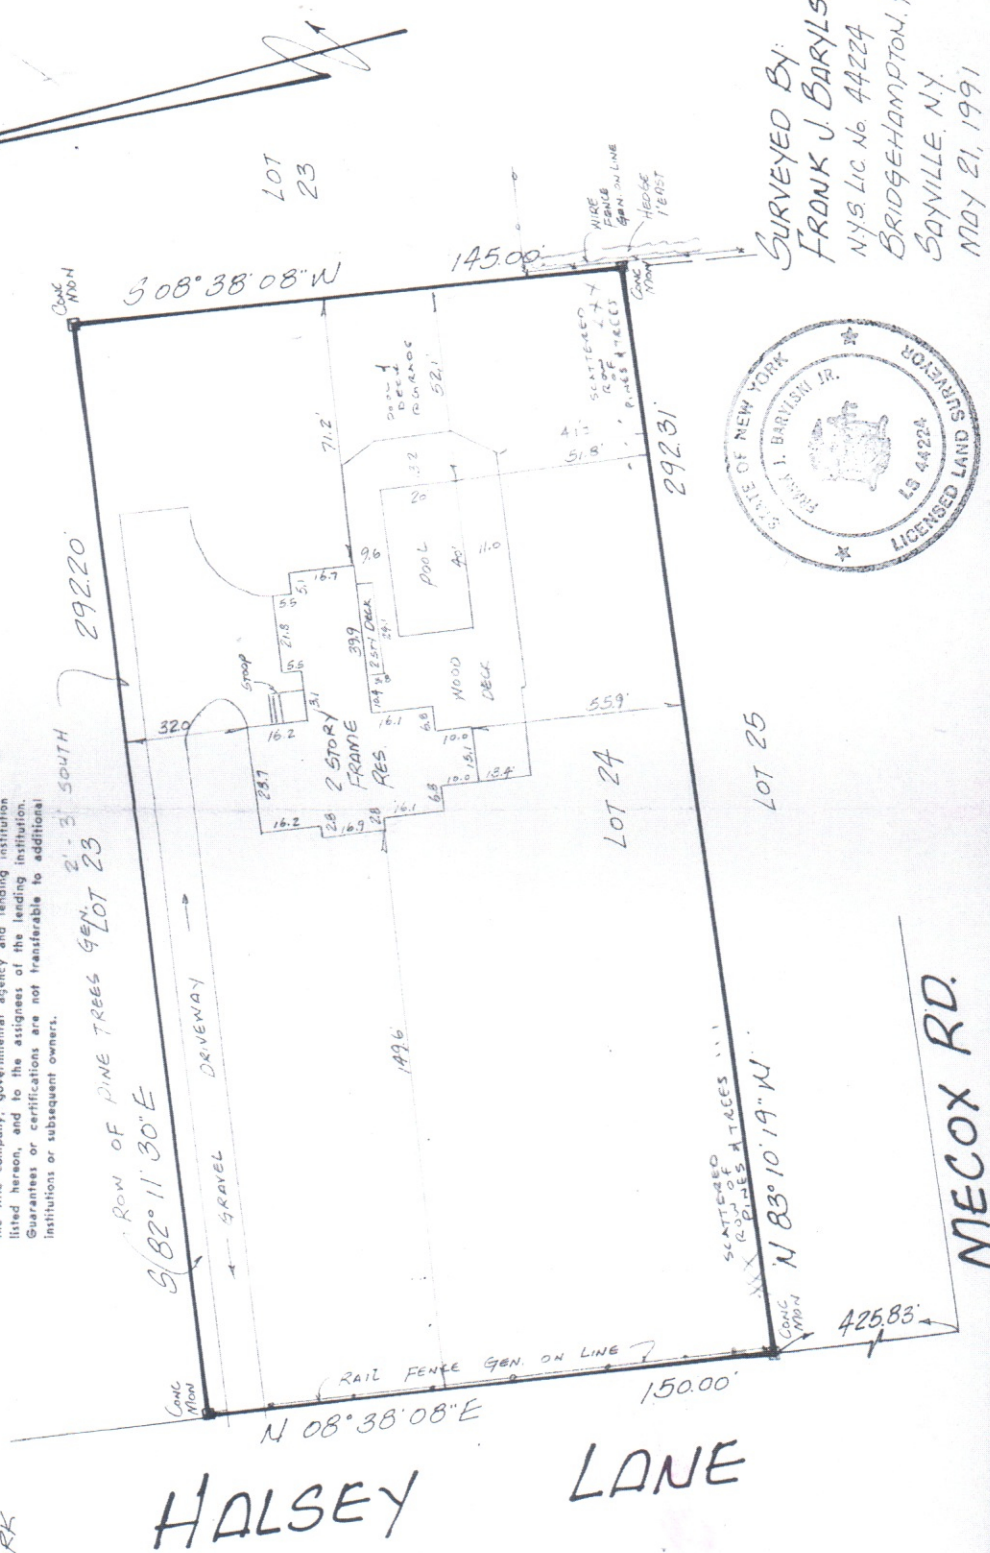

HALSEY LANE

CERTIFIED TO:
ROBERT & JOAN GEULA

L1 yB-1118

15277

SURVEYED BY:
FRANK J. BARYLSKI
NYS LIC. No. 44224
BRIDGEHAMPTON, N.Y.
MAY 21, 1991

