

Map of Property

Situate
Incorporated Village of East Hampton
Suffolk Co. N.Y.

Scale: 1" = 40'

Guaranteed to:

John M. Hartwell
The Title Guaranty Co. # T-1281-52
Chemical Bank of N.Y.

THE LOCATION OF CESSPOOLS, WELLS
AND OTHER UNDERGROUND INSTALL-
ATIONS, IF ANY, ARE SHOWN IN
ACCORDANCE WITH SOURCES BELIEVED
TO BE ACCURATE. HOWEVER, THIS
OFFICE DOES NOT ASSUME RESPONSIB-
ILITY FOR THEIR ACCURACY.



Charles R. Kline

Revised: August 1, 1984-Final Gar.-Deck

Revised November 7, 1983 (Prop. Gar.)

Redated May 6, 1982-New Add'n.

Surveyed Jan 27, 1981


George H. Walbridge Co.
Land Surveyors & Land Planners
East Hampton N.Y.

Apauogue Road

THE existence of right of ways
and/or easements of record,
if any not shown, are not
guaranteed

■ Indicates Set Conc. Mon.

Apauogue Road

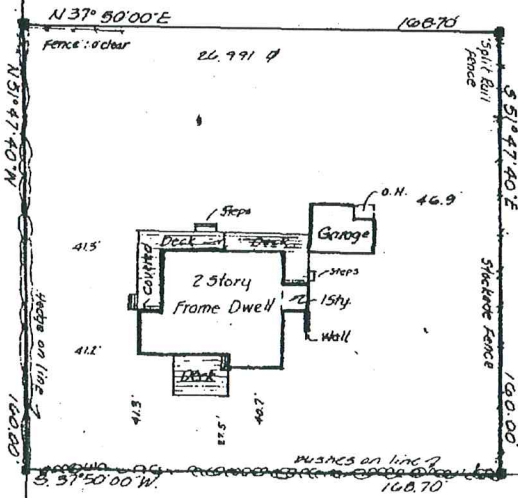

N.Y. of Dennis C. & Barbara Hannon

N.Y. of John M. Hartwell

TOW Map no 0301-015-02-p10344