

SURVEY OF LOT 3 MAP OF TIFFANY FARMS SITUATE AT BRIDGEHAMPTON


TOWN OF SOUTHAMPTON
SUFFOLK COUNTY, NEW YORK
S.C.T.M. DIST. 0900 SEC. 050 BLK. 01 LOT 4.3

20 10 0 20 40 60 80 100 120
SCALE: 1" = 40' DATE: AUGUST 23, 2001

ELEVATIONS IN ASSUMED DATUM
NO SURFACE WATER EVIDENT WITHIN 300'
AREA SERVICED BY PUBLIC WATER
LOT AREA: 40,001 SQ. FT. = 0.92 ACRE

AGRICULTURAL
RESERVE

MITCHELL LANE

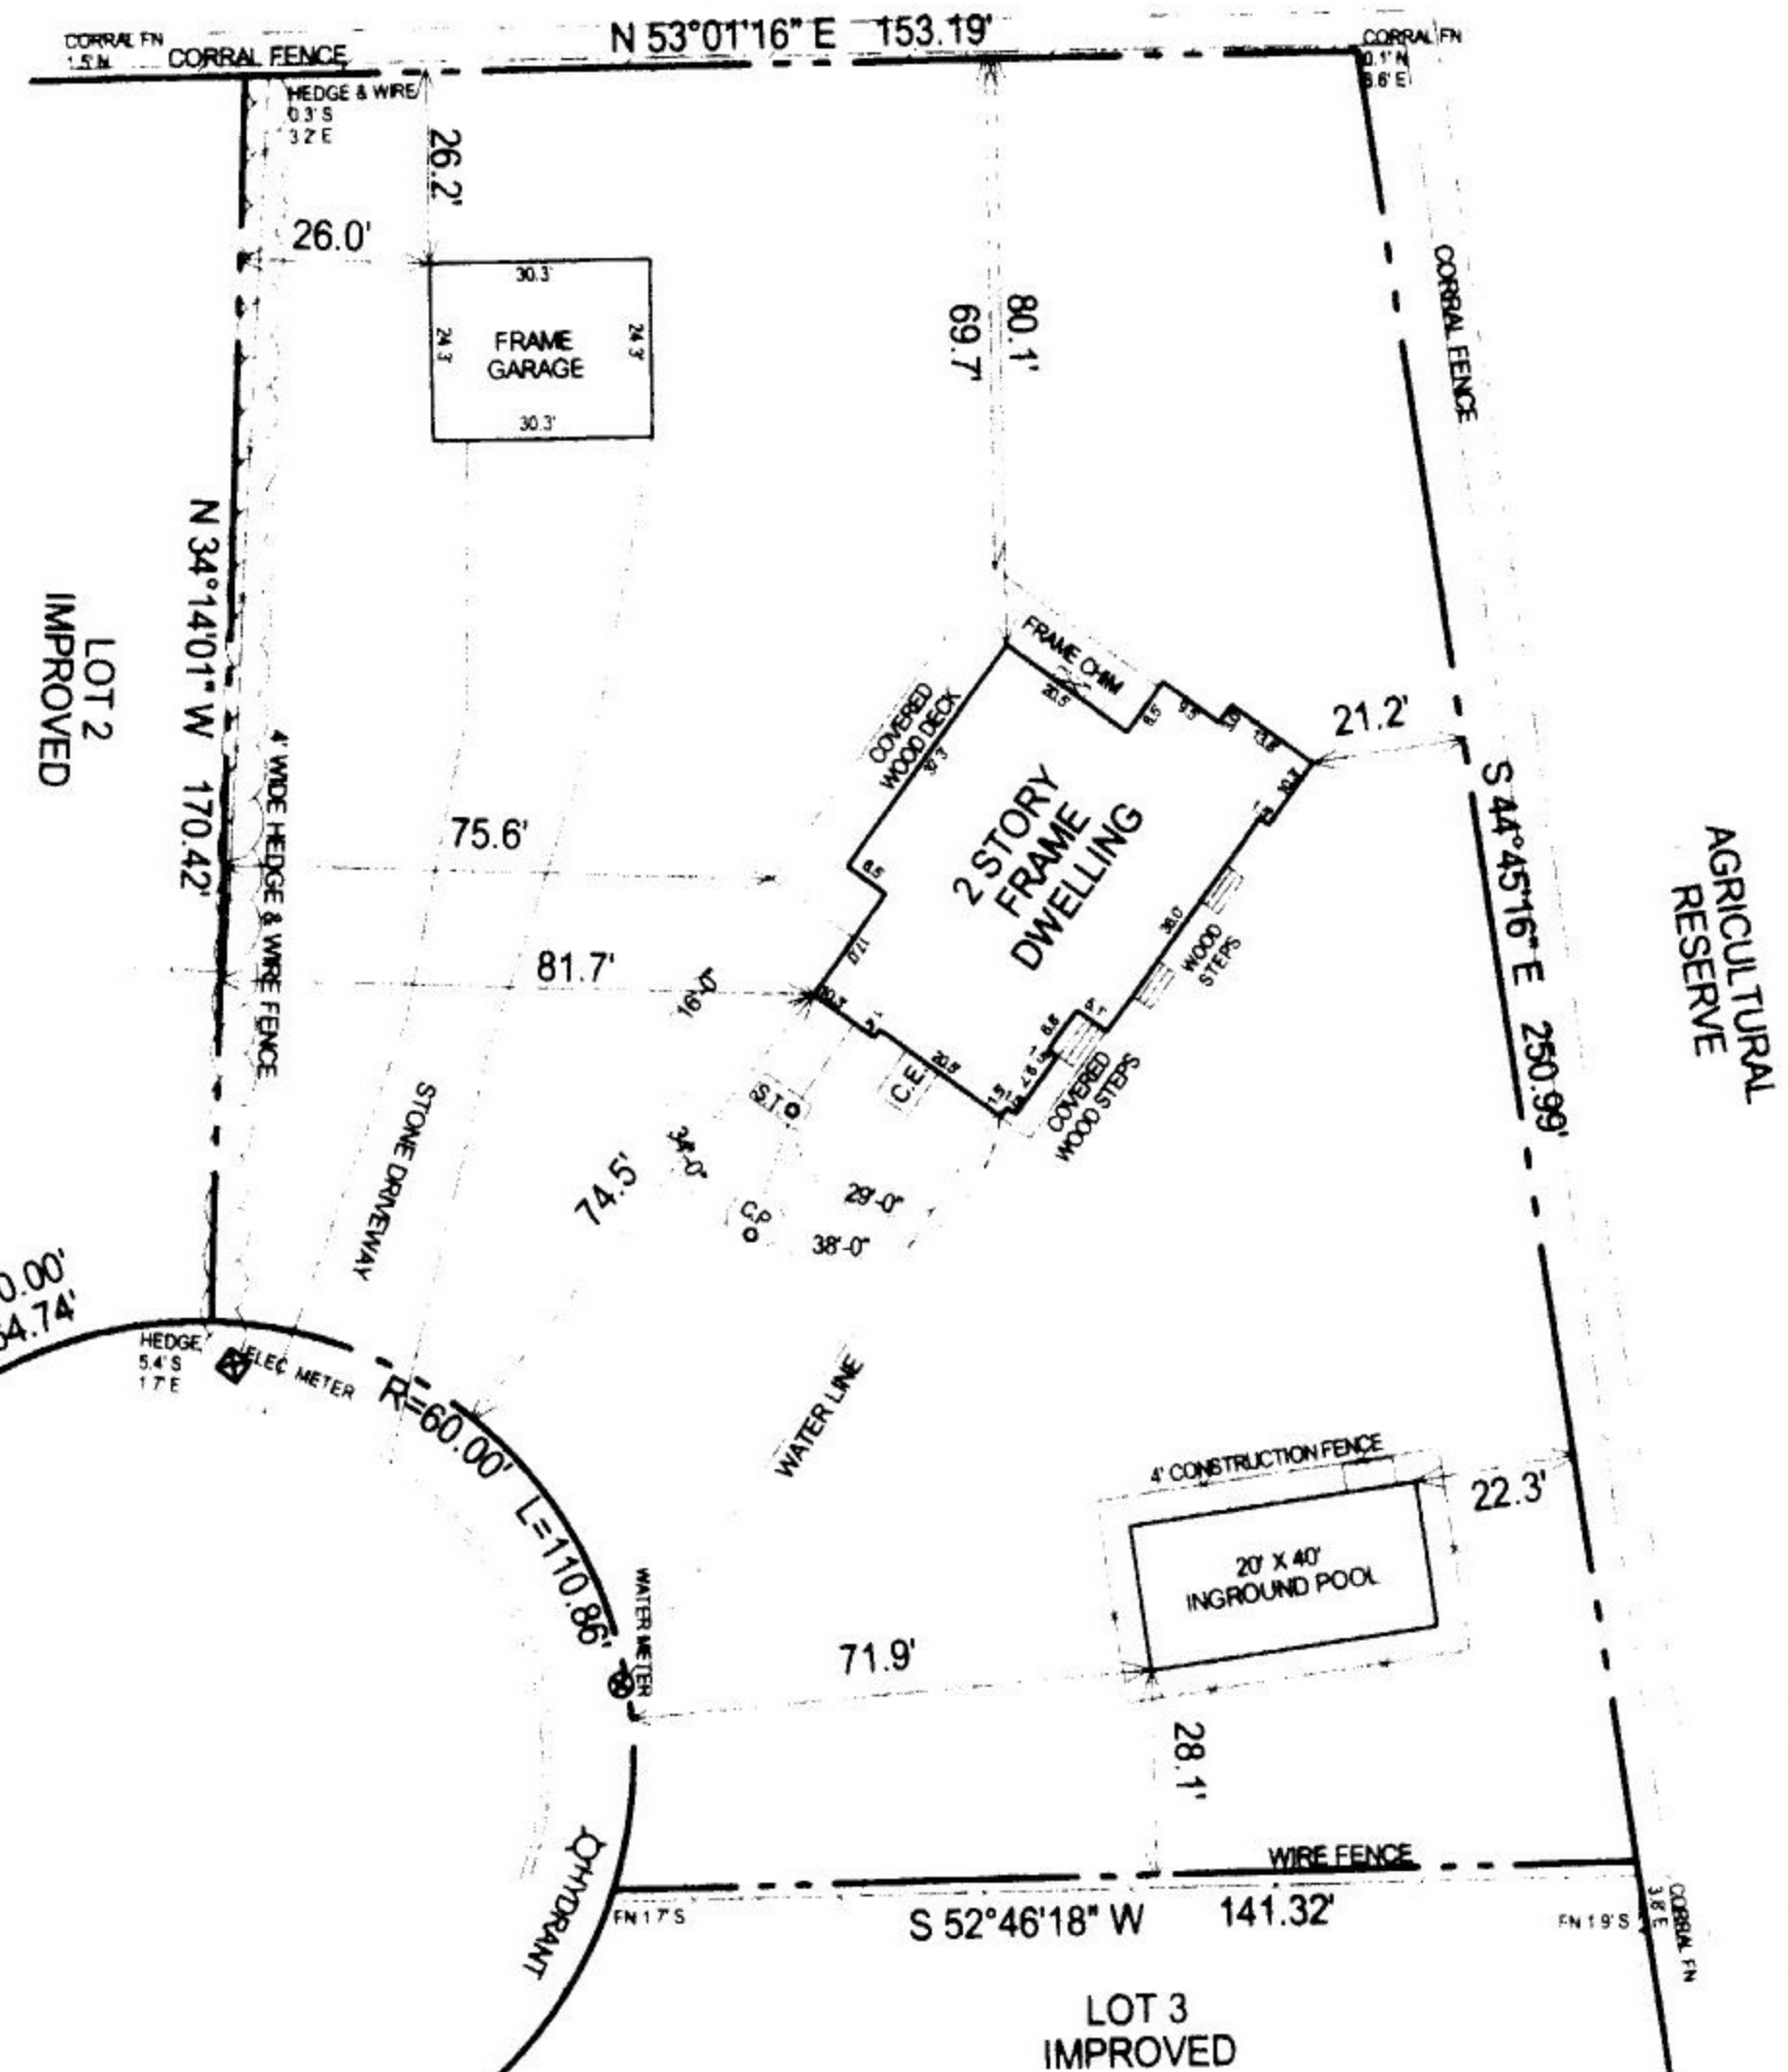

TIFFANY WAY

HANDS ON SURVEYING

46 NORTH ROAD
HAMPTON BAYS, NEW YORK
11946
TEL / FAX: (631)-723-1954
MARTIN D. HAND L.S.

JOB NO. 2001-307
MAP NO. 8045
FILED: JANUARY 8, 1988
REVISIONS:
REV. PROP. HSE.
10/18/01
FINAL 3/29/02

