



SURVEY OF PROPERTY  
PROPERTY LOCATED AT BRIDGEHAMPTON  
LOT No. 5  
MAP OF TWO TREES FARM  
FILED: OCTOBER 8, 2013; FILE No. 11930  
TOWN OF SOUTHAMPTON  
SUFFOLK COUNTY, NEW YORK  
S.C.T.M. # 900-083-01-01.5  
AREA = 86,066 SF. = 1.9759 ACRES

NOTE: THE EXISTENCE OF RIGHT OF WAYS,  
WETLANDS AND/OR EASEMENTS OF RECORD  
IF ANY, NOT SHOWN ARE NOT GUARANTEED.

PROPERTY ZONED: CR-80  
AGRICULTURAL PROTECTION OVERLAY DISTRICT  
AQUIFER PROTECTION OVERLAY DISTRICT

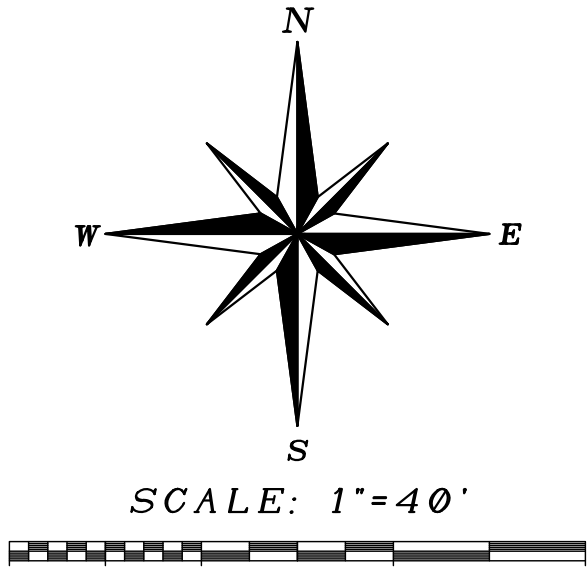

HAYGROUND ROAD

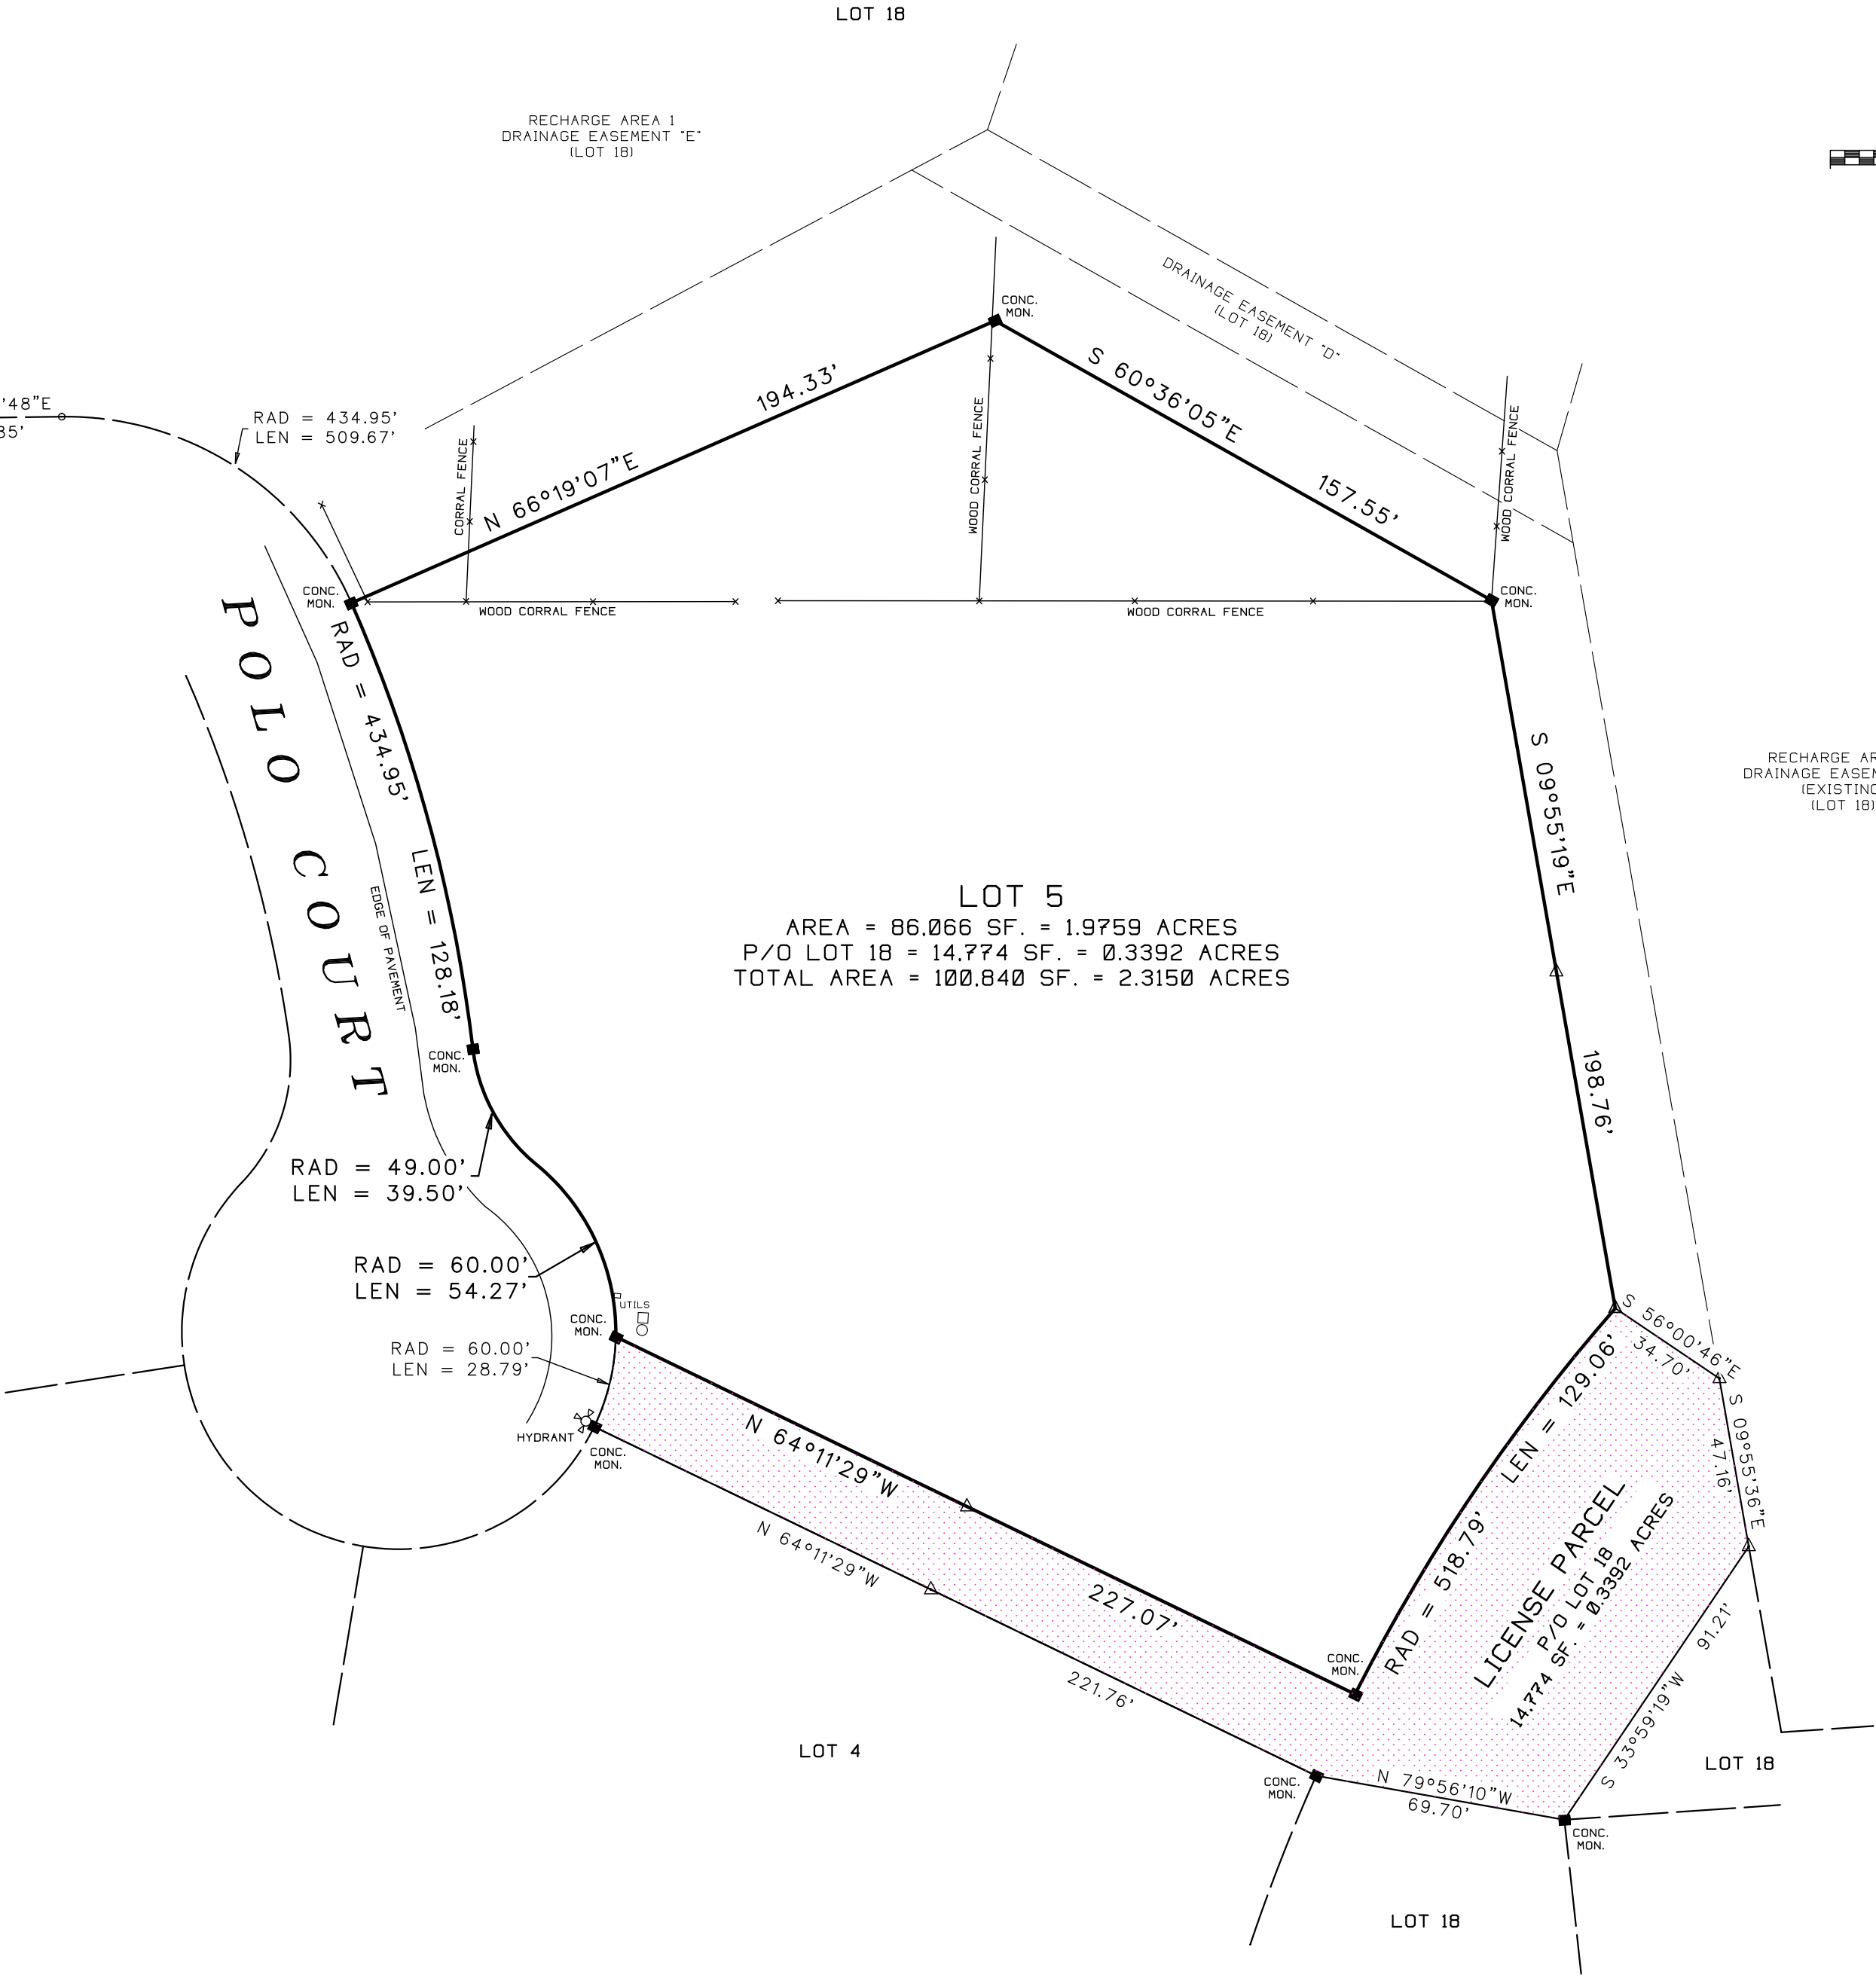

UNAUTHORIZED ALTERATION OR ADDITION TO THIS SURVEY IS A VIOLATION  
OF SECTION 7209 OF THE NEW YORK STATE EDUCATION LAW.

COPIES OF THIS SURVEY MAP NOT BEARING THE LAND SURVEYORS INKED  
OR EMBOSSED SEAL SHALL NOT BE CONSIDERED TO BE A VALID TRUE COPY.

GUARANTEES OR CERTIFICATIONS INDICATED HEREON SHALL RUN ONLY TO  
THE PERSON FOR WHOM THE SURVEY IS PREPARED, AND ON HIS BEHALF TO  
THE TITLE COMPANY, GOVERNMENTAL AGENCY AND LENDING INSTITUTION  
LISTED HEREON, AND TO THE ASSIGNEES OF THE LENDING INSTITUTION.  
GUARANTEES OR CERTIFICATIONS ARE NOT TRANSFERABLE TO ADDITIONAL  
INSTITUTIONS OR SUBSEQUENT OWNERS.

SURVEYED BY:  
STEVEN BARYLSKI  
N.Y.S. Lic. No. 050453  
P.O. BOX 6005  
SOUTHAMPTON, N.Y. 11969  
DECEMBER 4, 2014

PHONE: 631-283-4525 FAX: 631-283-4784  
STEVEN@SBLSPC.COM