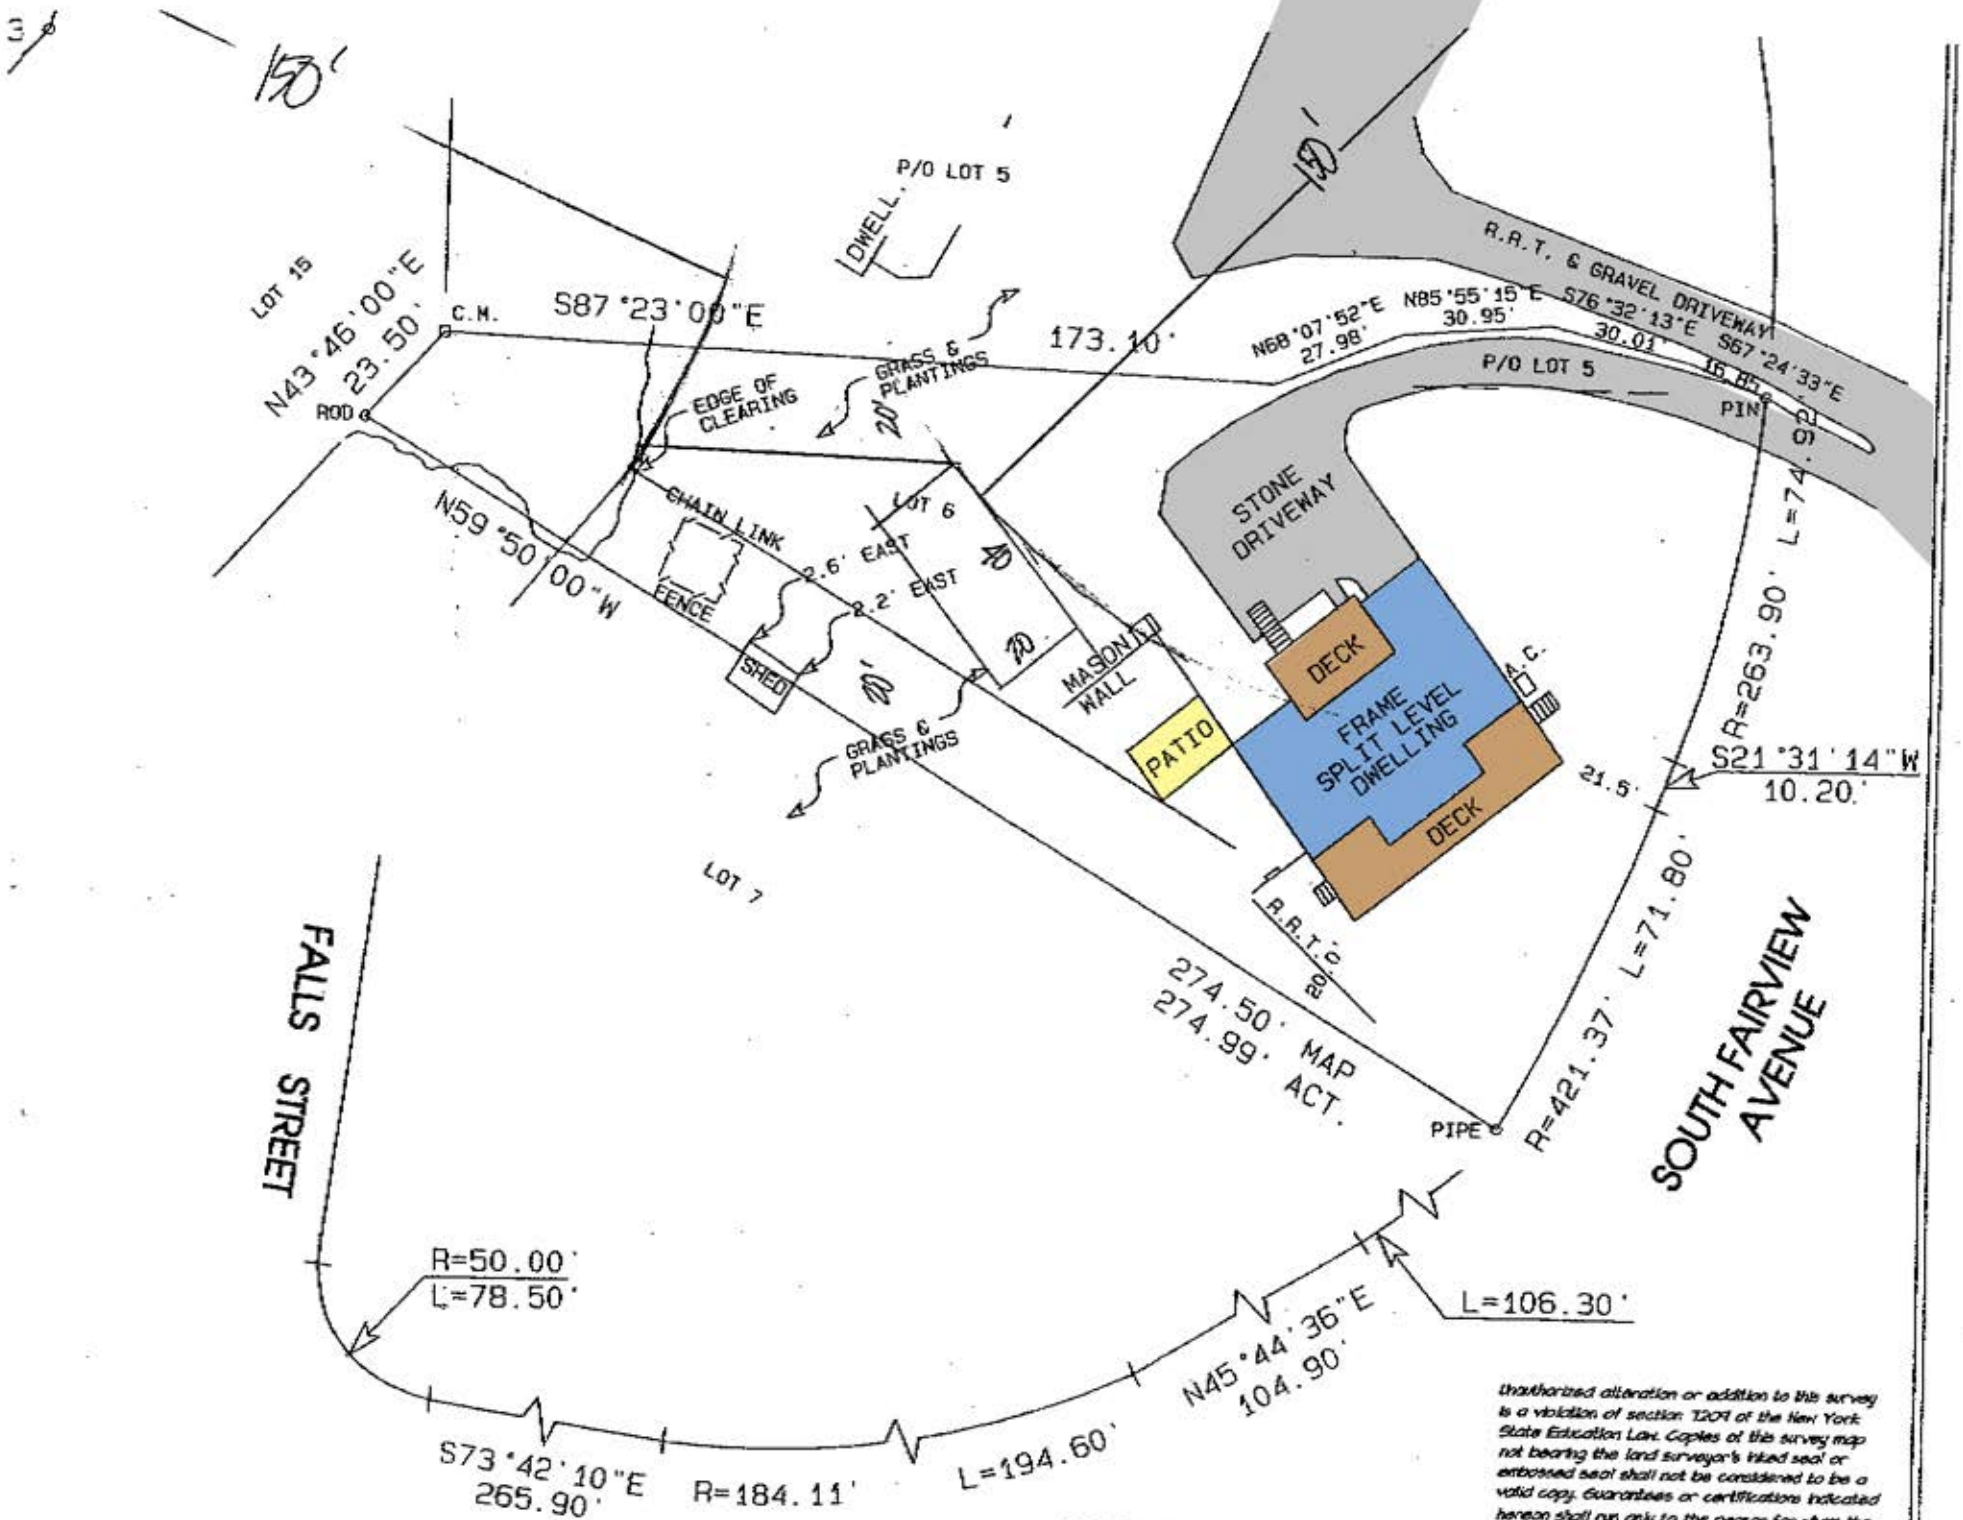

EASEMENTS, RIGHT OF WAYS, UNDERGROUND UTILITIES, WETLANDS, AND OR SANITARY FACILITIES NOT VISIBLE AT THE TIME OF SURVEY HAVE NOT BEEN SHOWN, LOCATED AND/OR GUARANTEED

Unauthorized alteration or addition to this survey is a violation of section 7209 of the New York State Education Law. Copies of this survey map not bearing the land surveyor's inked seal or embossed seal shall not be considered to be a valid copy. Guarantees or certifications indicated hereon shall run only to the person for whom the survey is prepared and on his behalf to the title company, government agency and lending institution. Guarantees or certifications are not transferable to additional institutions or subsequent owners.