
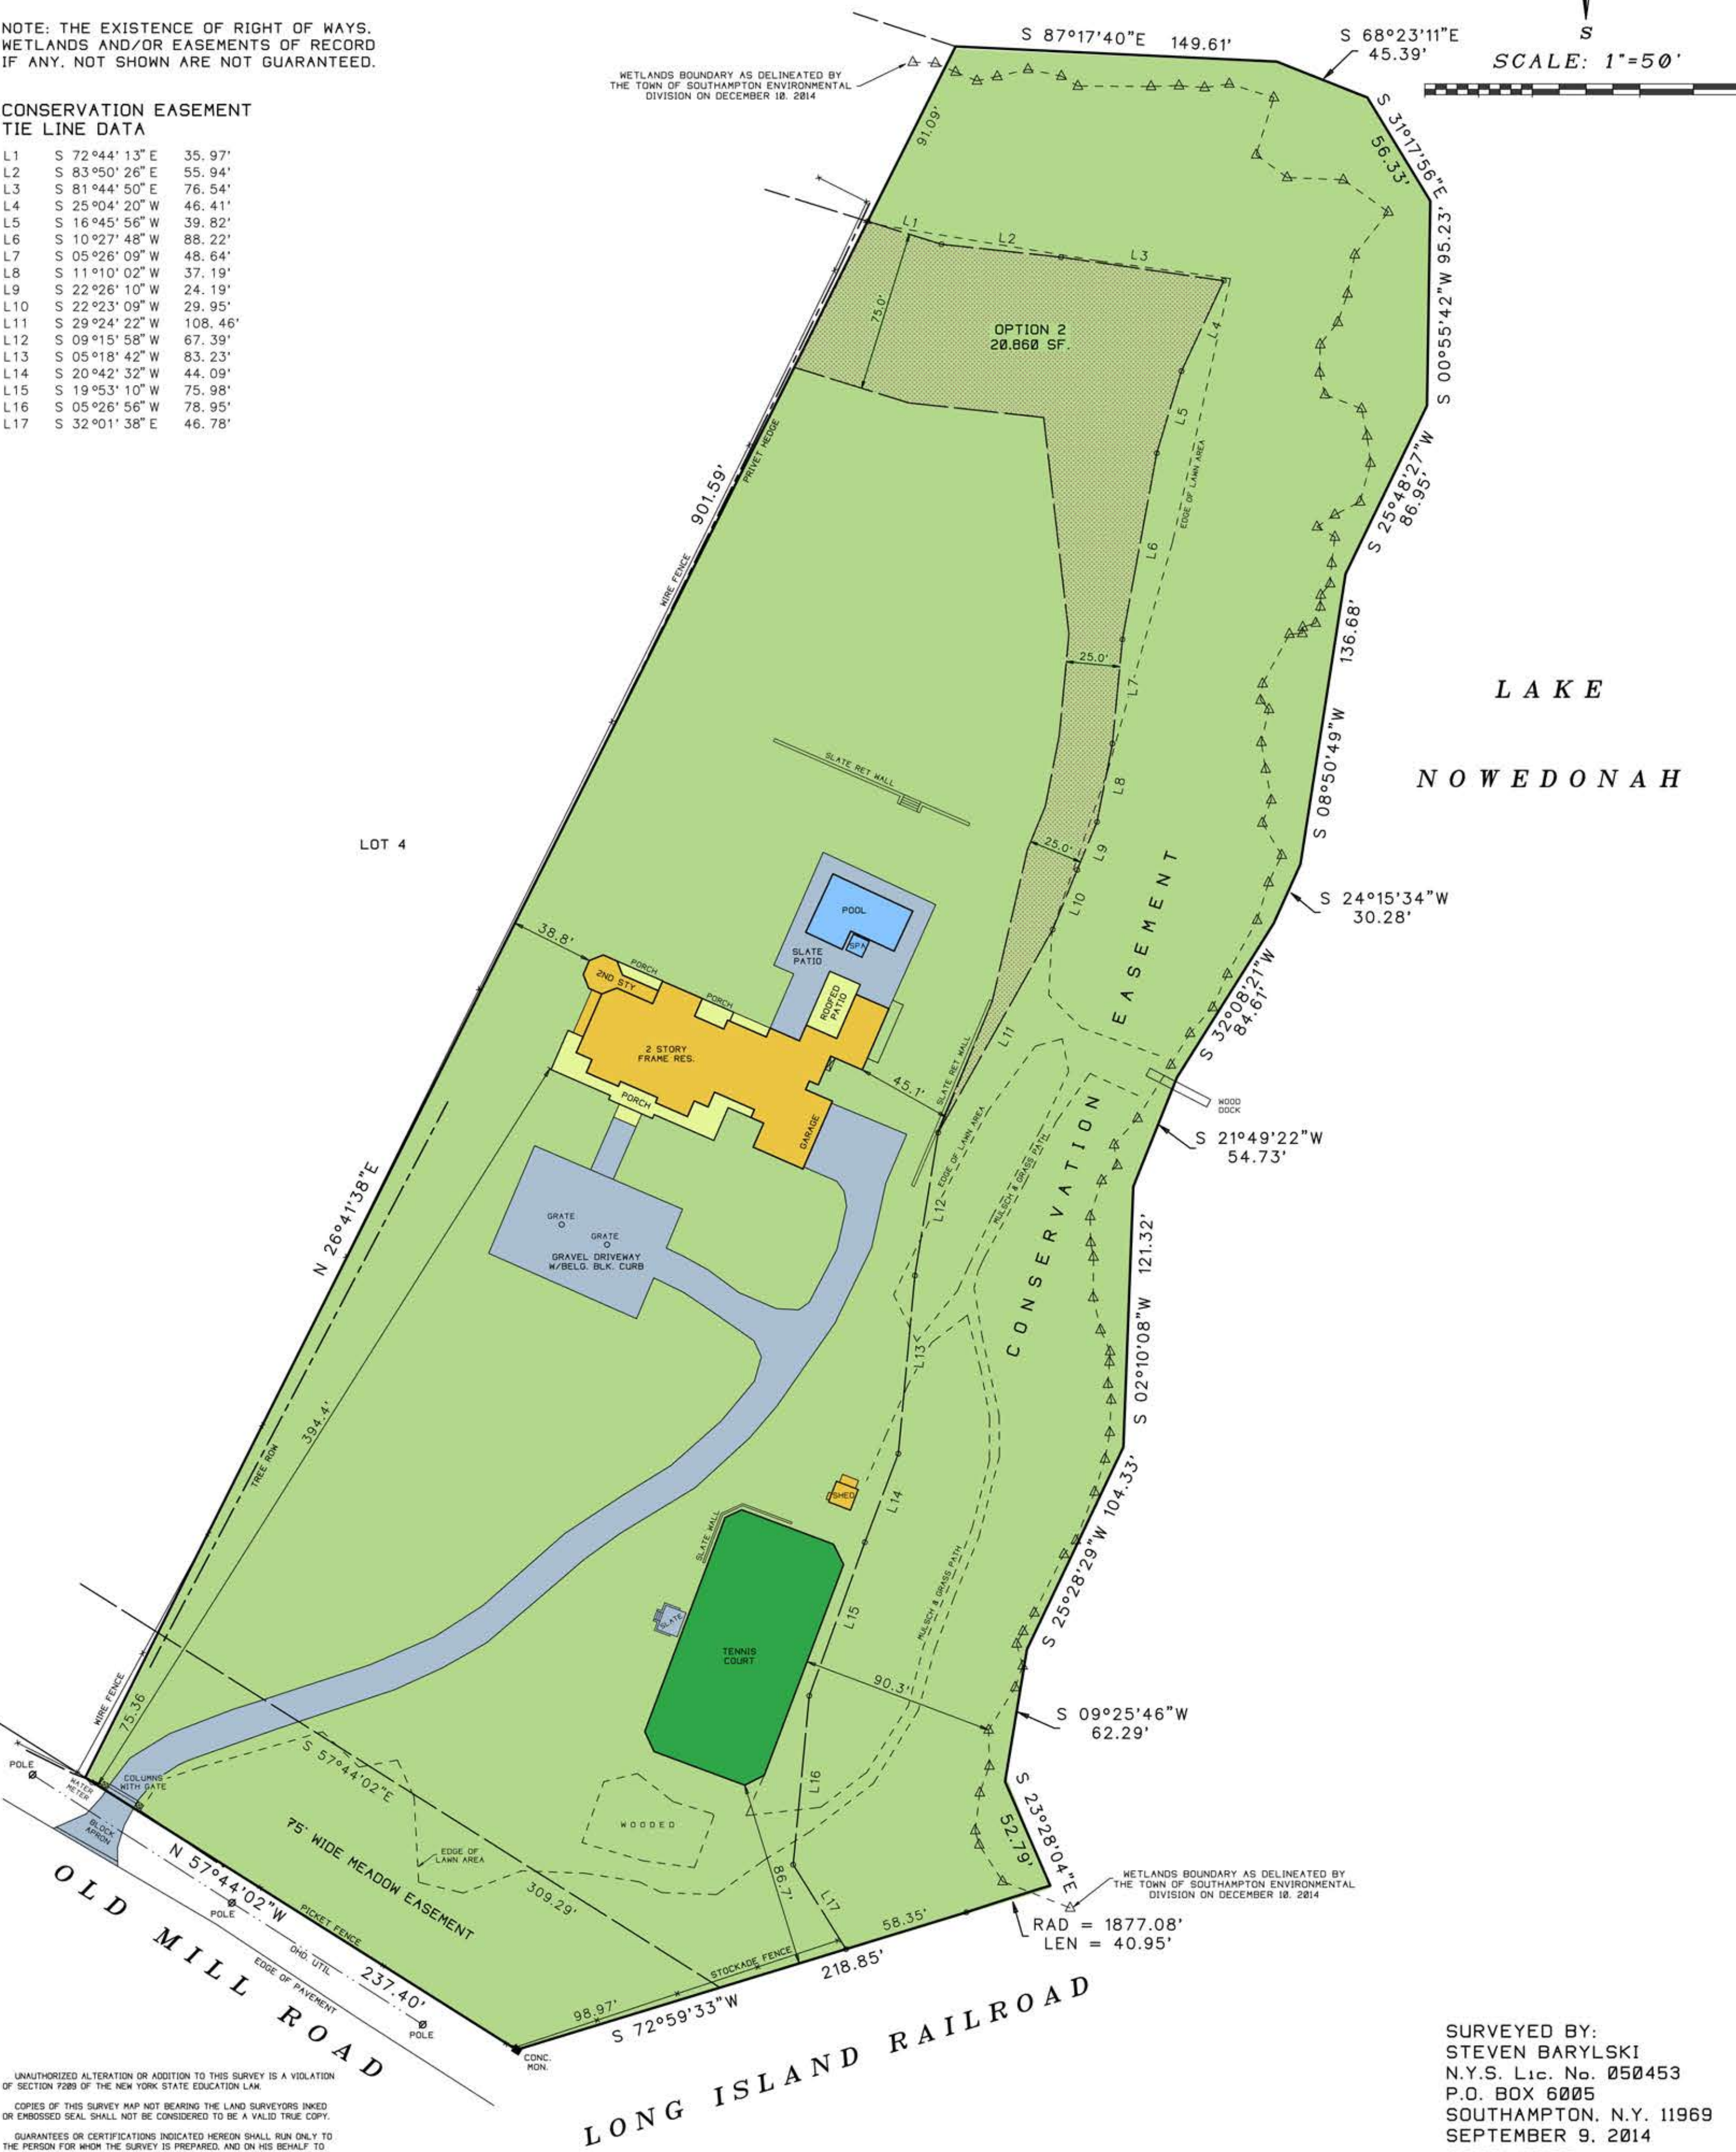


SURVEY OF PROPERTY
PROPERTY LOCATED AT WATER MILL
LOT No. 5
MAP OF TARA HAMPTON, INC.
FILED: FEBRUARY 10, 2000; FILE No. 10397
TOWN OF SOUTHAMPTON
SUFFOLK COUNTY, NEW YORK
S.C.T.M. # 900-114-01-25.6
AREA = 305.017 SF = 7.0022 ACRES

NOTE: THE EXISTENCE OF RIGHT OF WAYS,
WETLANDS AND/OR EASEMENTS OF RECORD
IF ANY, NOT SHOWN ARE NOT GUARANTEED.

CONSERVATION EASEMENT
TIE LINE DATA

L1	S 72°44' 13" E	35.97'
L2	S 83°50' 26" E	55.94'
L3	S 81°44' 50" E	76.54'
L4	S 25°04' 20" W	46.41'
L5	S 16°45' 56" W	39.82'
L6	S 10°27' 48" W	88.22'
L7	S 05°26' 09" W	48.64'
L8	S 11°10' 02" W	37.19'
L9	S 22°26' 10" W	24.19'
L10	S 22°23' 09" W	29.95'
L11	S 29°24' 22" W	108.46'
L12	S 09°15' 58" W	67.39'
L13	S 05°18' 42" W	83.23'
L14	S 20°42' 32" W	44.09'
L15	S 19°53' 10" W	75.98'
L16	S 05°26' 56" W	78.95'
L17	S 32°01' 38" E	46.78'

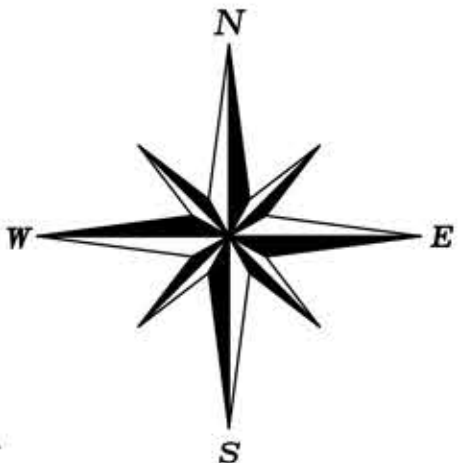

UNAUTHORIZED ALTERATION OR ADDITION TO THIS SURVEY IS A VIOLATION
OF SECTION 7209 OF THE NEW YORK STATE EDUCATION LAW.
COPIES OF THIS SURVEY MAP NOT BEARING THE LAND SURVEYORS INKED
OR EMBOSSED SEAL SHALL NOT BE CONSIDERED TO BE A VALID TRUE COPY.
GUARANTEES OR CERTIFICATIONS INDICATED HEREON SHALL RUN ONLY TO
THE PERSON FOR WHOM THE SURVEY IS PREPARED, AND ON HIS BEHALF TO
THE TITLE COMPANY, GOVERNMENTAL AGENCY AND LENDING INSTITUTION
LISTED HEREON, AND TO THE ASSIGNEES OF THE LENDING INSTITUTION.
GUARANTEES OR CERTIFICATIONS ARE NOT TRANSFERABLE TO ADDITIONAL
INSTITUTIONS OR SUBSEQUENT OWNERS.

SURVEYED BY:
STEVEN BARYLSKI
N.Y.S. Lic. No. 050453
P.O. BOX 6005
SOUTHAMPTON, N.Y. 11969
SEPTEMBER 9, 2014
9-9-2014: UPDATE
12-22-2014: LOCATE WETLANDS
6-2-2015: PROPOSED ADD. EASEMENT
PHONE: 631-283-4525 FAX: 631-283-4784
STEVEN@SBLSPC.COM